


Parcel
 B.M. 17913 Iron Riv. cor Pinecrest & 1st
 176.86 Wood 2nd W. Pinecrest

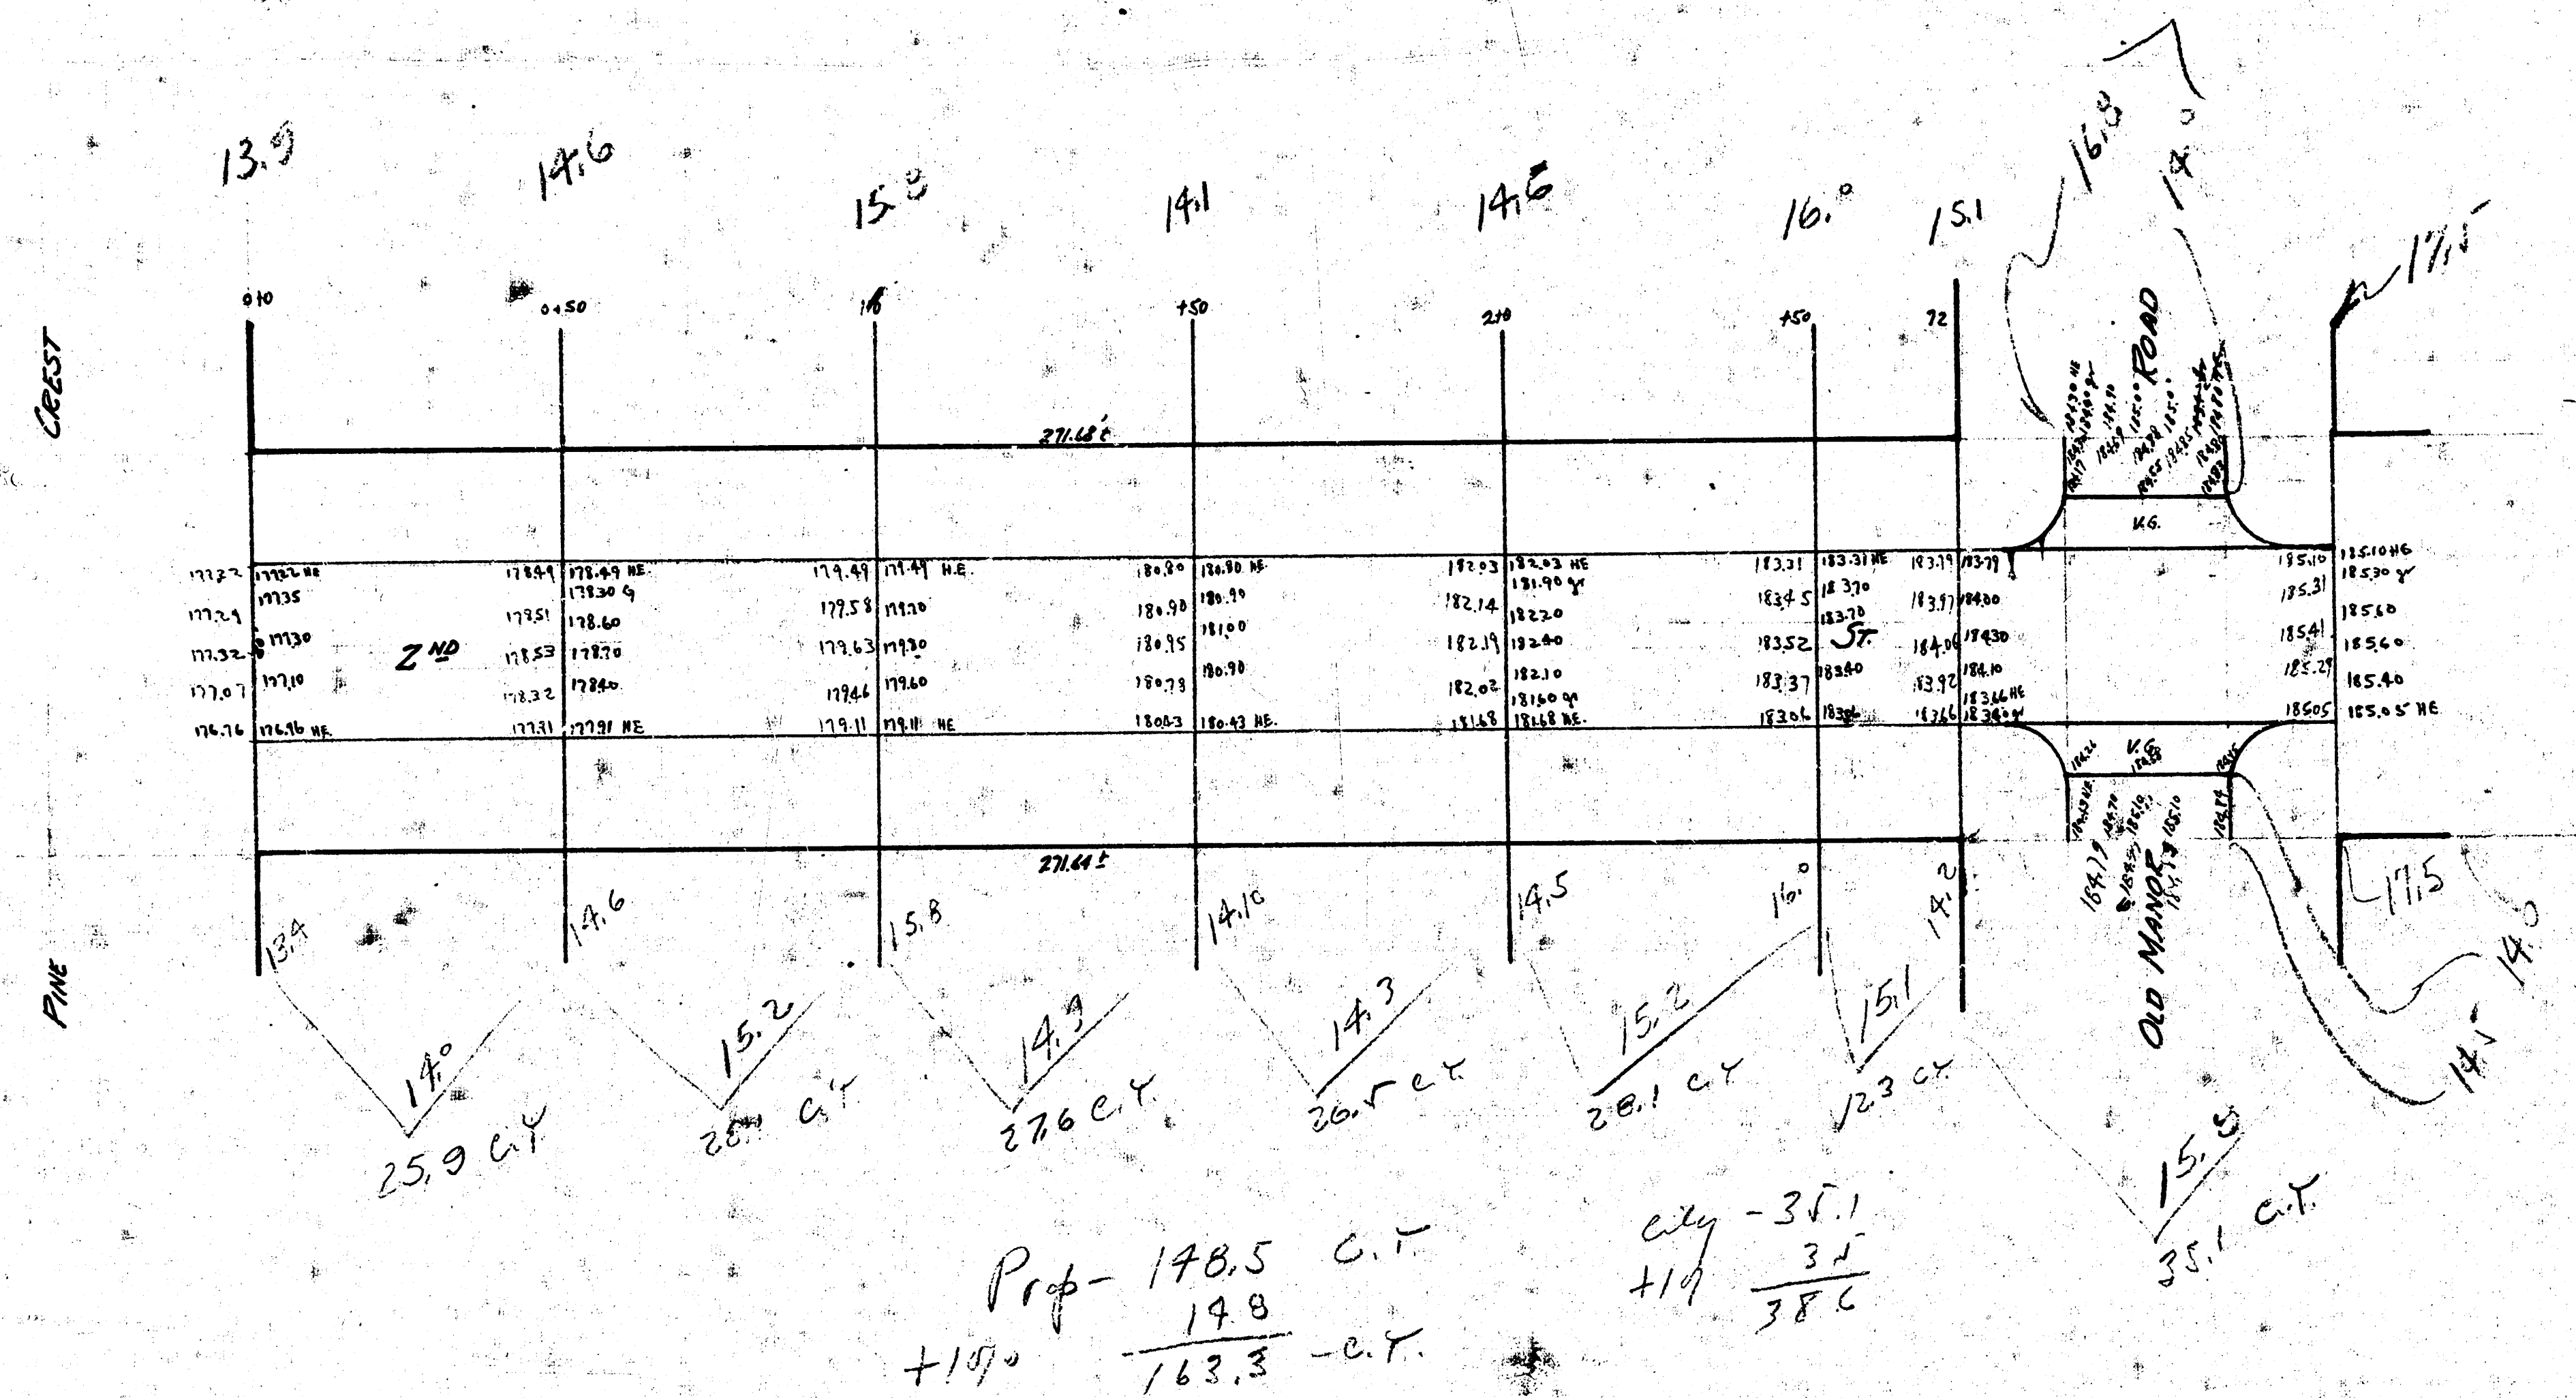

Survey Plan
 17913
 2nd St.
 6th Pinecrest
 6th Outflow