


PAVING PLAN
 1942
 Second St
 E.L. Ridgewood
 to W.L. Edgemoor

1942
 Second St - E.L. Ridgewood to W.L. Edgemoor
 30' Conc. - Int. Cb.

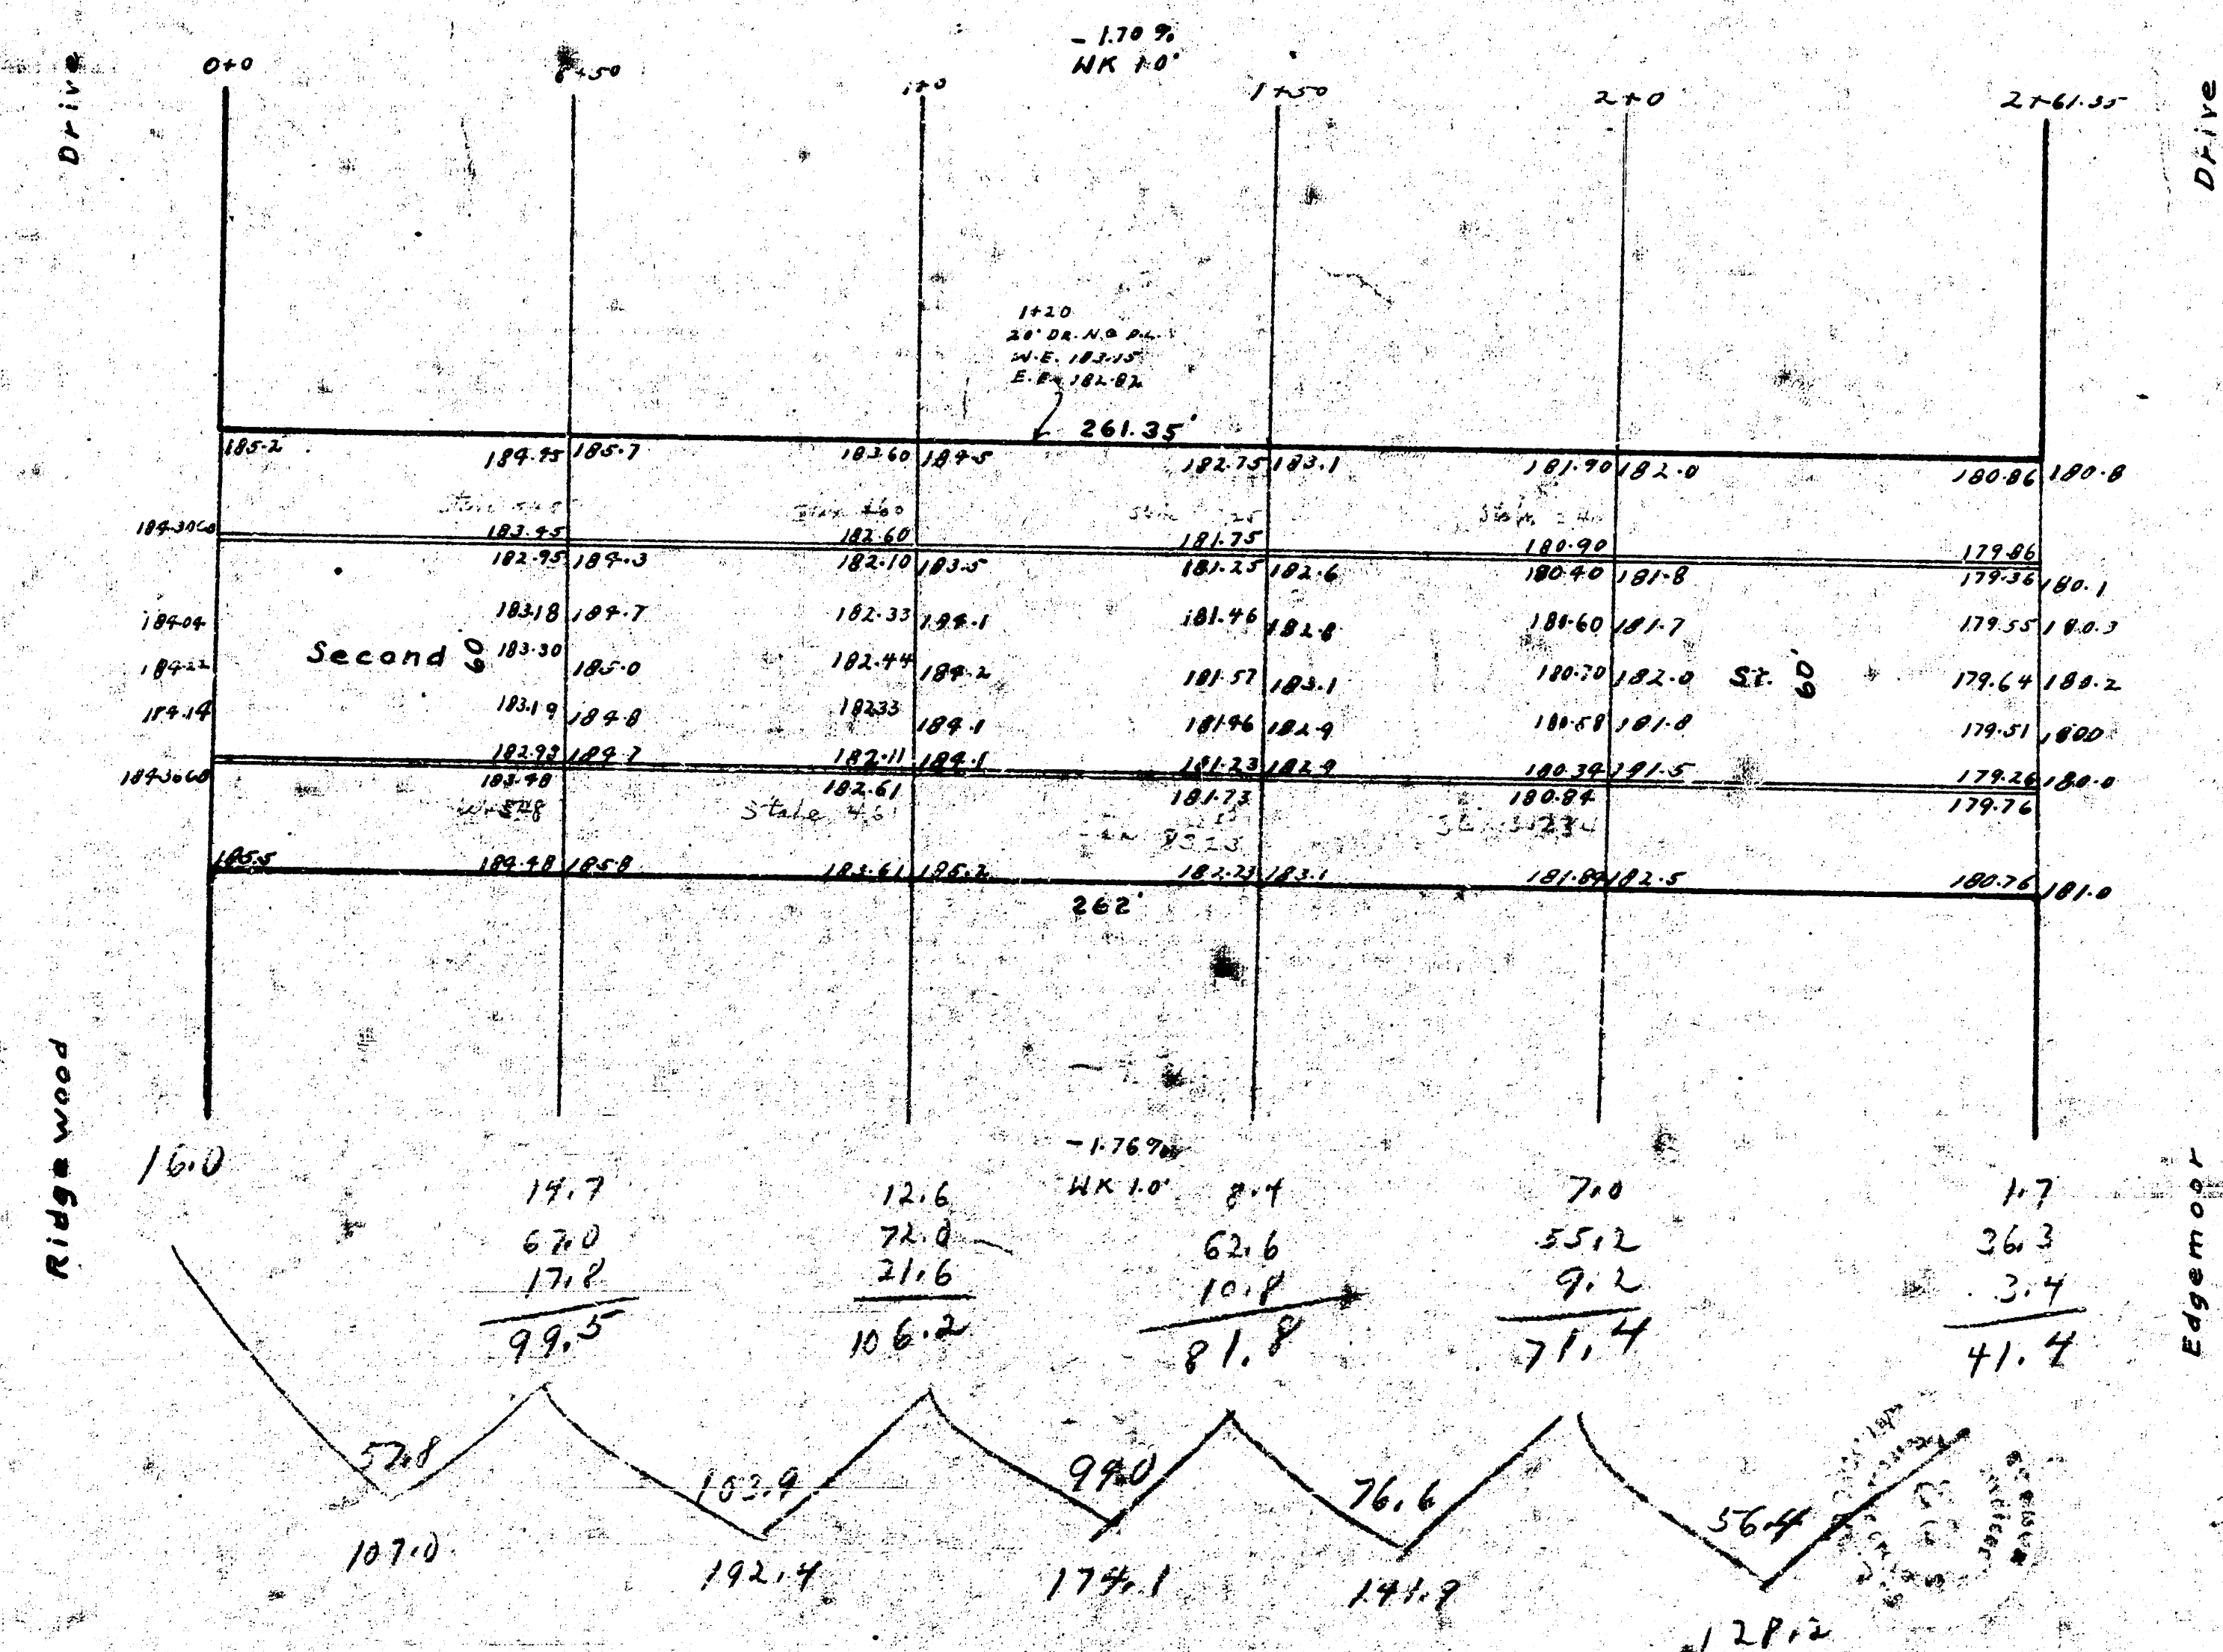

107.0
 172.4
 174.1
 129.2
 743.6
 74.4
 818.0

B.M. 179.41 "G" IN GLOBE W. L. Edgemoor S.L. 2nd