



BM. 11088 "Gin Globe Top" ab. E end radius NW cor. Elizabeth & 3rd.

Scale 1"=20'

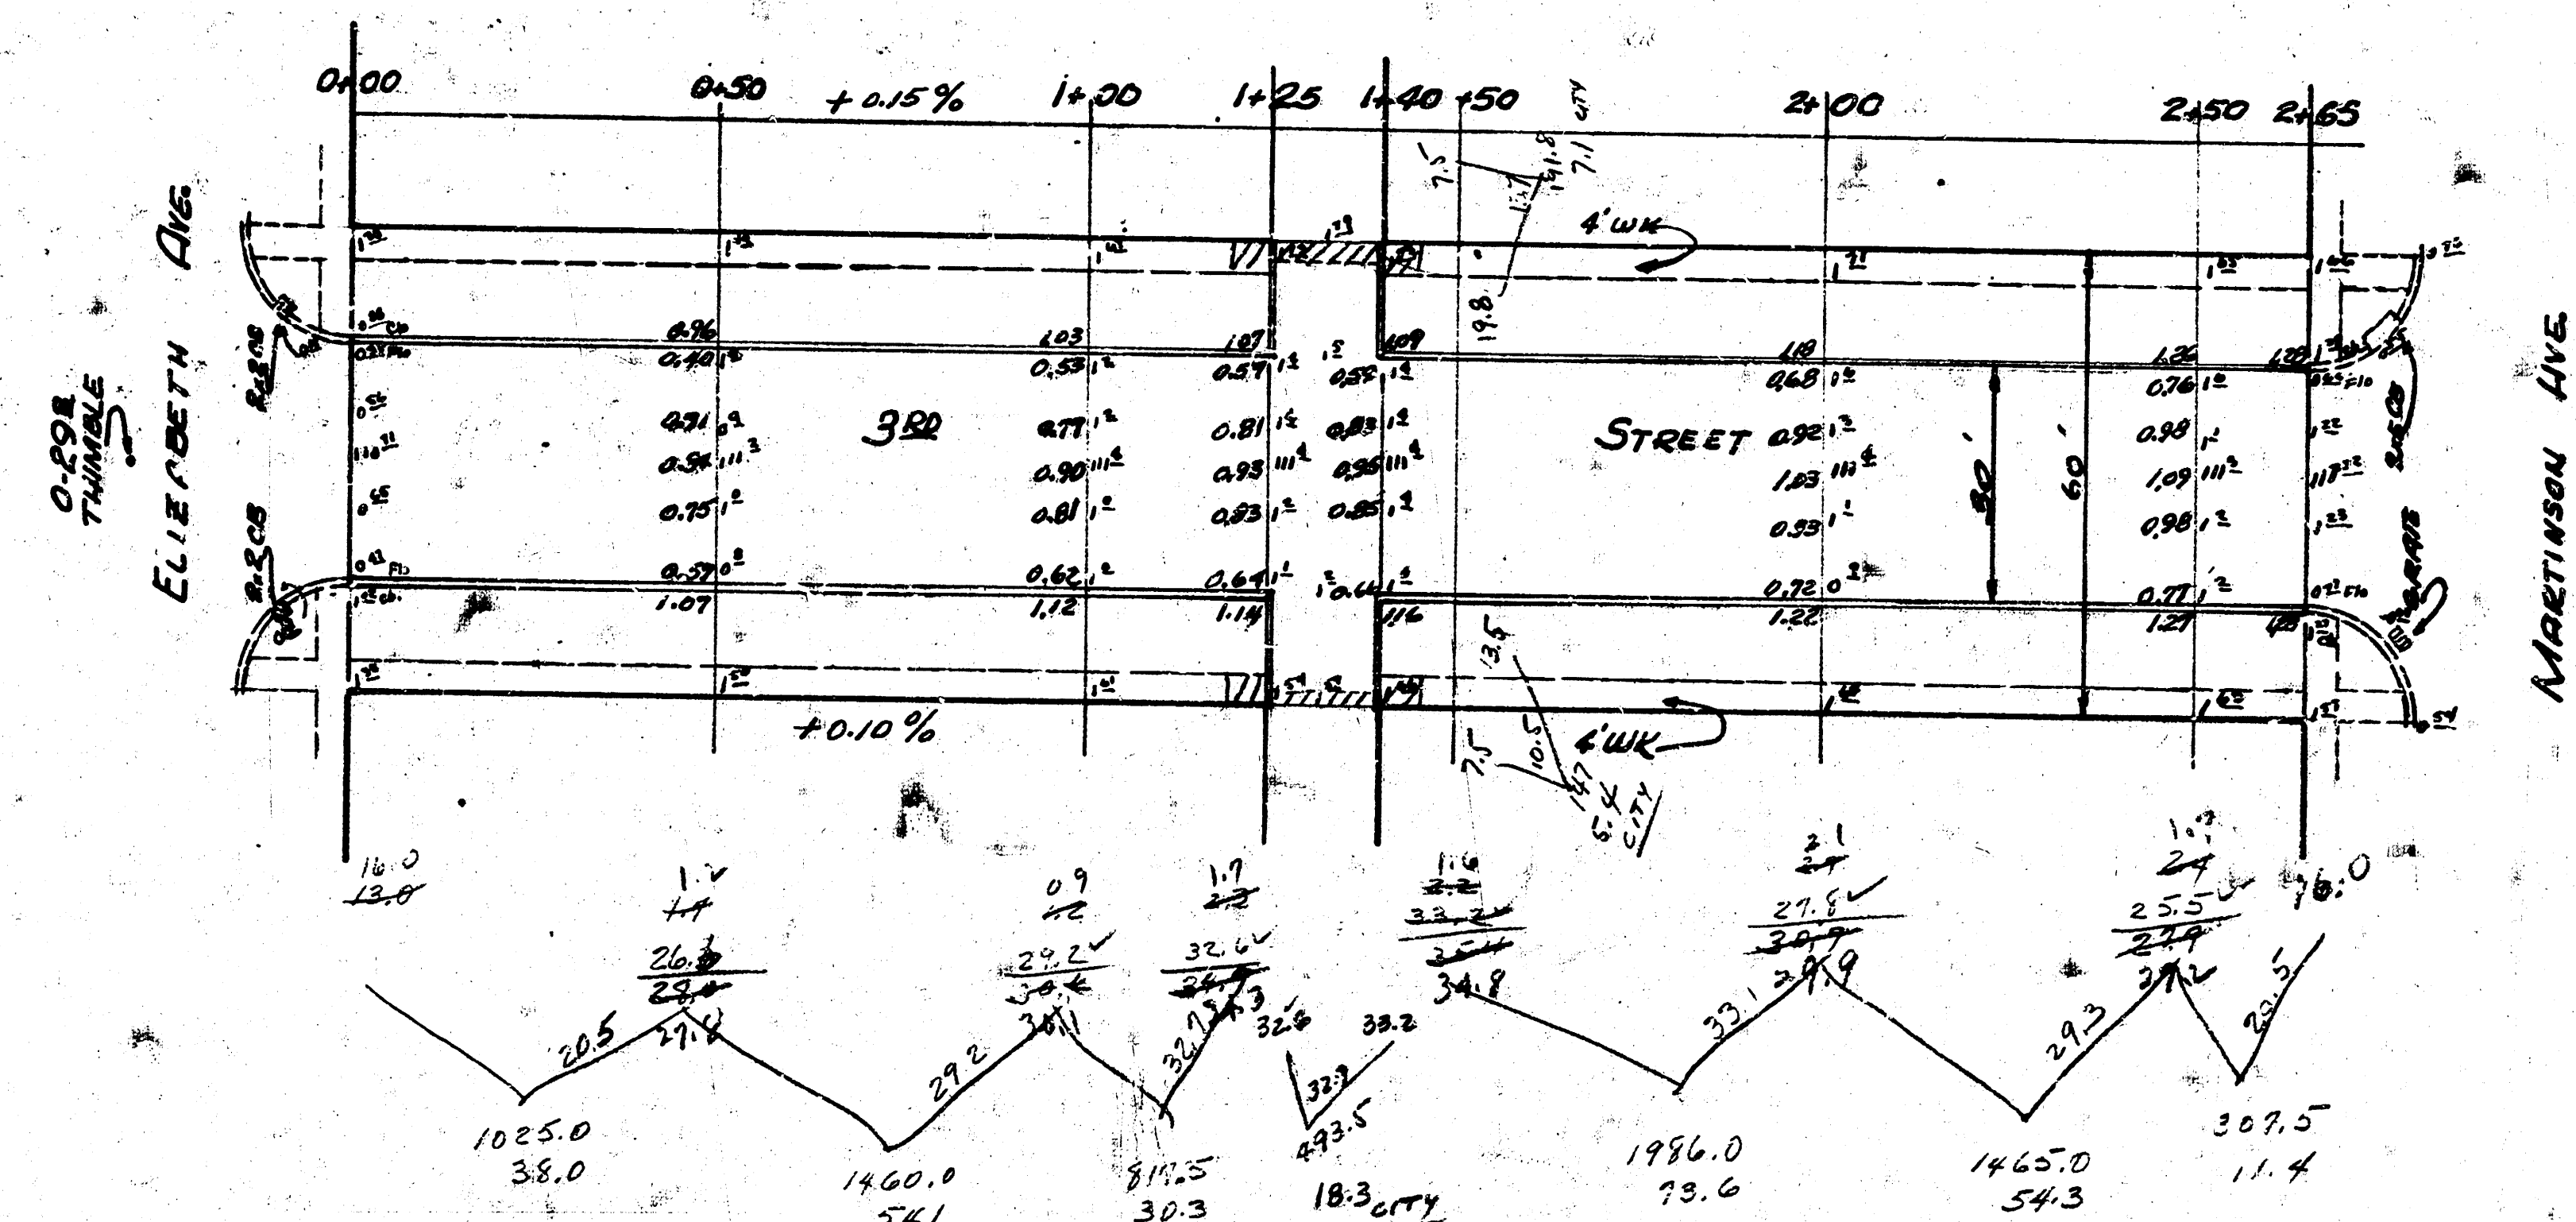

P.P. EIC.	C.H. EIC.
38.0	30.8
54.1	+10% 3.1
30.3	
73.6	33.9 Cu yd
54.3	
11.4	
261.7	
26.2	+10%
287.9	Cu yd

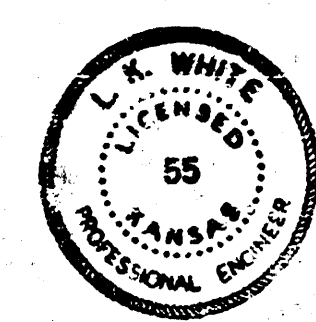

3RD STREET
EL. ELIZABETH TO W. MARTINSON
30' CONC. & CB
CITY OF WICHITA, KANSAS
L.K. WHITE CITY ENGINEER
Jan. 15, 1952 Proj. No. C11-221