
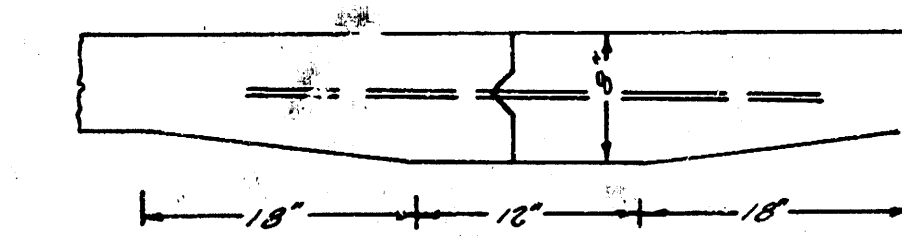



Survey A-1005 Bk J.A.K. 8
Plan D.E.C.
Exc D.E.C.
Checked H.

Excav.		Grand Total Excan	
Prop	City	Prop	City
1146.1	0	1146.1	0
1308.5		1308.5	
2550.6		2550.6	
+ 10%		280.6	
Total		2750.2	

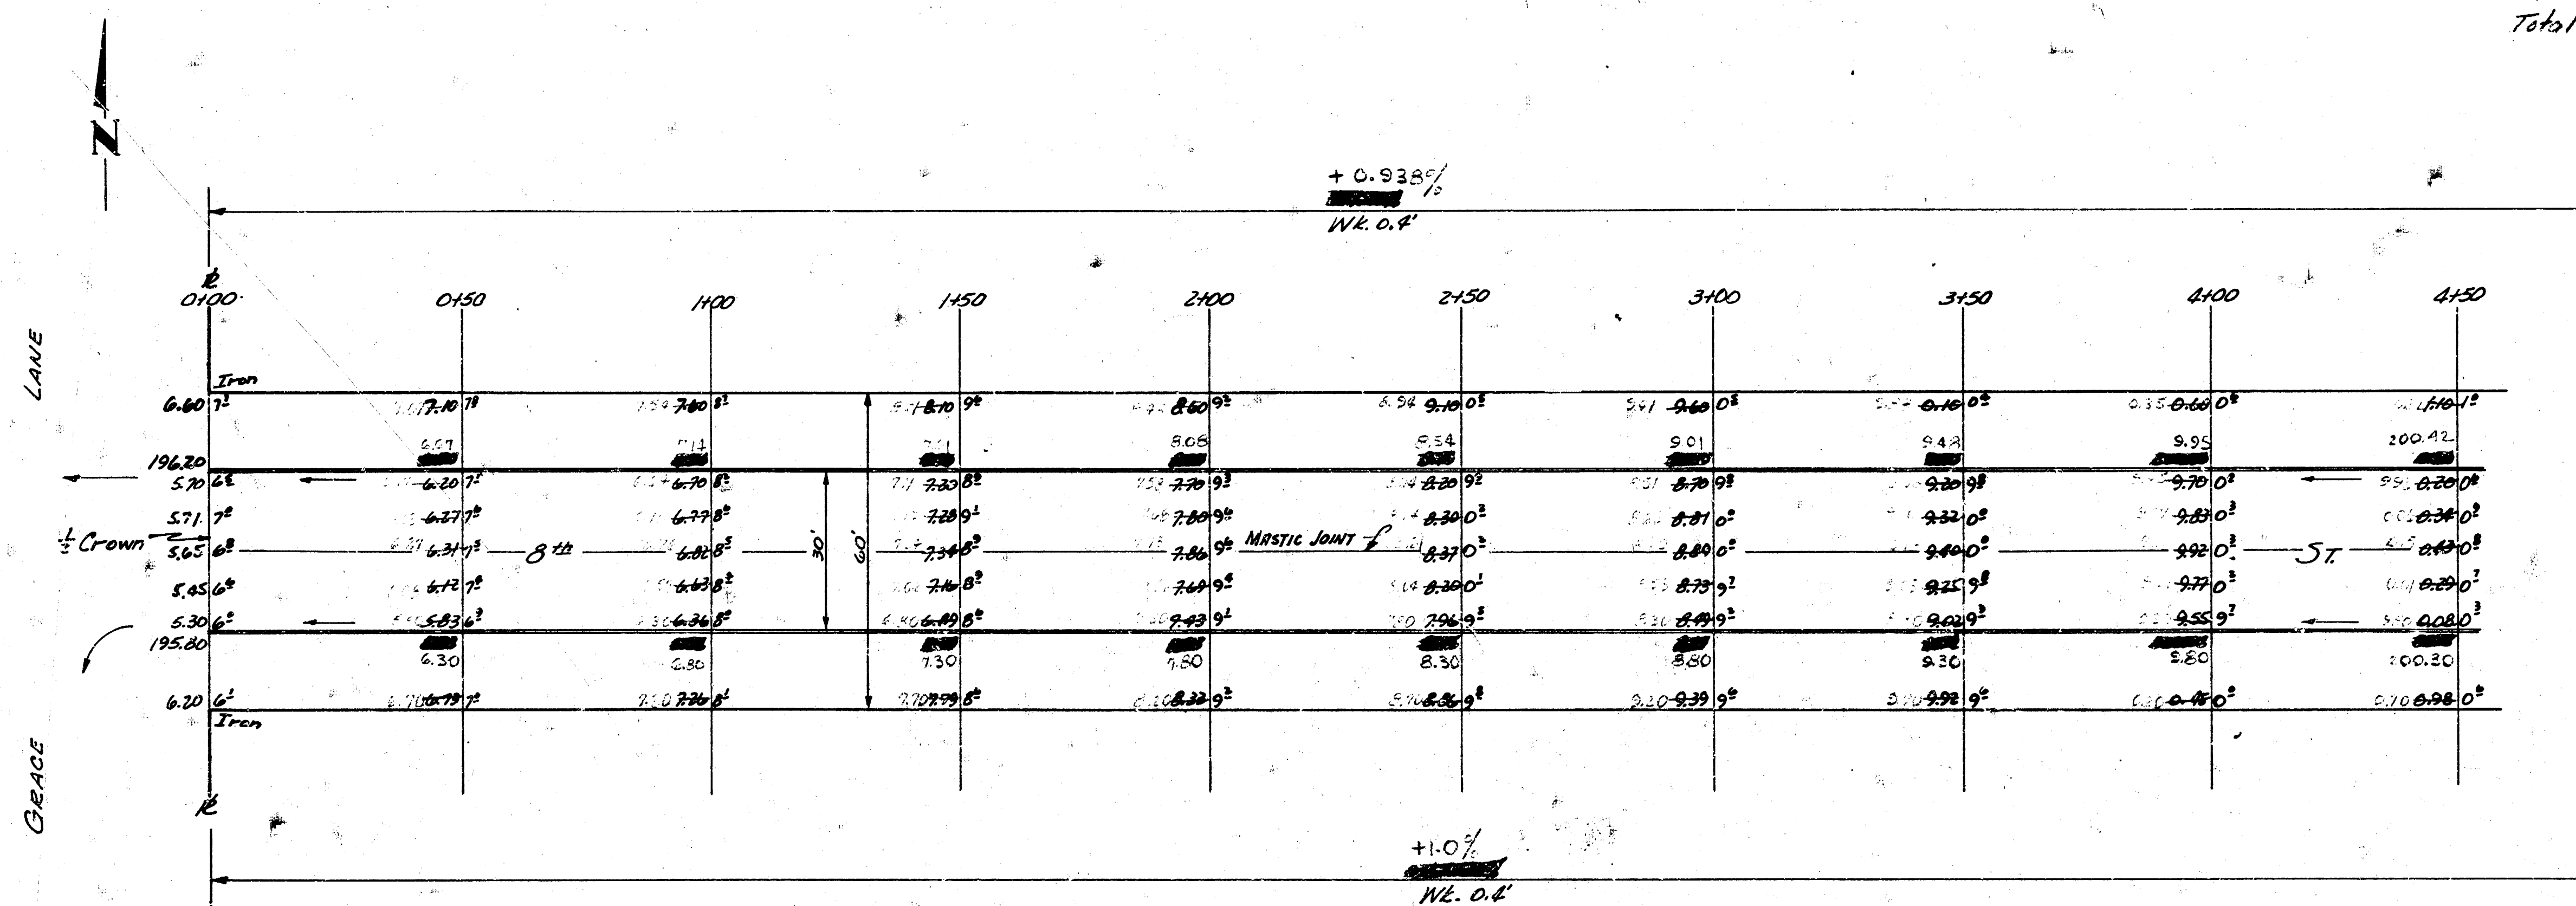

Use $\frac{1}{2}$ " ϕ bars, 3' long on 2'-6" centers

DETAIL OF MASTIC JOINT

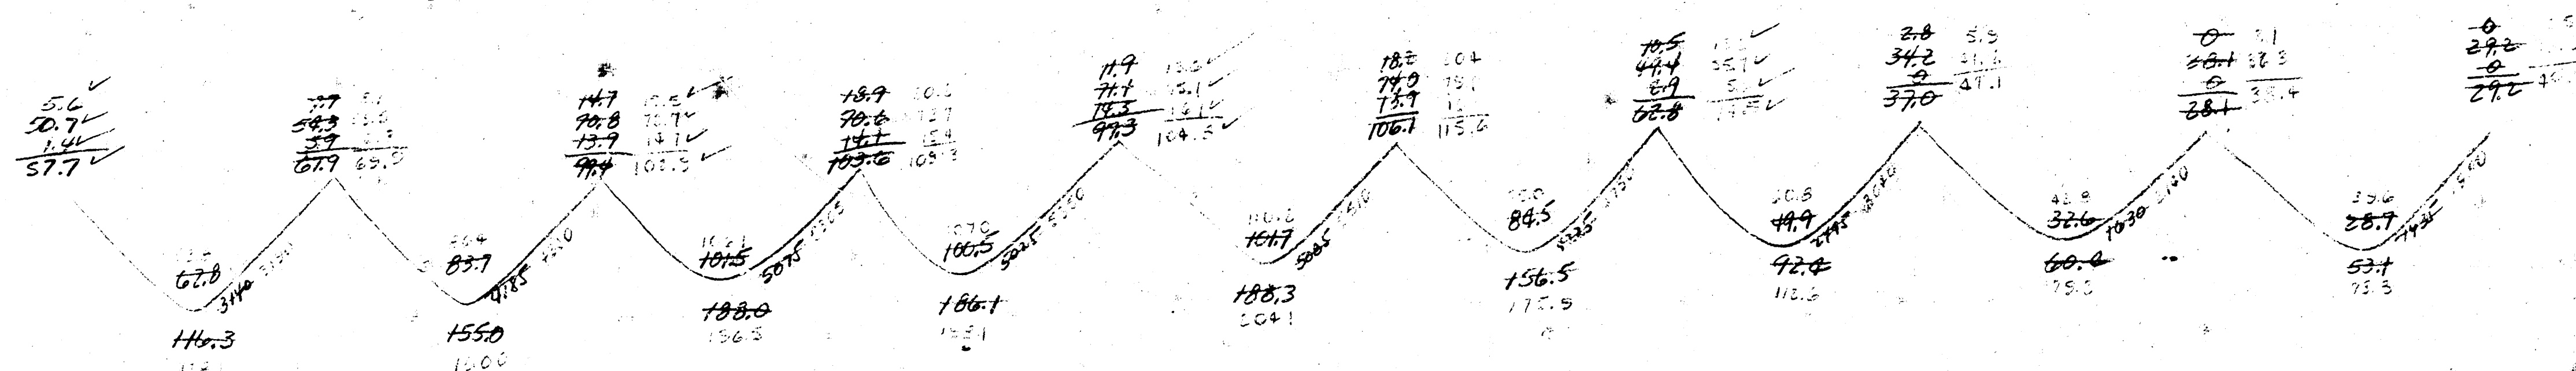
$$\frac{1}{2}$$

8TH ST.
E.L. GRACE LANE TO W.L. WOODLAWN
30' CONC. & CO.
CITY OF WICHITA, KANSAS
B.E. SMITH CITY ENGINEER
MAY 1954 DES. NO. C18-36



