


46 y

B.M. 19110 - S.W. CORNER PORCH HO. NE. CORNER GLENDALE & 8th "SOUTH PORCH"

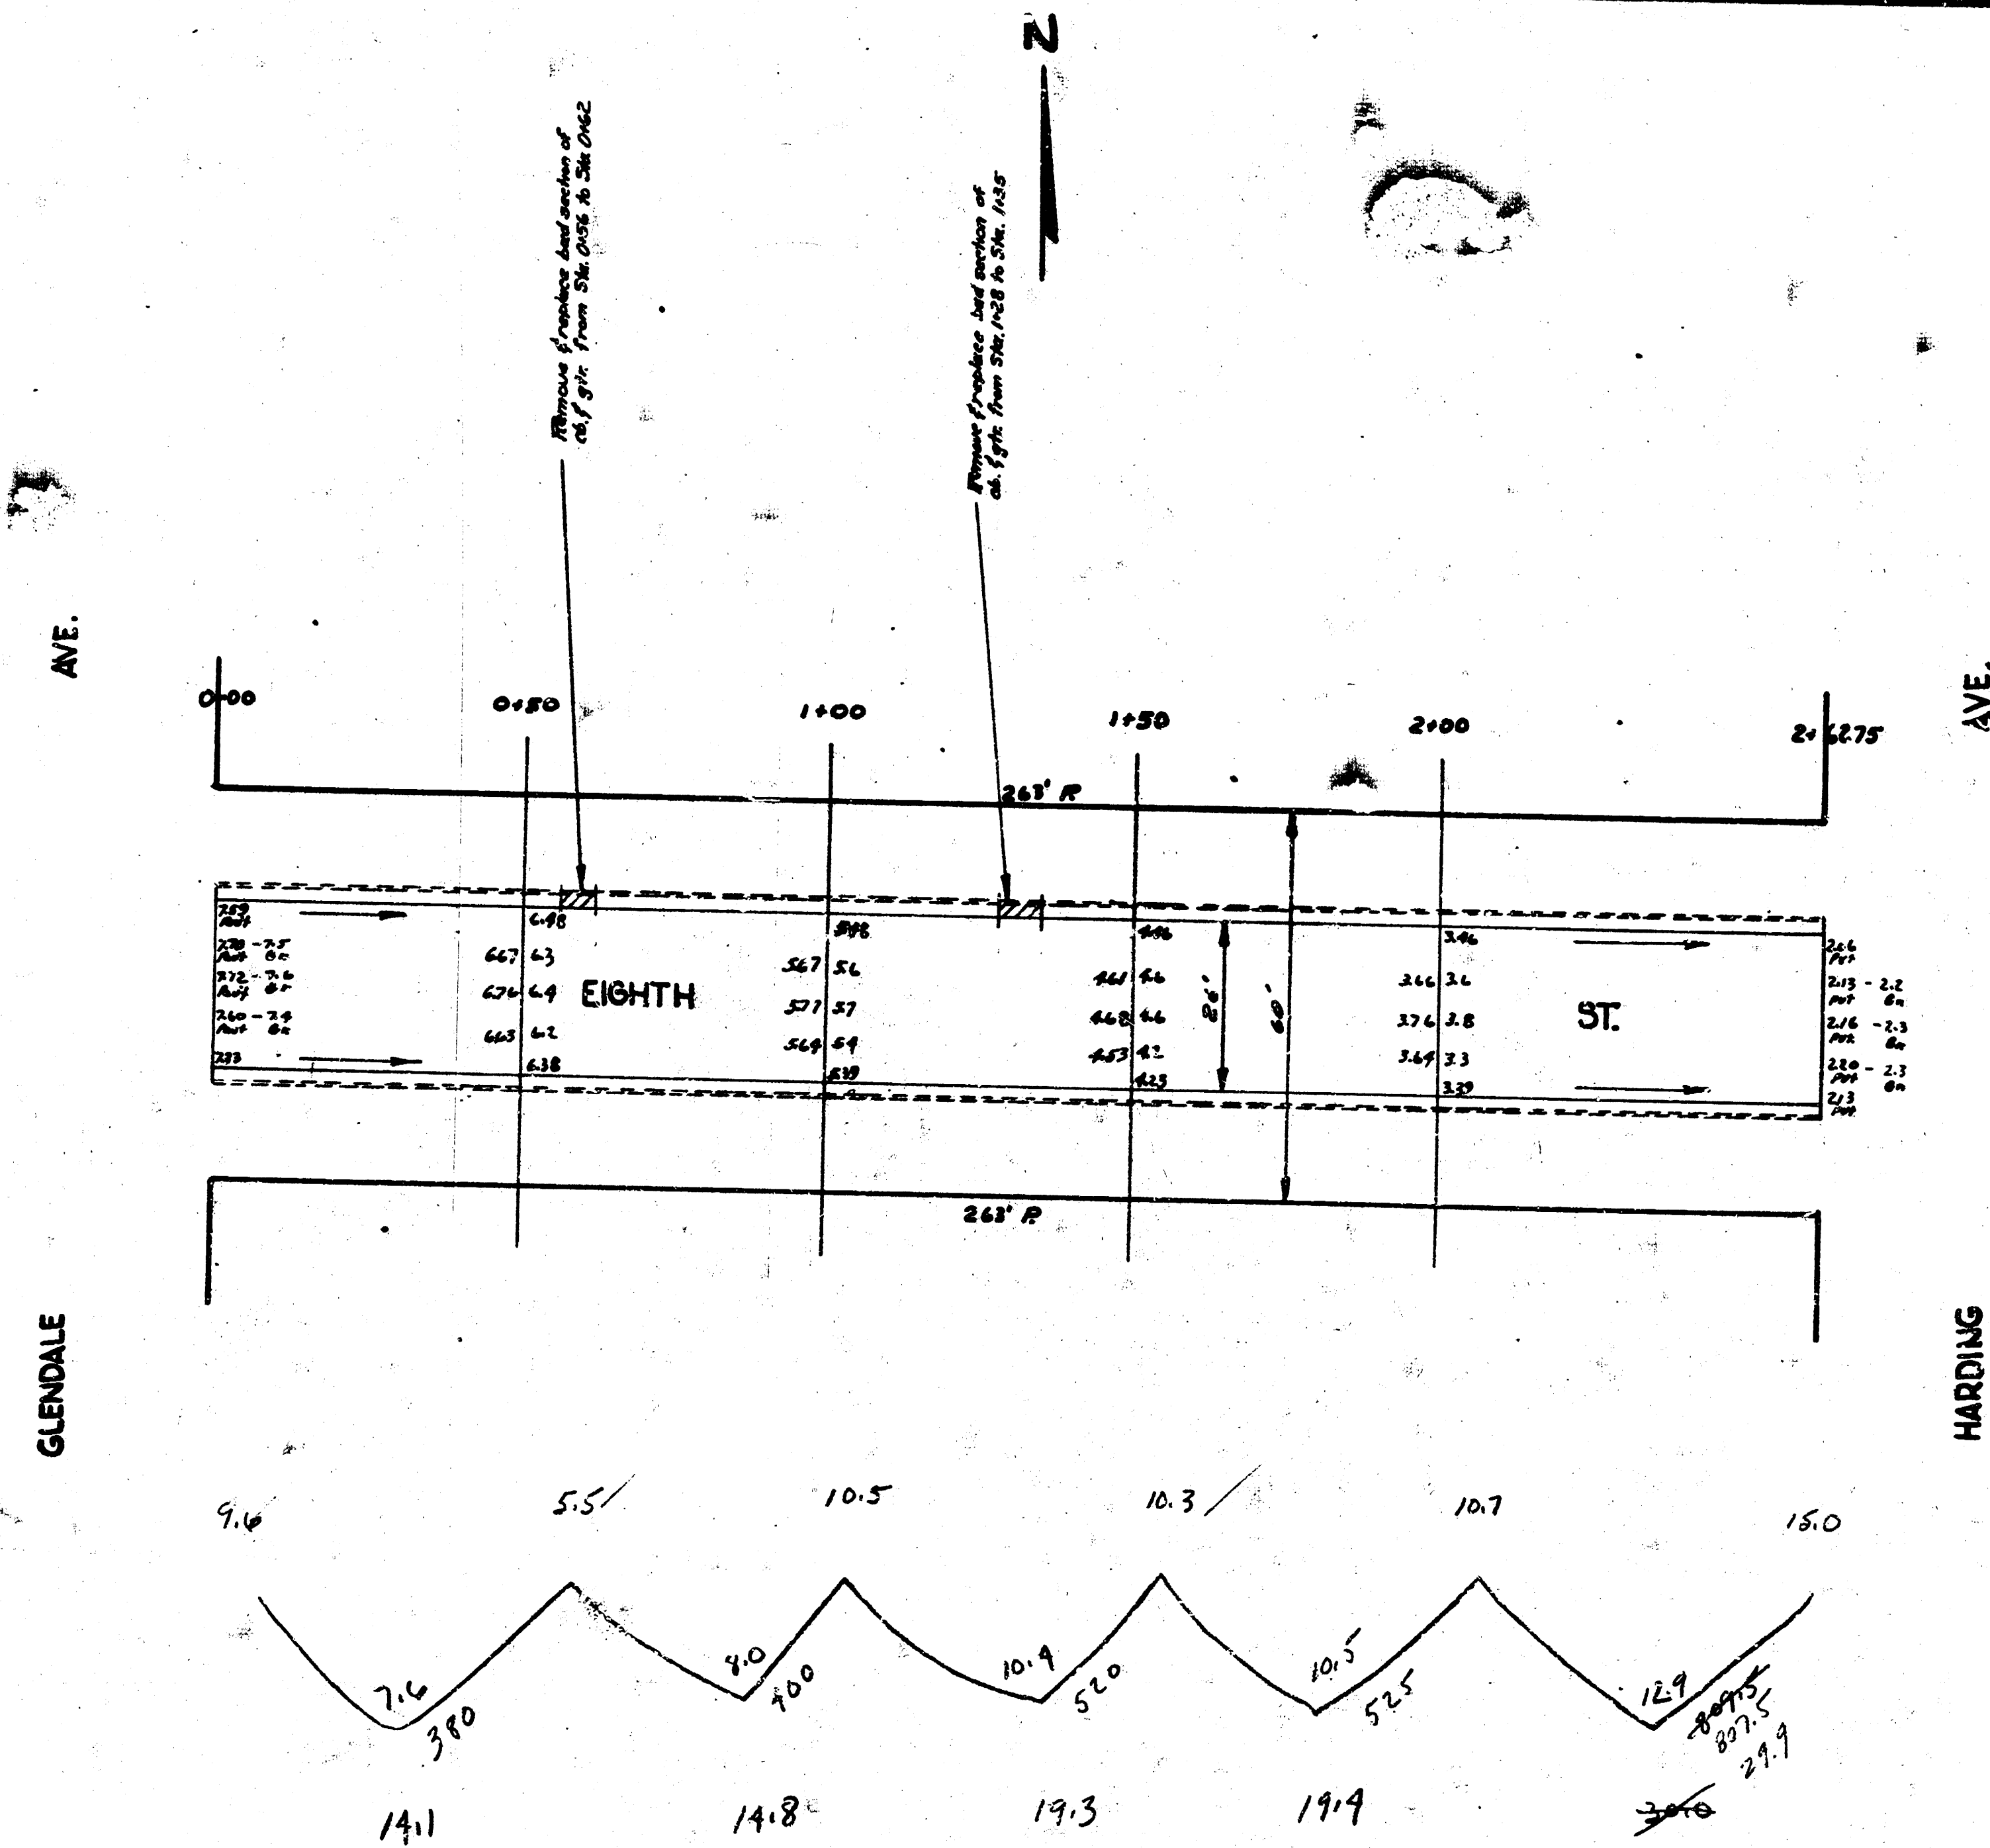

Property	City
19.1	
19.8	
19.3	
19.4	
11.0	
97.6	
+10%	
107.4	low pds.

EIGHTH STREET
 E.L. GLENDALE to W.L. HARDING
 25' Conc.
 CITY OF WICHITA, KANS.
 L.K. WHITE CITY ENGINEER
 SEPT. 1950, PROJ. NO. C10-123

4 e s (51)