


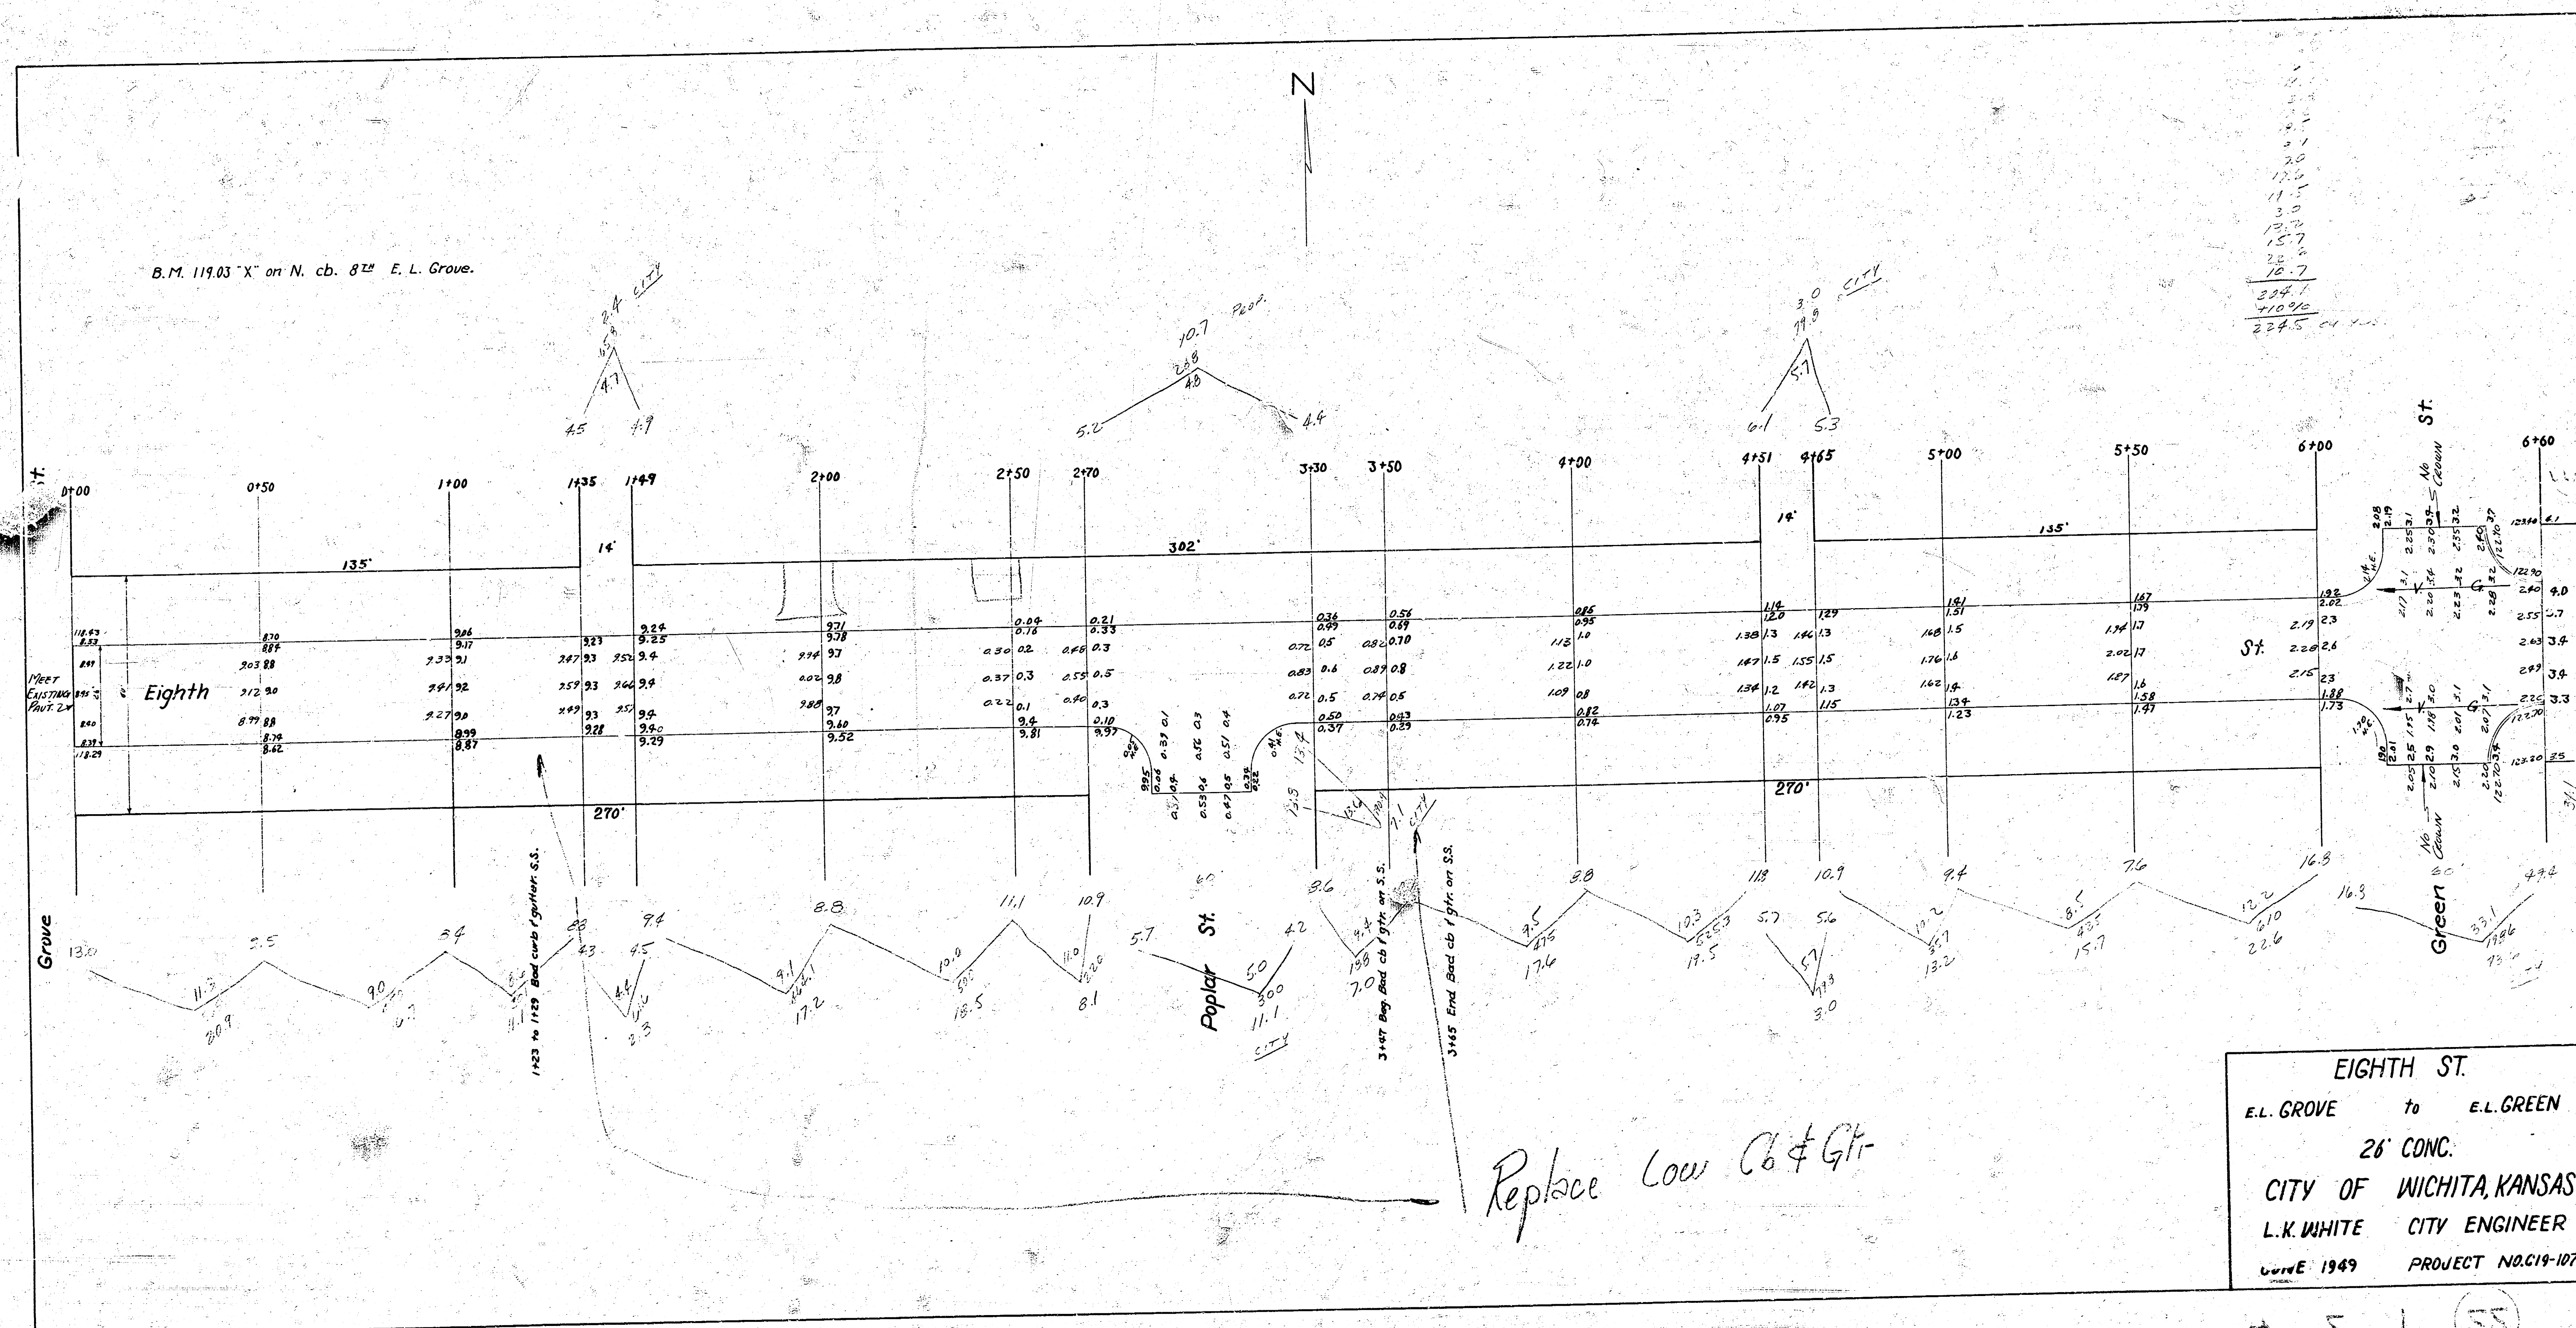

11.3
2.5
9.0
3.4
9.1
10.9
11.1
10.9
5.7
4.2
9.5
10.3
5.7
5.6
9.2
8.5
12.2
16.9
10.3
4.9

4 5 1 55