


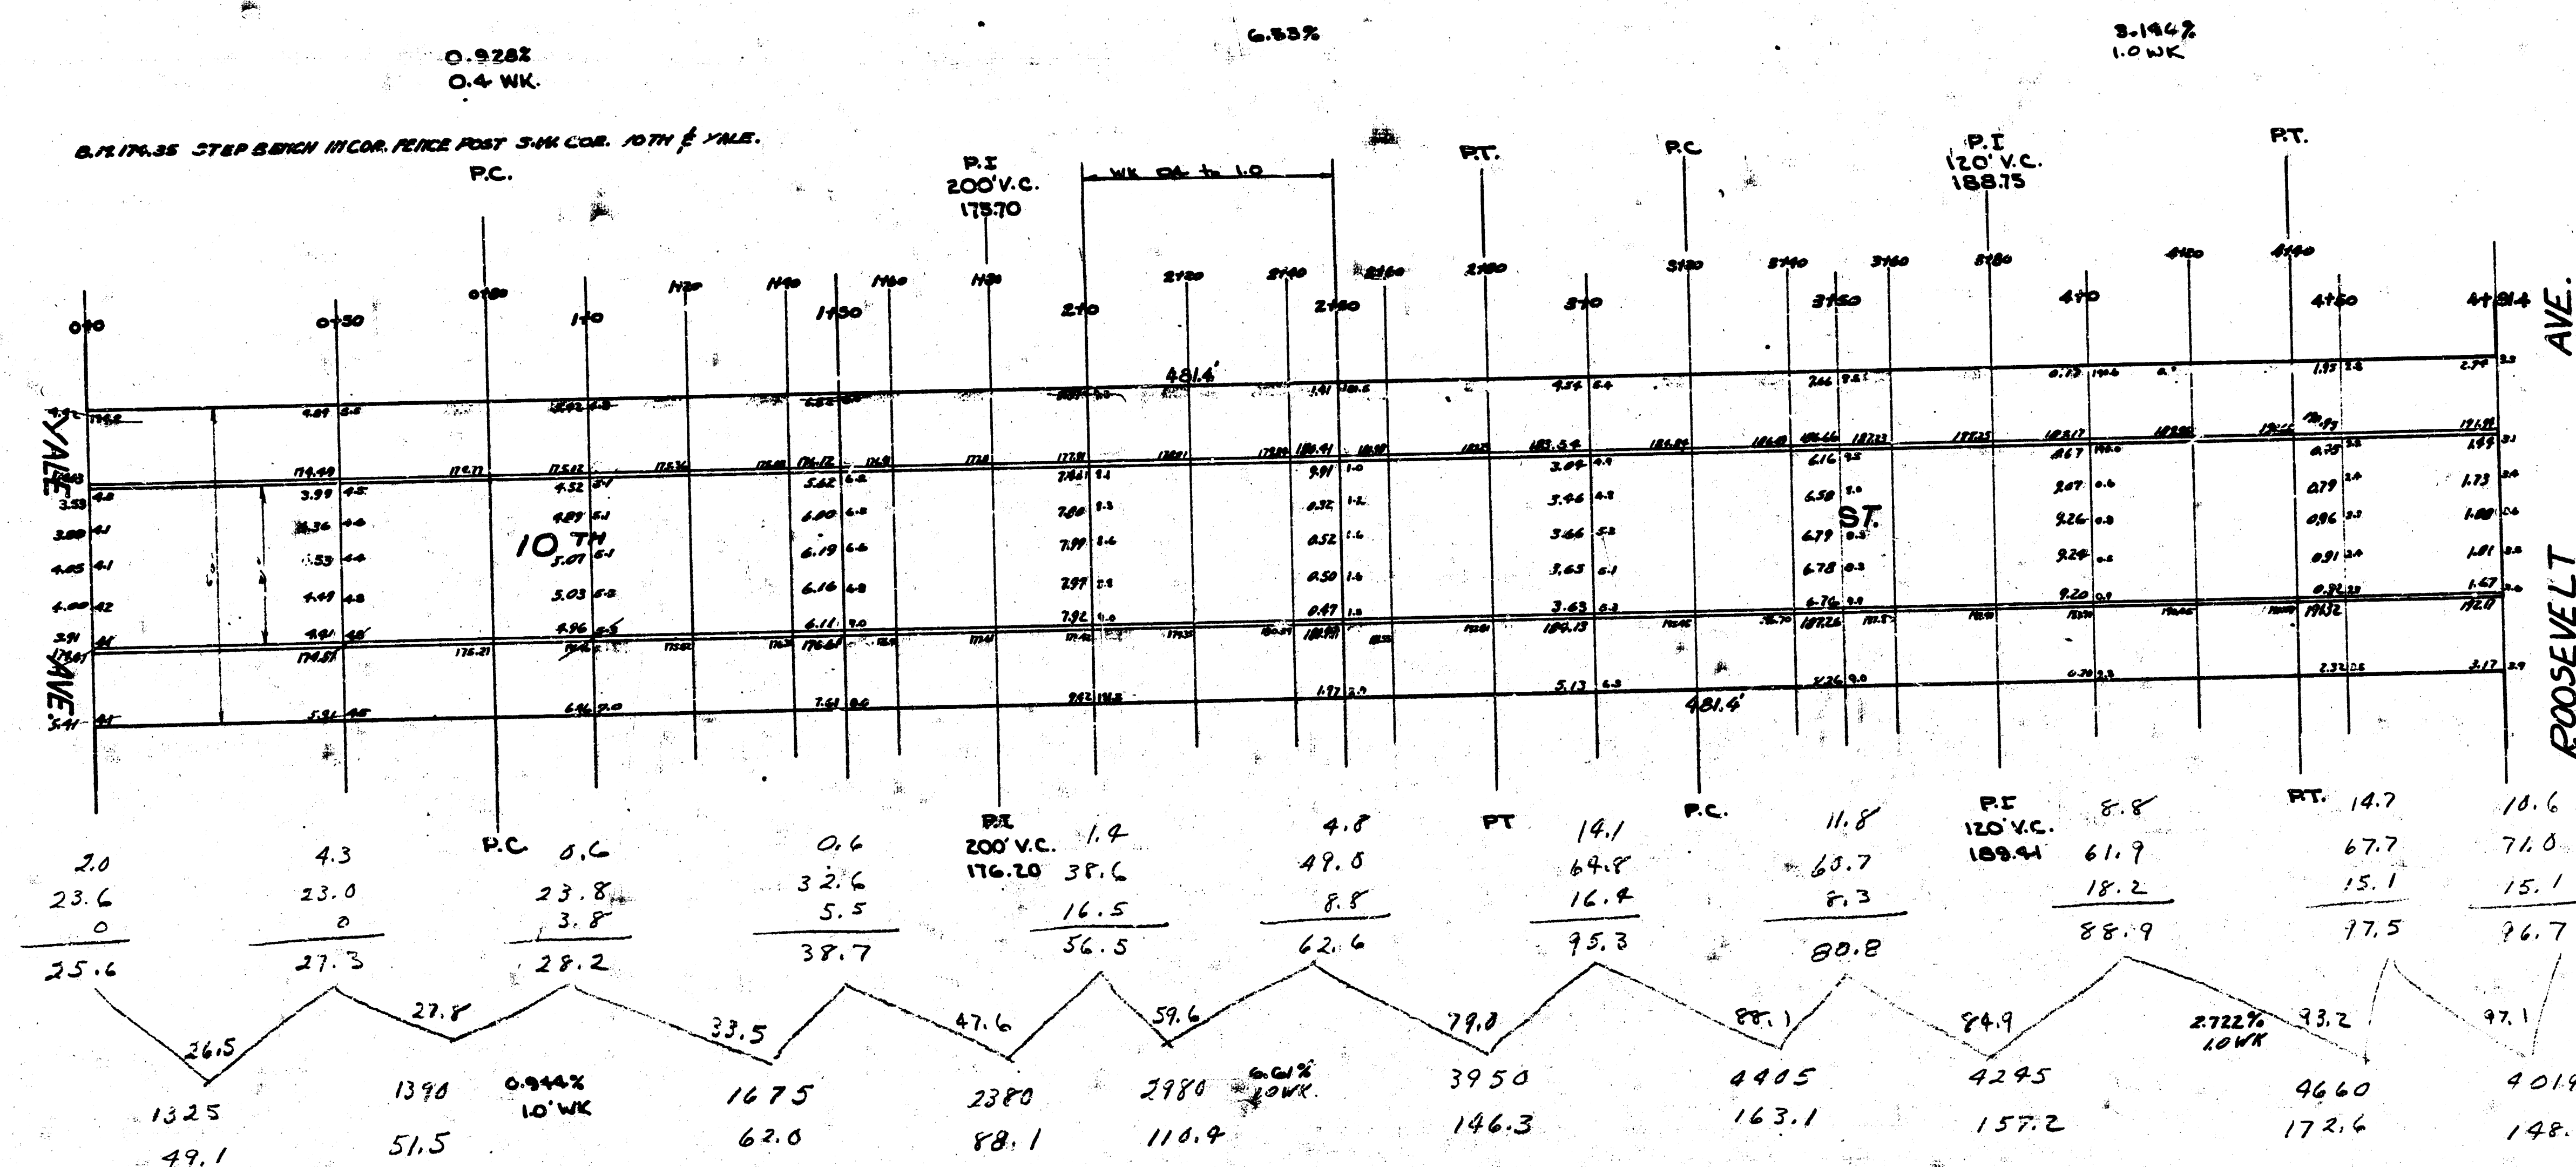


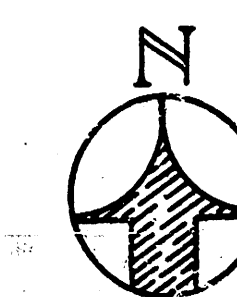

10TH ST.
E.L. YALE TO W.L. ROOSEVELT.
30' CONCRETE & CB.
CITY OF WICHITA, KANS.
L.K. WHITE CITY ENGINEER
1947

30 yds

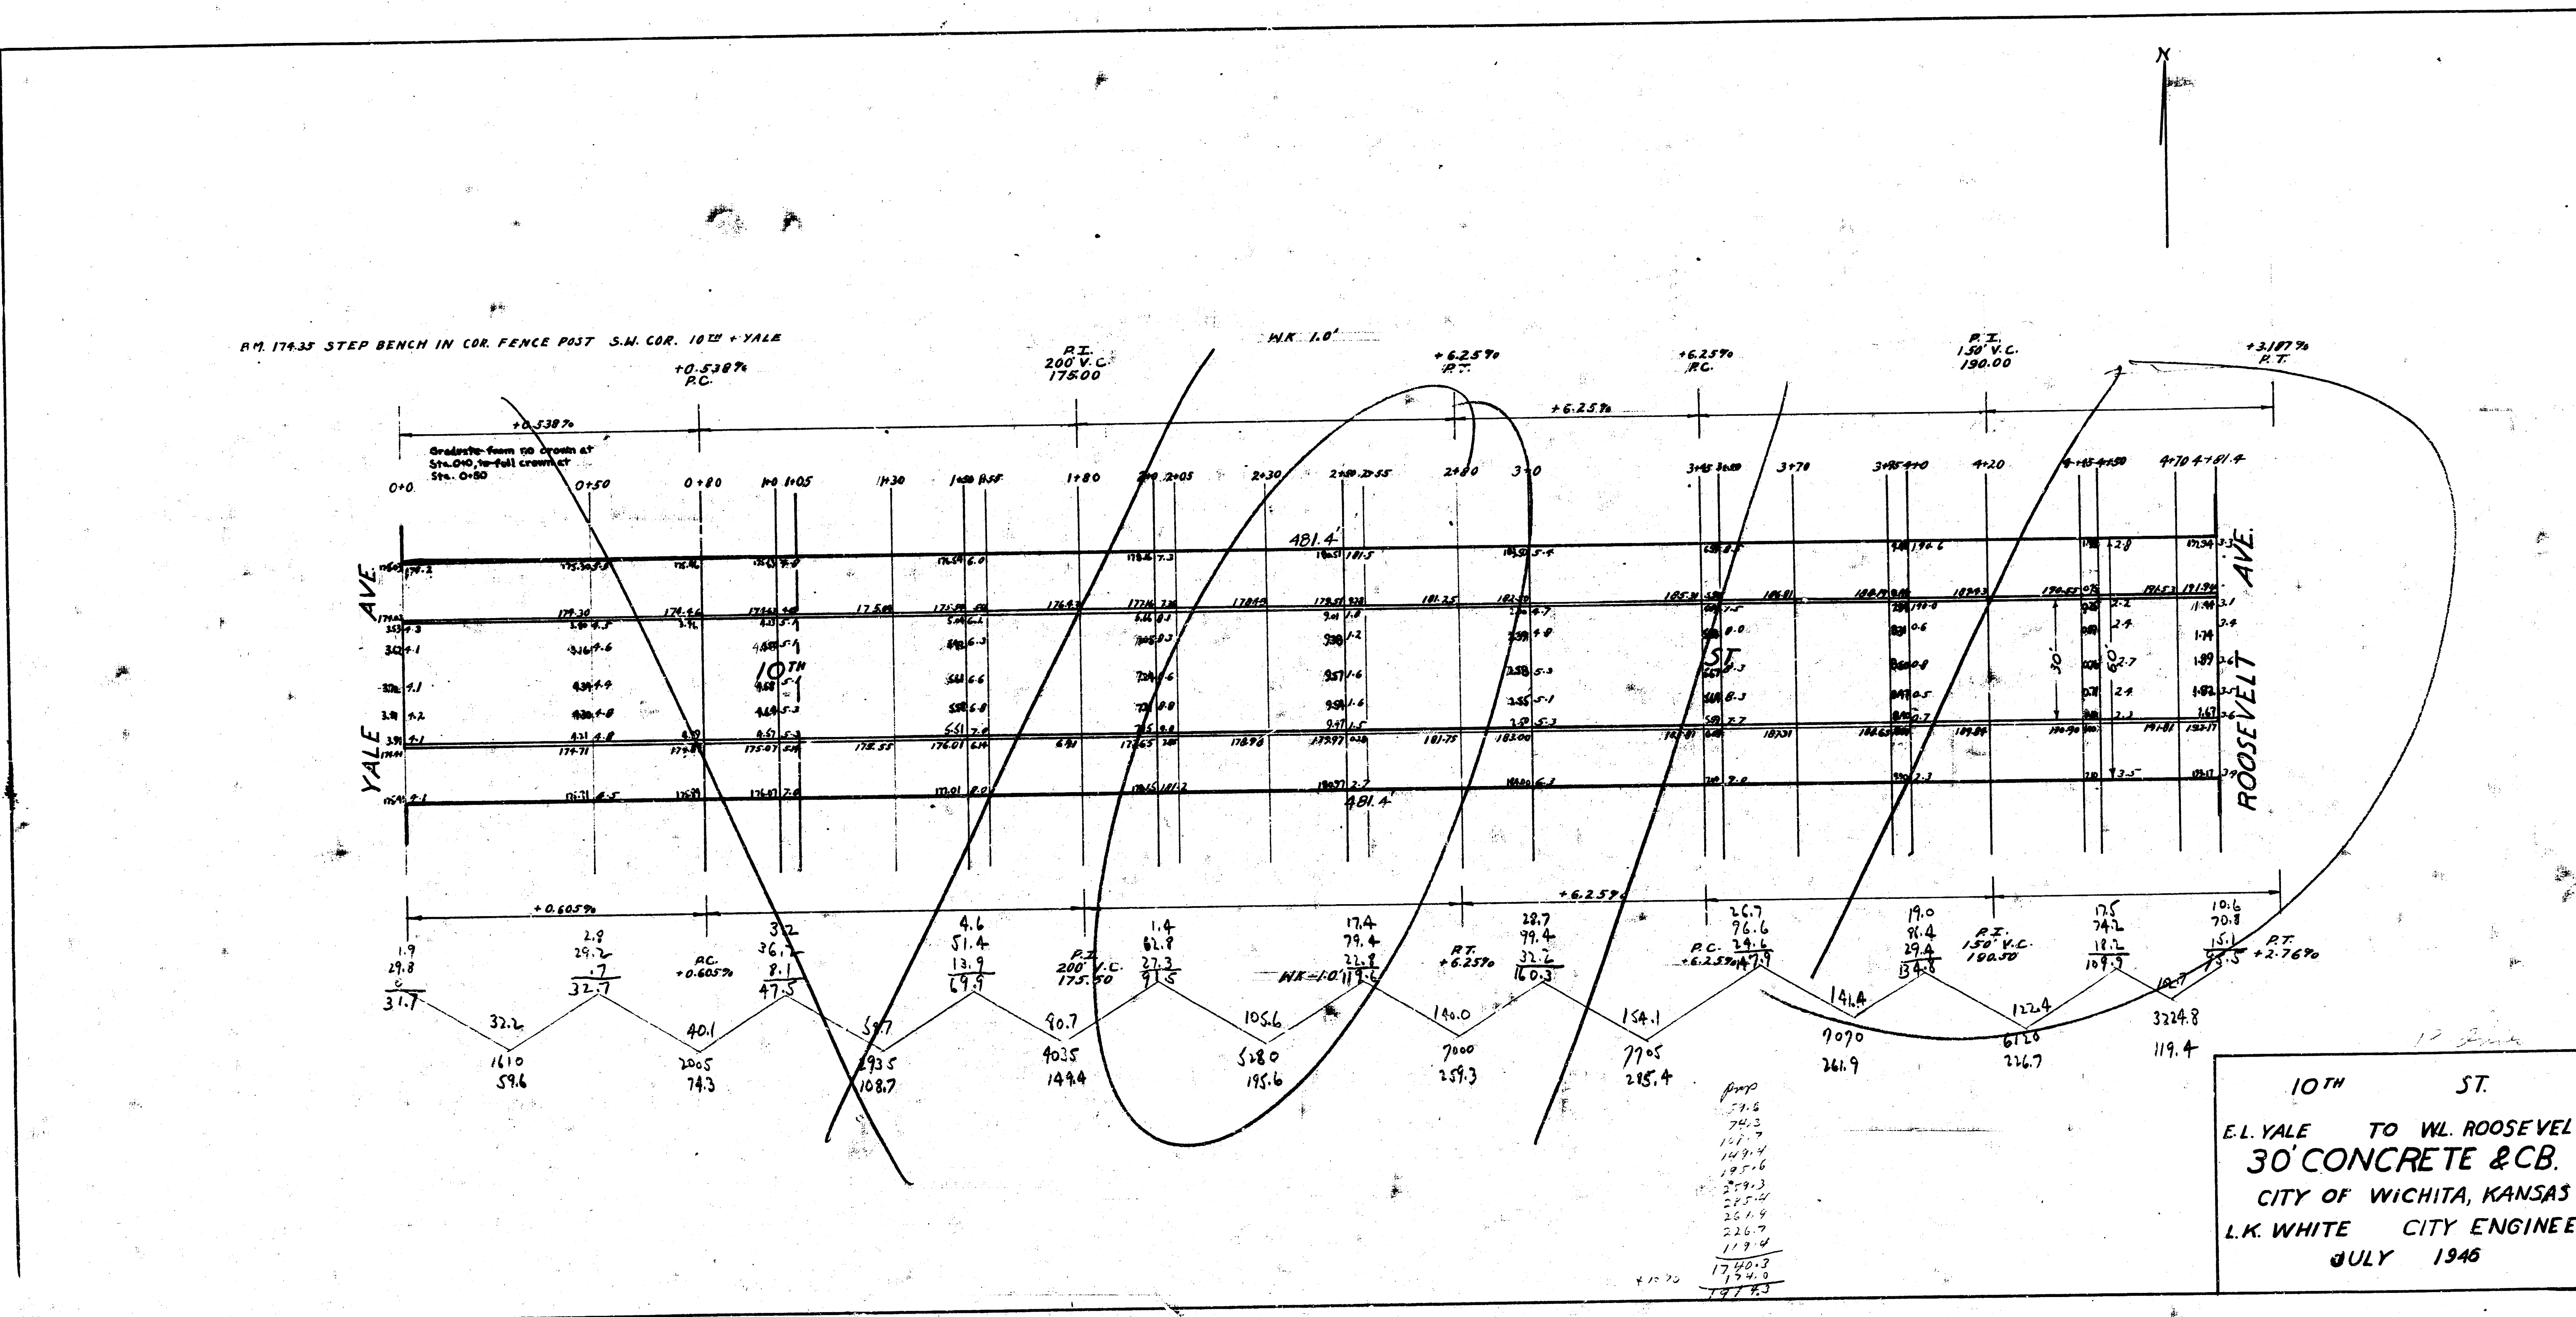


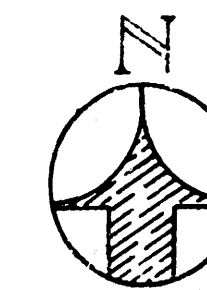

0.928%
0.4 WK.
P.C.

6.53%

3.146%
LOWK

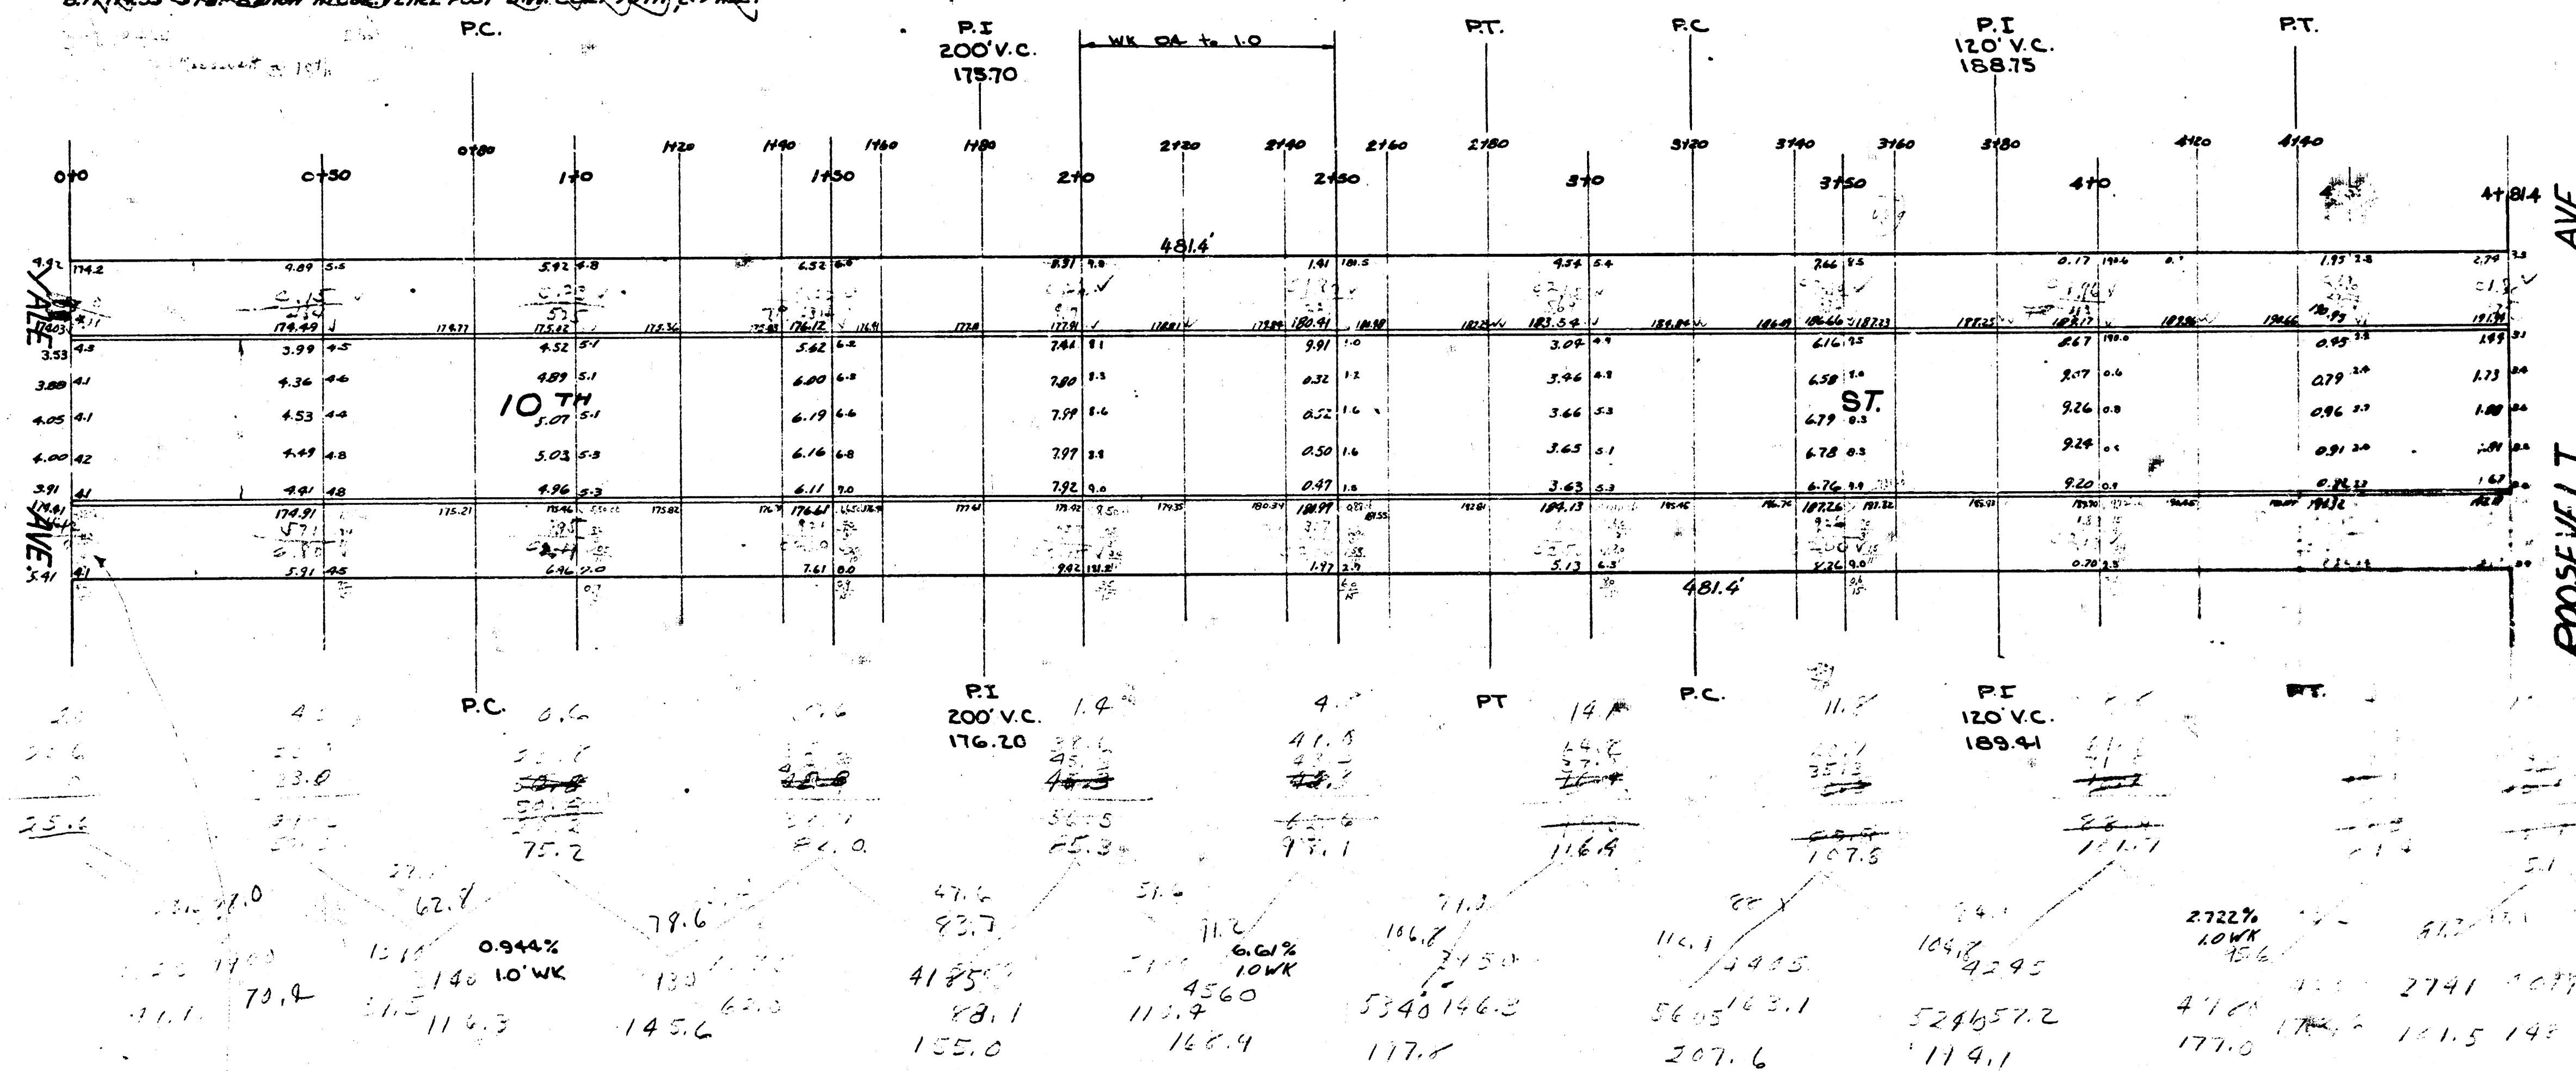



10TH ST.
E.L. YALE TO W.L. ROOSEVELT
30' CONCRETE & C.B.
CITY OF WICHITA, KANS.
L.K. WHITE CITY ENGINEER
1947