

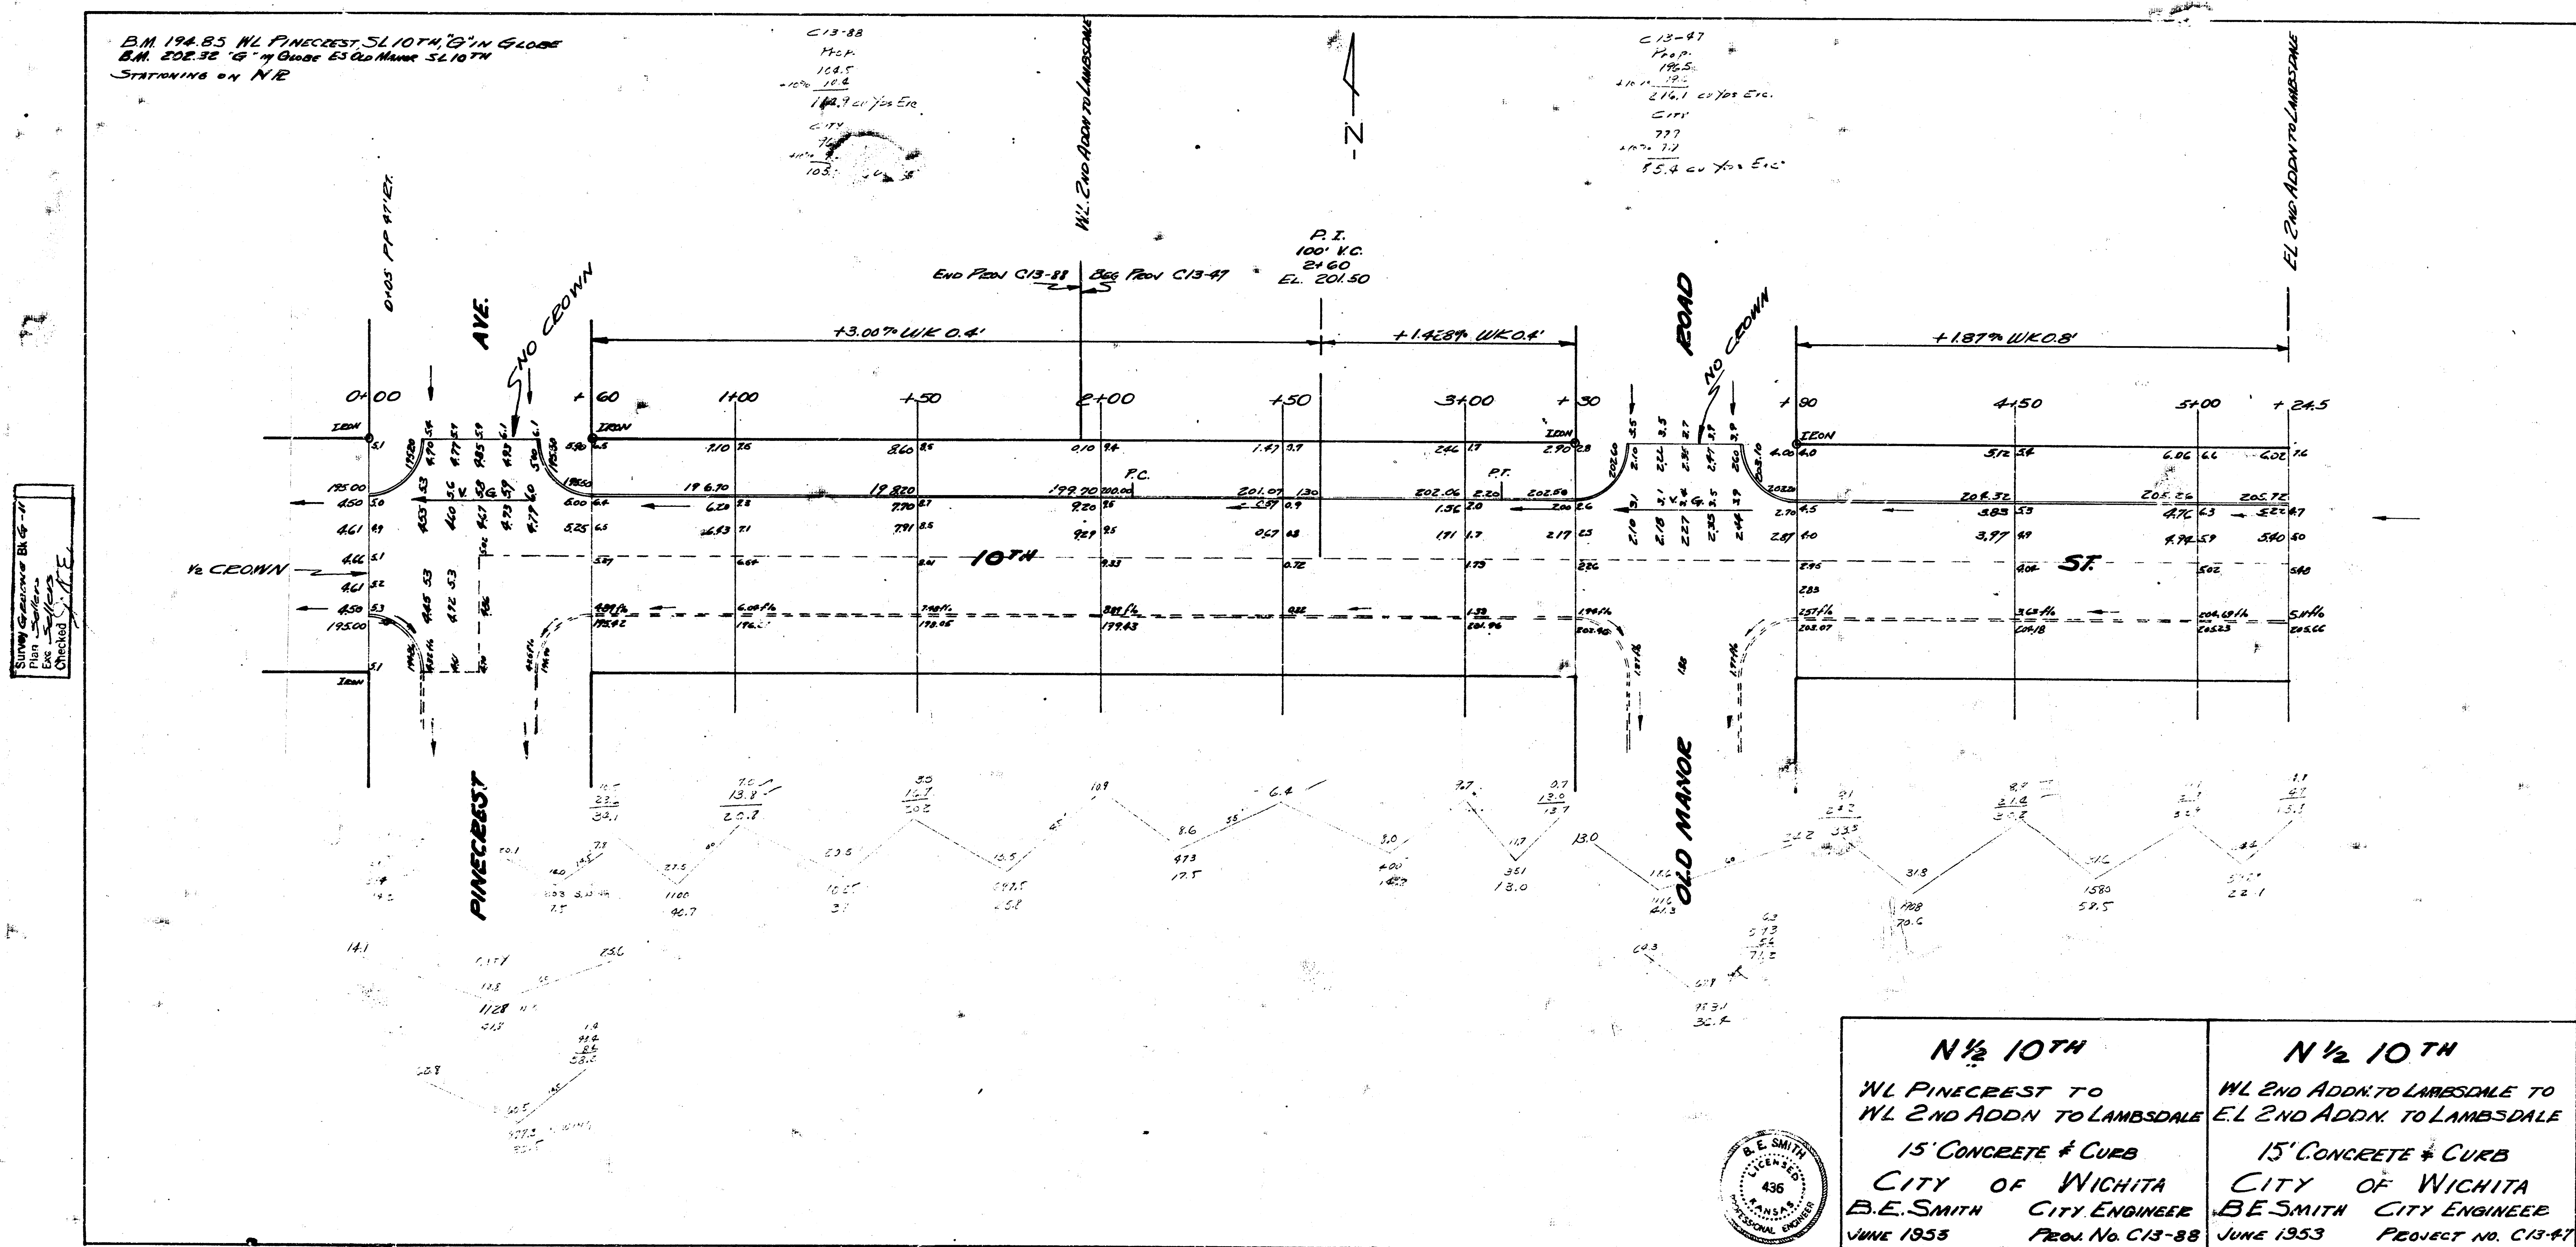


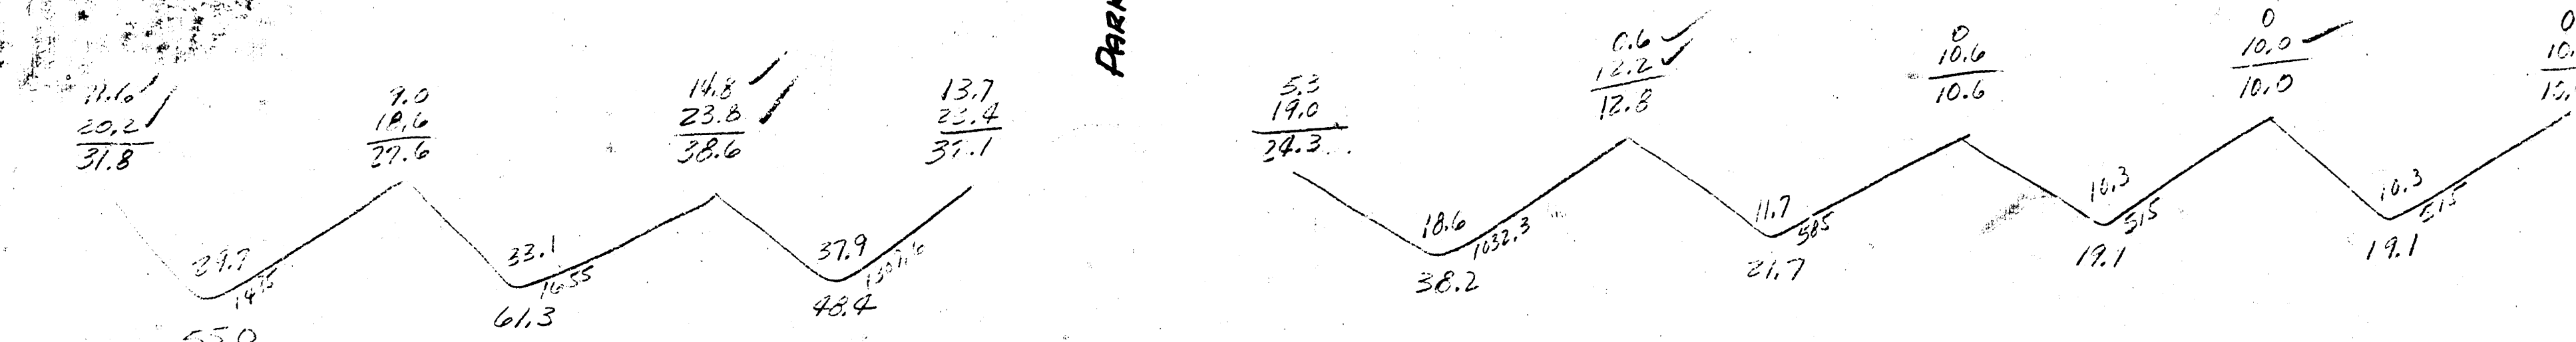

B.M. 20138 "G" in Globe & Wk. Se on Push Block (just back of) S.W. Cor. Edgemoor & 10th
 B.M. 21013 "M" in Mueller on Fire Plug, S.W. Cor. Parkwood & 10th

Grav. Total Excav.	
Prep.	24.3
202.3	24.3
318.3	24.3
581.1	164.5
+107.1	10.5
Total	639.2
Total	181.0

55.2	7.1
24.2	7.2
44.2	8.3
38.2	
2.7	
13.1	
202.3	

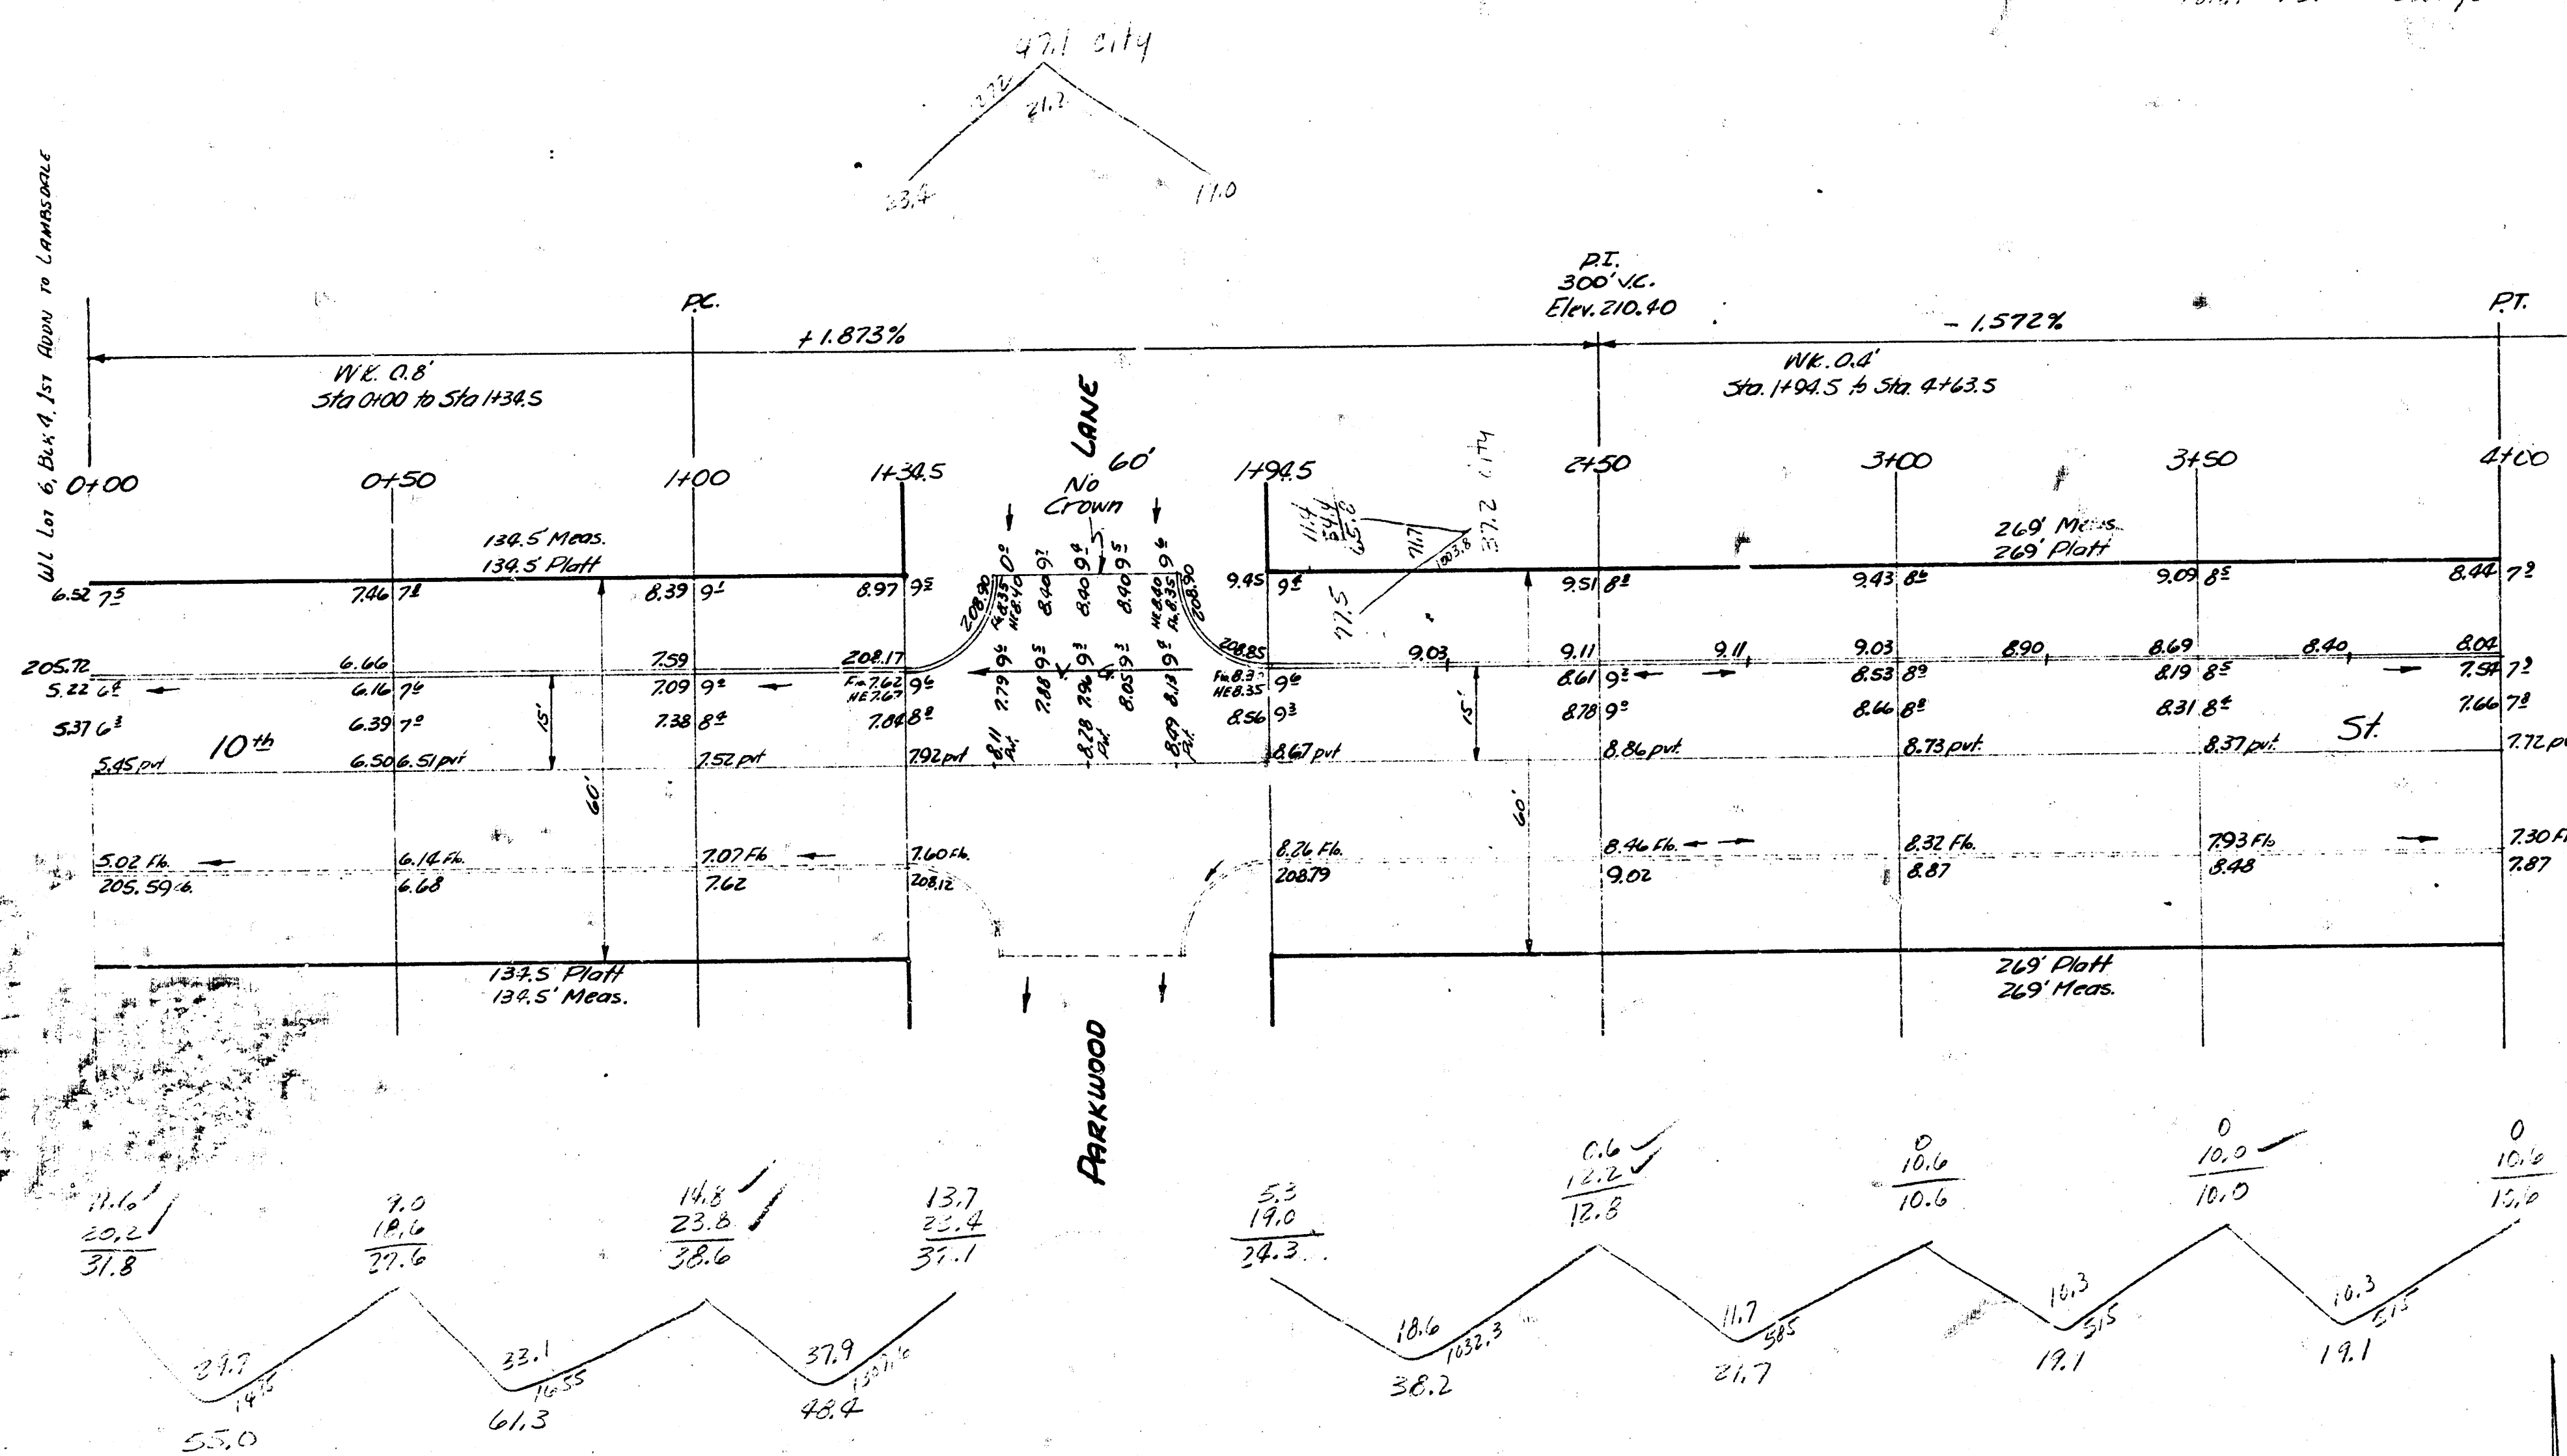


1/2

N¹/₂ 10TH ST
 15' CONC & C.B.
 CITY OF WICHITA, KANSAS
 B.E. SMITH CITY ENGINEER
 JAN. 29, 1953 Pers. No. C/2-246

NOTE: Iron pin on W.L. Edgemoor & 10th St West
Ties: @ BL W.L. South
& Pavement West

Prop.	Excav.
26.9	21.4
20.0	30.4
51.0	13.5
51.0	21.0
52.4	15.3
52.2	
55.0	82.2
318.3	sum

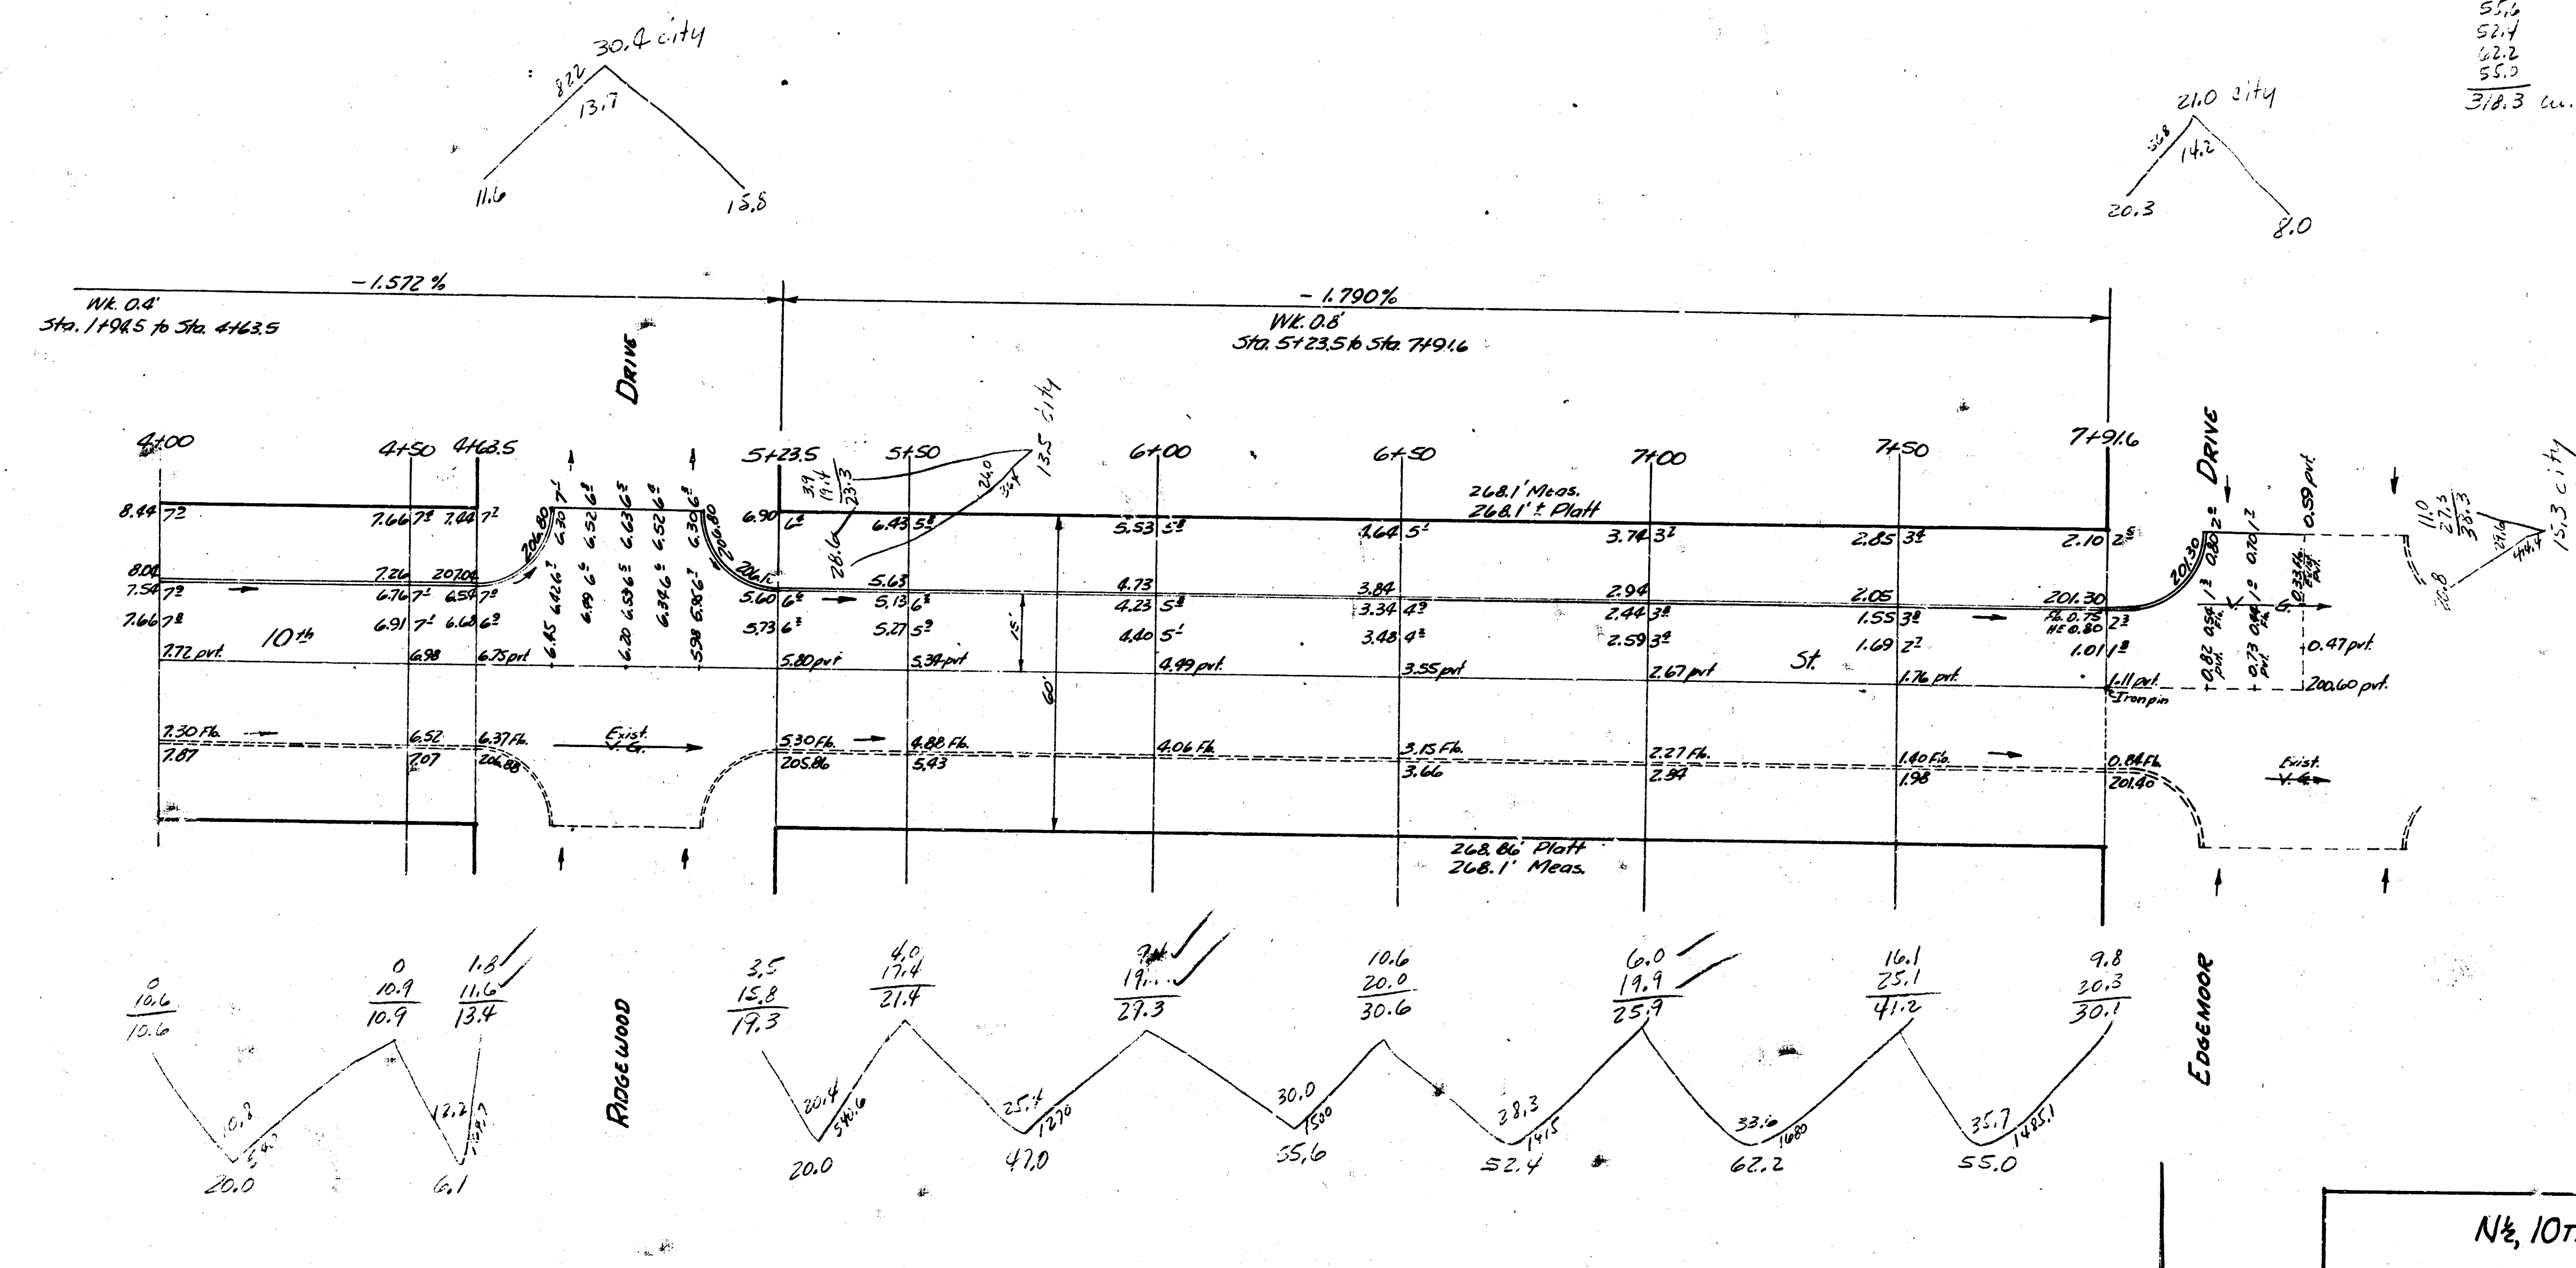


N 1/2 10th St

Plan 33

B.M. 176.00 Conc. Base S.S. Put 5' W of Pinecrest St. 10" dia
B.M. 208.50 Iron S.W. Old Manor 10" dia

Property	City	Grand	Property	City
728	44.4	Total	639.3	196.0
681	28.5		225.6	31.9
52.4	61.0		573.8	330.7
343	31.3		1438.7 2 1/2	528.8 Cuyd
24.9	178.2			
4.1	11.8			
75.7	107%			
167.2	581.2			
54.8	581			
49.4	639.3 Cuyds.			
51.9				
21.9				

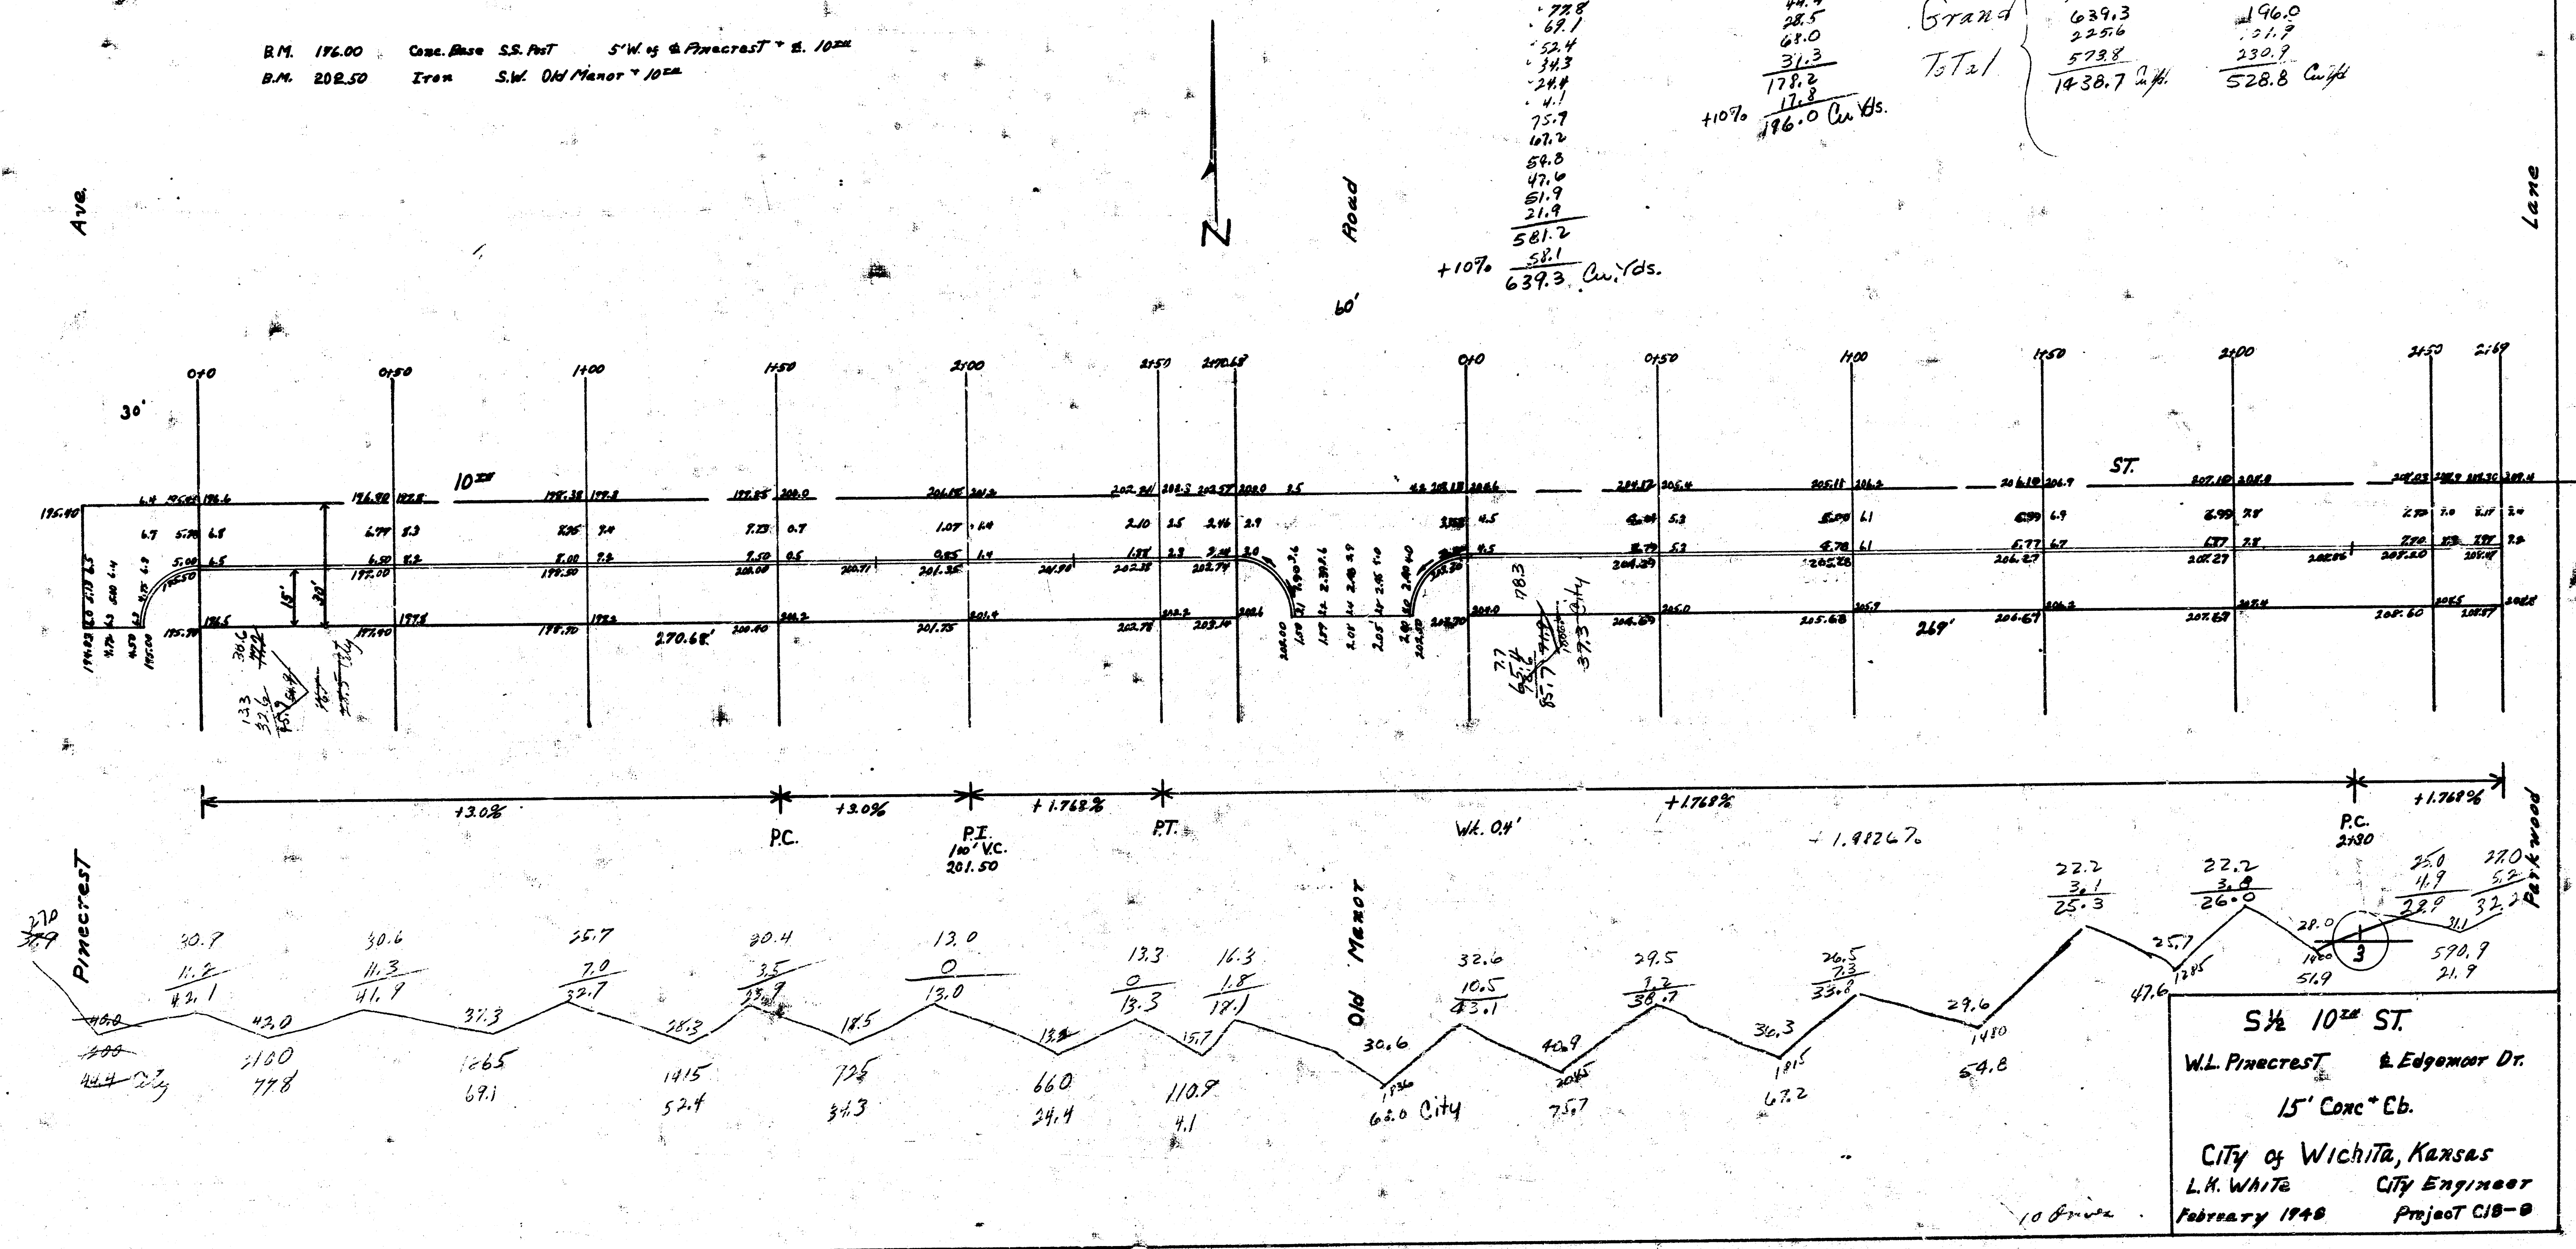

B.M. 208.95 Cont. Base S.S. Post * Parkwood Lane * 10th
 B.M. 207.12 Iron S.E. Ridgewood Drive * 10th

Property	City
48.5	27.7
43.7	64.7
35.2	<u>72.6</u>
33.7	+10%
50.7	106.7 C.F.H.
23.3	
<u>205.1</u>	
225.6 C.F.H.	

