


Continue pavement
 offset 20.2
 114 elev. 12970 Standard N.E. on 21st + Berfance

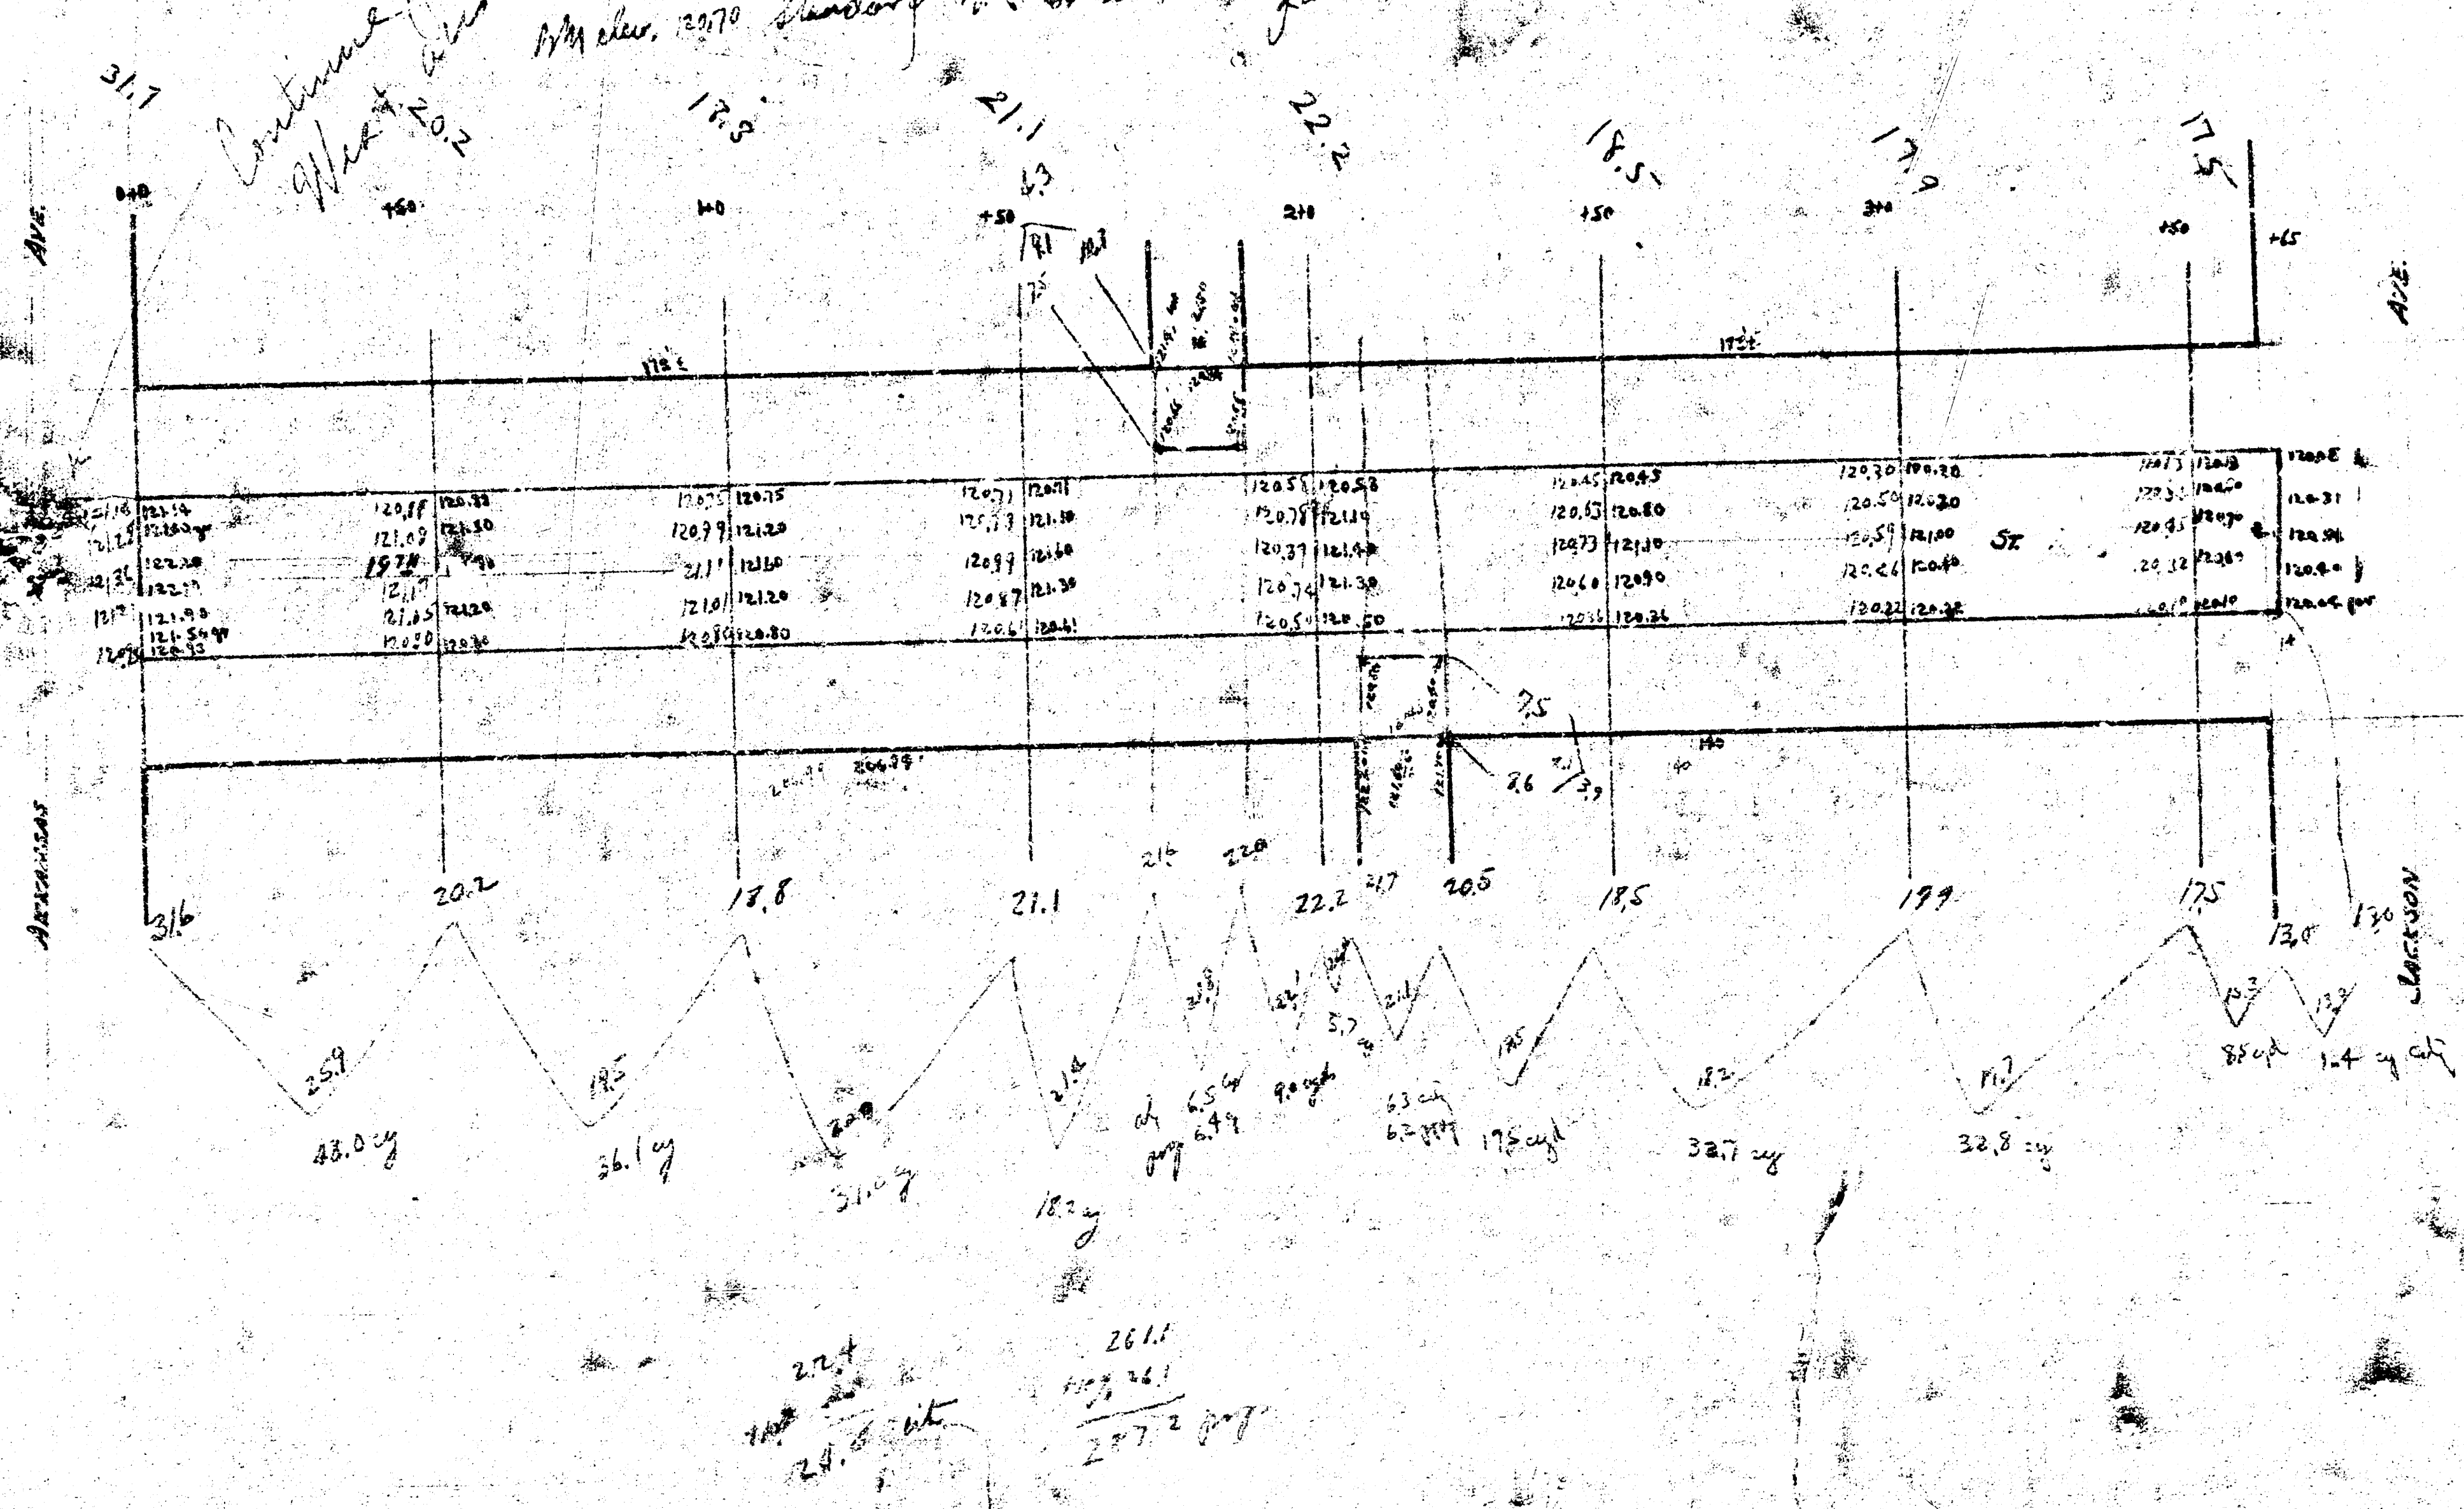

For Plot
 193 St.
 St. Arkansas
 Mr. Jackson