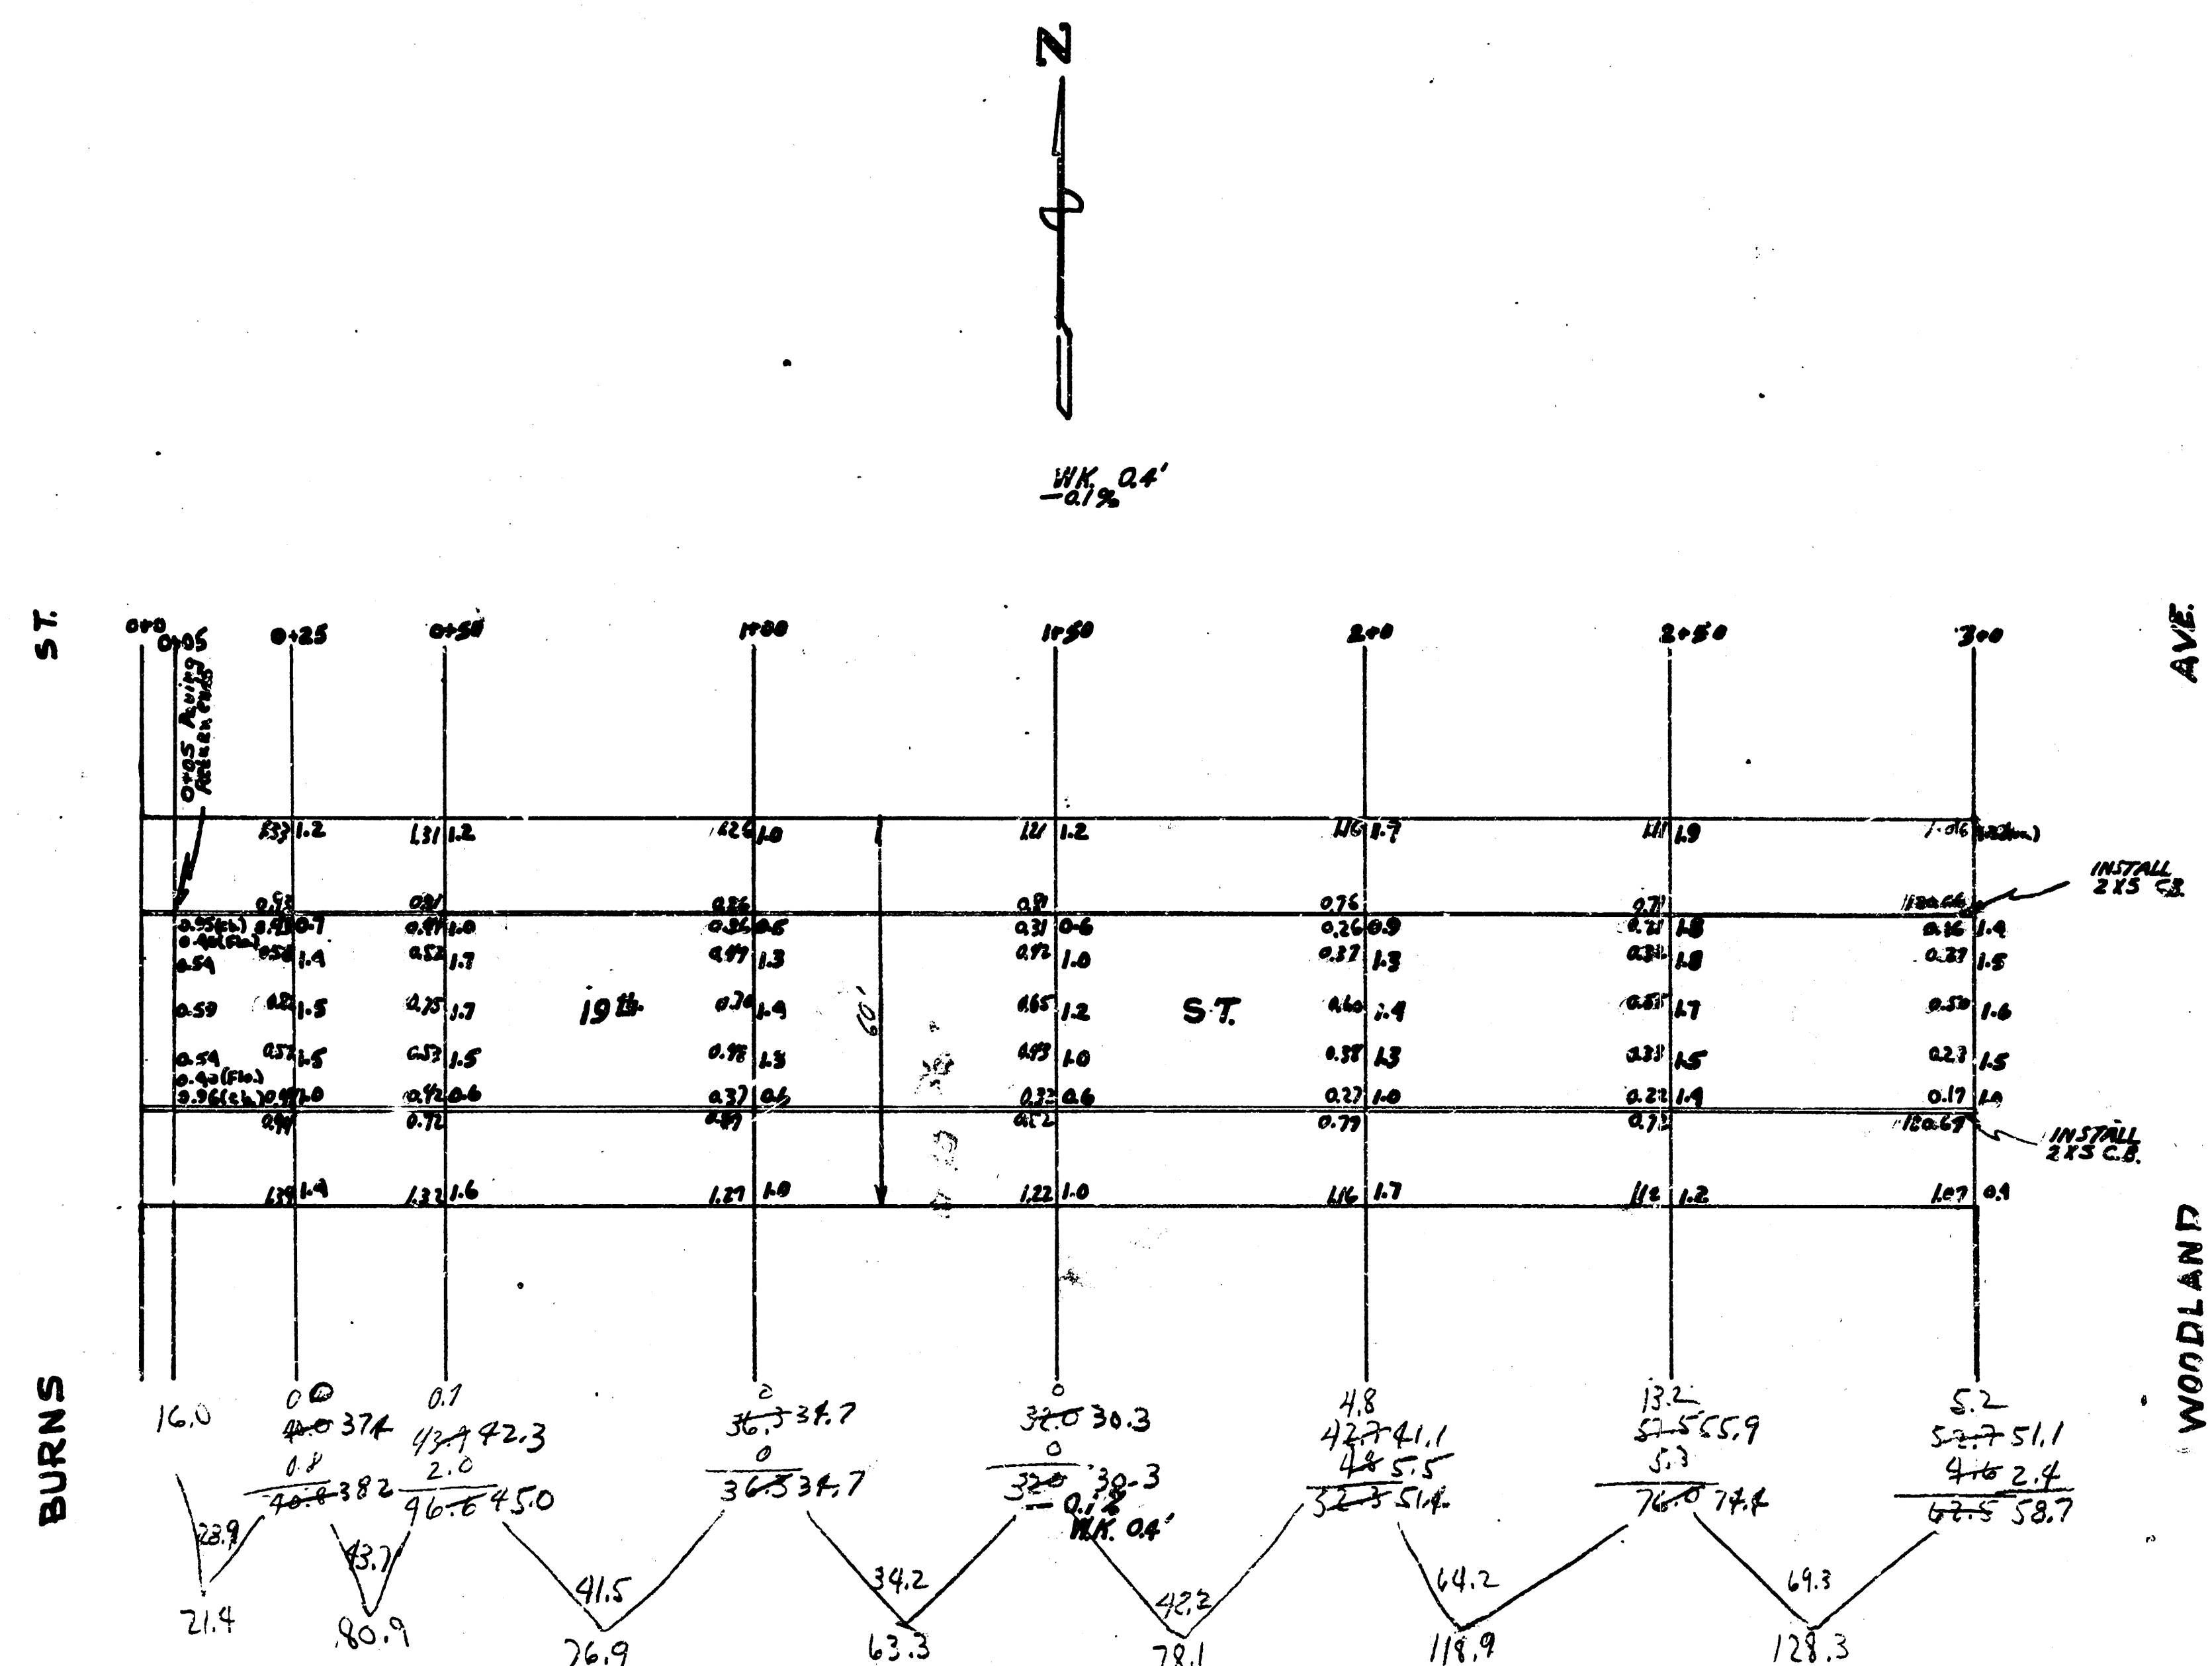


B.M. 121.46 - X on front wn. S.W. cor. Woodland / 10th.
B.M. 119.82 - Top of thm. ch. 10th / Woodland


$$\begin{array}{r} \text{Prize} \\ 21.4 \\ 80.9 \\ 76.9 \\ 63.3 \\ 78.1 \\ 118.9 \\ 128.3 \\ \hline 567.8 \\ +14\% \\ 56.7 \\ \hline 624.5 \end{array}$$

E.L. BURNS W.L. WOODLAND
30' CONC. FEE
CITY OF WICHITA, KANSAS
L.N. WHITE CITY ENGINEER
JULY, 1947