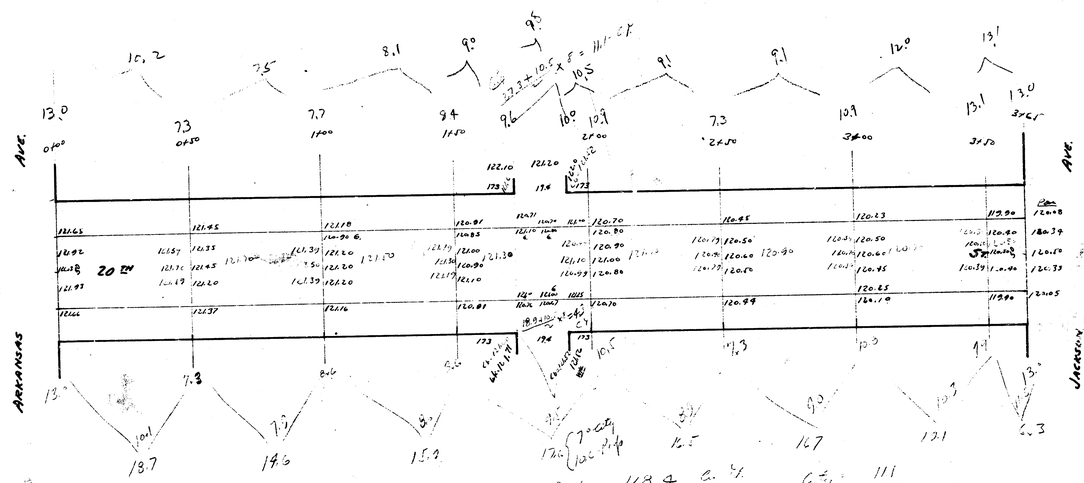20th St. - E.L. Arkansas to W.L Jackson