


PAVING PLAN-----1945.
SEVENTEENTH STREET E.L. FAIRMOUNT
 W.L. VASSAR
 CONCRETE: WIDEN TO 40', & CURB

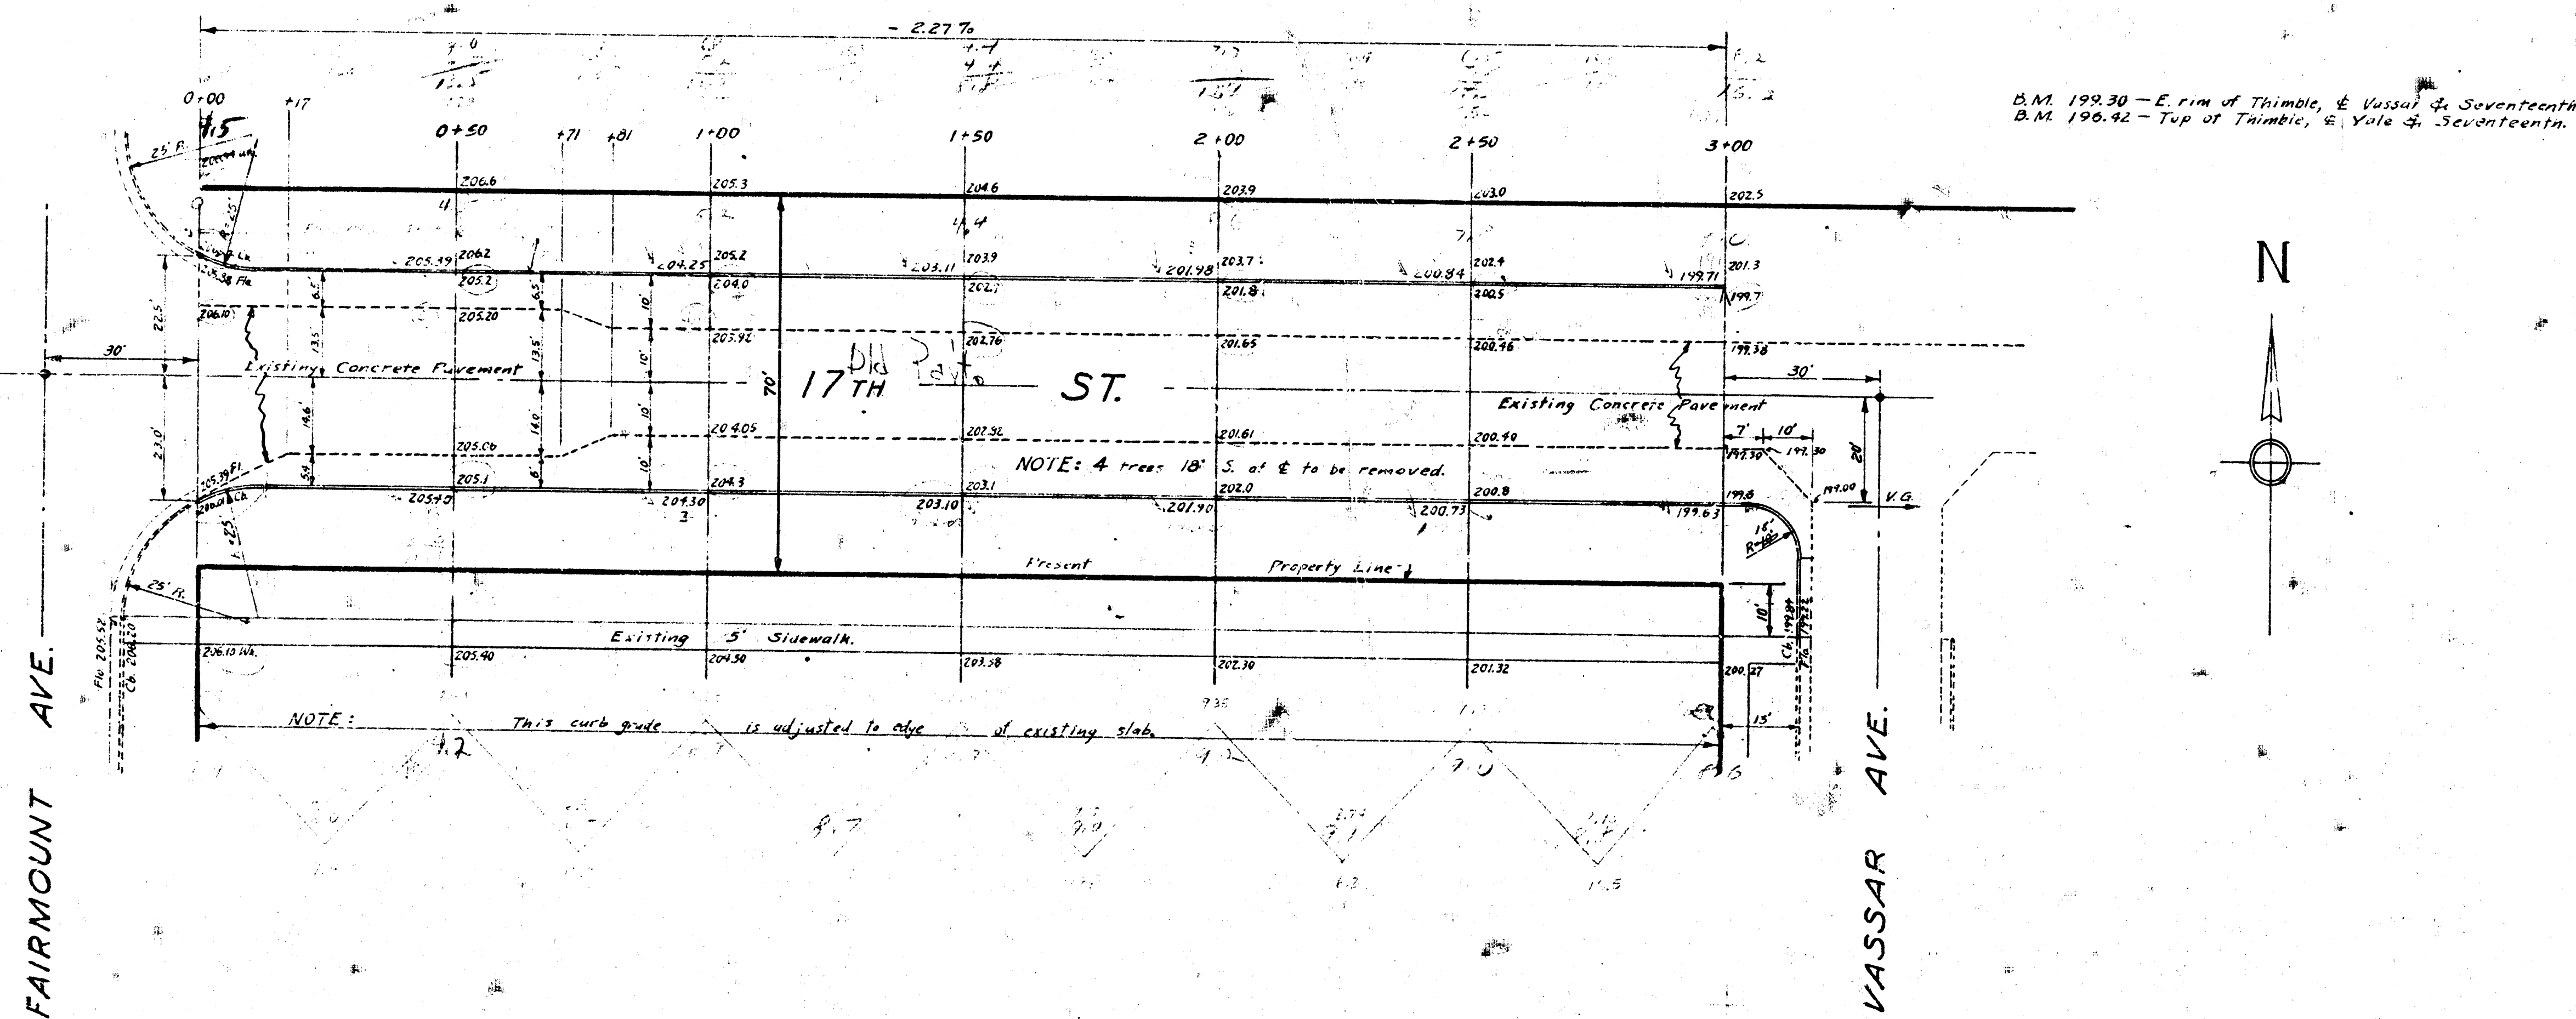

