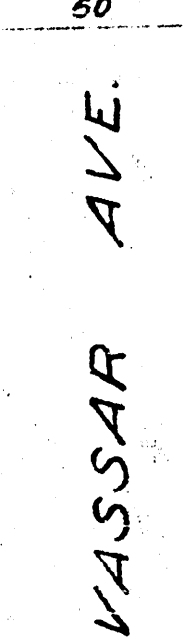



B.M. El.=196.42 - Top of Thimble, E Yale & Seventeenth

[illegible]

DATE 8-25-41
CITY 8.10 AM
CA 2.40 PM