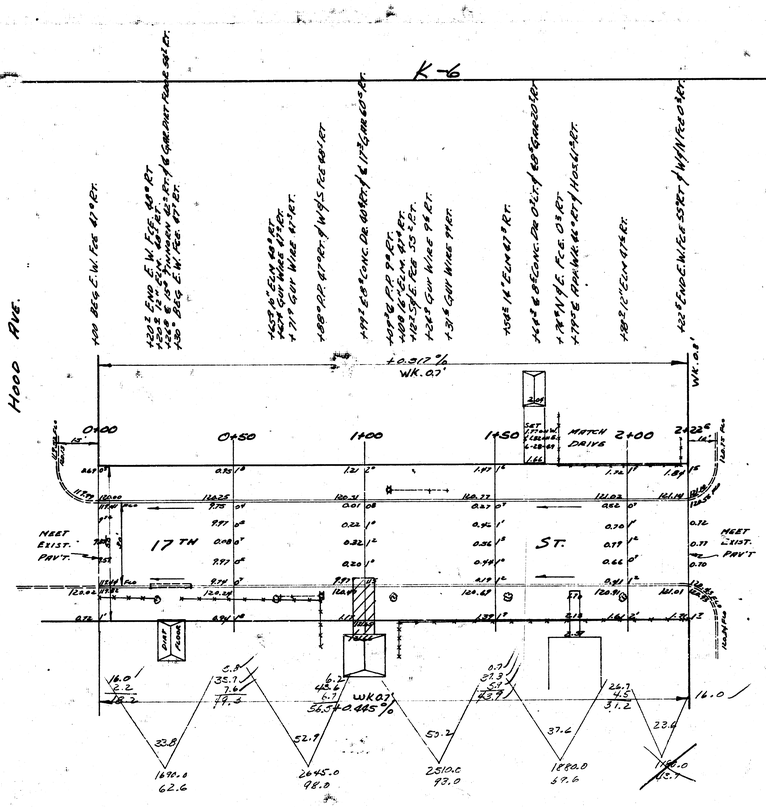
K-6

B.M. S.E. Cor. Conc. Porch, Hos. 3 W. Cor. 18TH & Hood 1284
B.M. Std. N.E. Cor. 17TH & Hood - 1210


HOOD AVE.
PAYNE AVE.
17 TH
ST.
MATCH DRIVE
WK. 0.7'
+0.917%
WK. 0.7'
0+00
0+50
1+00
1+50
2+00
2+22.5
MEET EXIST. PAV'T.
MEET EXIST. PAV'T.
CURB RETURN
CURB RETURN
16.0
16.0
16.0