




Vertical Alignment "As Shown"
Proposed
1968

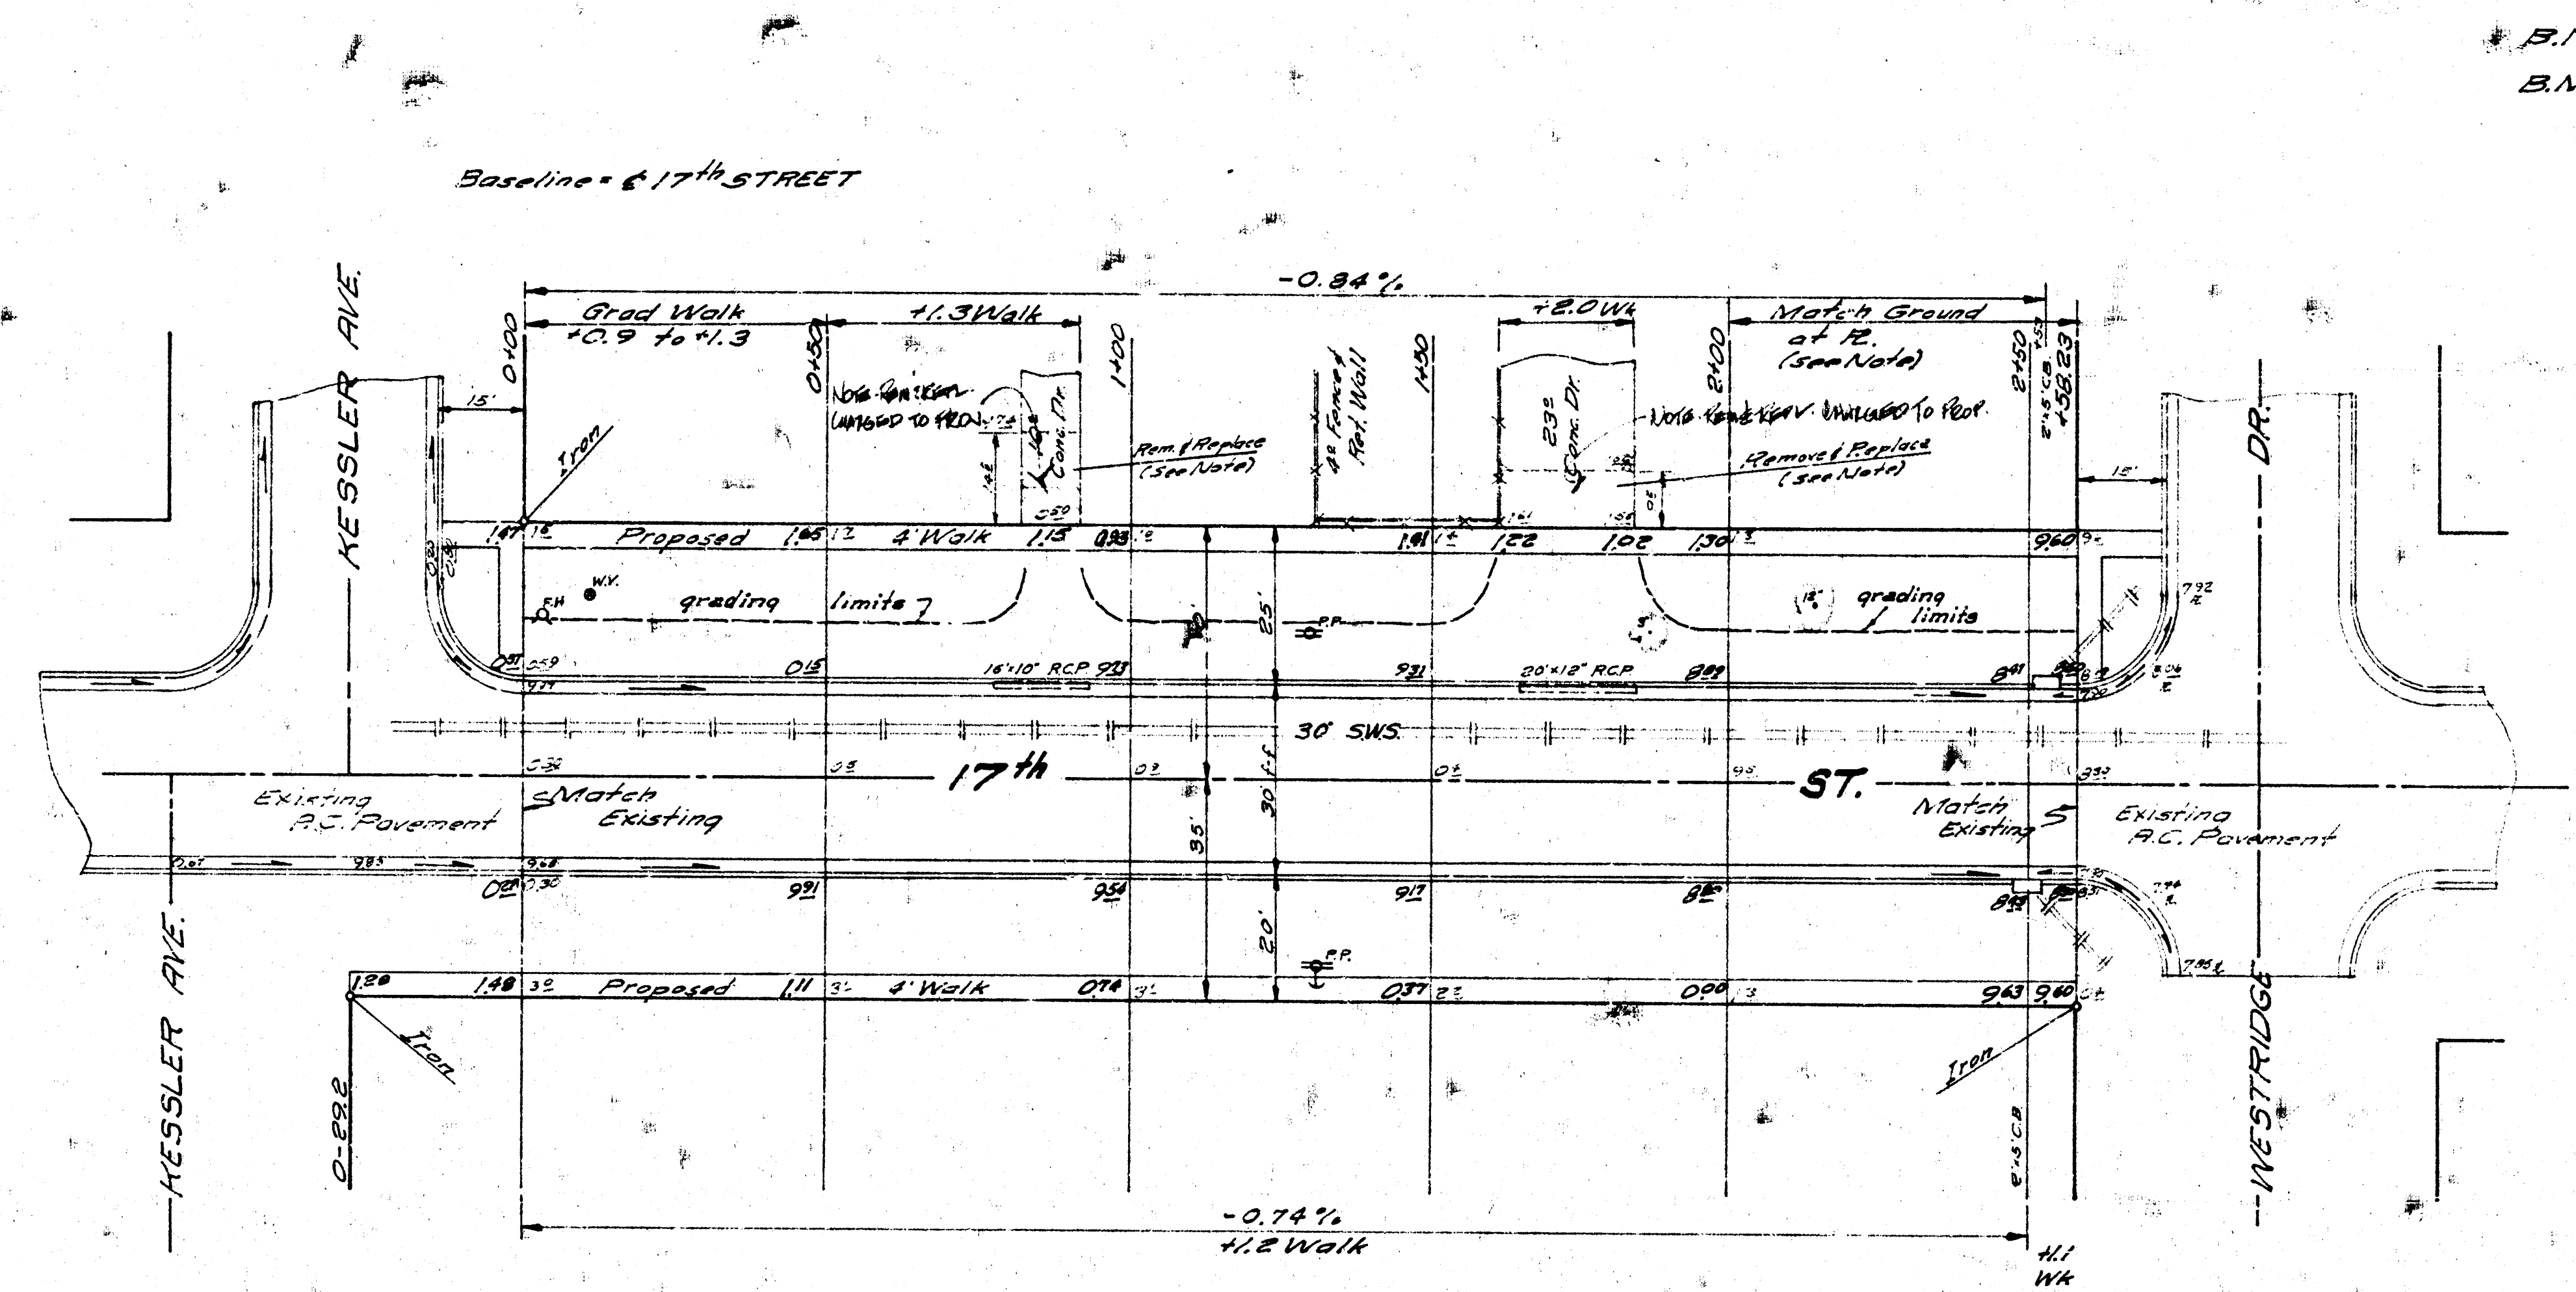


B.M. 128.50 "R" in Right Hand, N.W. Return,
Westridge Dr. 17th St.
B.M. 130.80 "N.W. Con. Pkgs. 3715 W. 17th,
St. Con. High 17th

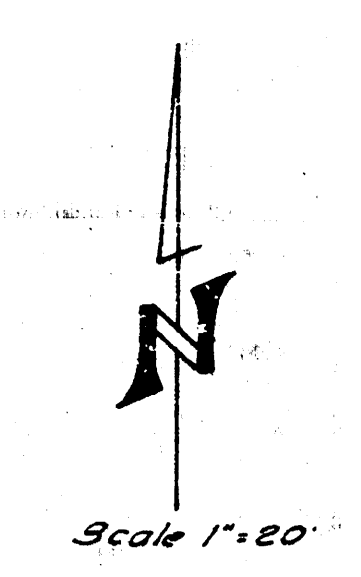

Note:
Contractor to Grade and Clear Parking for
Proposed Sidewalk. Sidewalk to be Constructed
by "OTHERS".
Contractor to Refer to Cross-Sections for
Grading North Side of 17th Street.
Field Engineer to Check with Property Owners
Before Constructing Drives

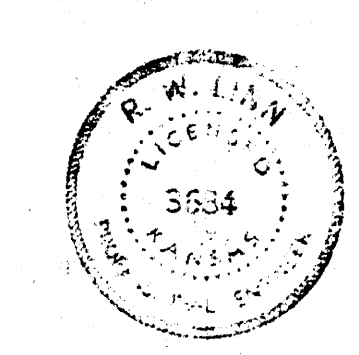

* EARTHWORK QUANTITIES *
Property
Excavation
735.4 C.Y.
110% 808.9 C.Y.

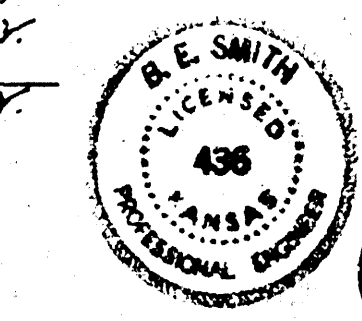

17th STREET
From E.L. KESSLER AVE. NORTH
To W.L. WESTRIDGE DRIVE
26'-2'-30' A.C. & CURB
B.E. SMITH CITY ENGINEER
CITY OF WICHITA, KANSAS
DATE APRIL 1968 C17-97