
B. M., El. 116.37 "M" in Mueller Fire Hydrant, N.W. Cor., 11th & Hydraulic.
B. M., El. 116.23 "M" in Mueller Fire Hydrant, N.W. Cor., 12th & Hydraulic.

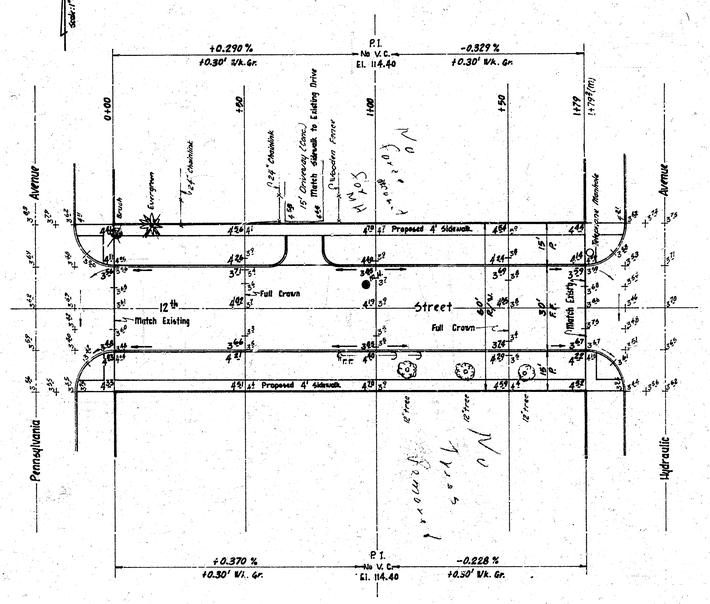

Note:
Contractor to clear, grade and compact fill in R/W. as necessary to construct proposed 4' sidewalk.. Sidewalk to be constructed under separate contract.

Survey: Davis Book: D-1
Plan: Schmitt
Est: Schmitt
Checked:

Earthwork

	Excavation	Compacted Fill
	56.3 C.Y.	109.4 C.Y.
Plus 10 %	5.6	–
Totals:	61.9 C.Y.	109.4 C.Y.

JAMES H. TARDY LICENSED 20.2 PROFESSIONAL ENGINEER

B.E. SMITH LICENSED 436 KANSAS PROFESSIONAL ENGINEER

12th Street East Line of Pennsylvania Ave. to the West Line of Hydraulic Ave.
30' Wide Conc. Pavement, 6" Thk., W/Int. Curb.

City of Wichita, Kansas.
B.E. Smith, City Engineer.
Date : May, 1969. Project No. C19-13
Sheet No. 1 of 2