
B.M. 130.45 S.E. cor. conc. porch. Ho #1653 Sabin.
Baseline & stationing on north property line

Note:
Existing surface shall be removed separately and paid as sq. yds. of surface removed. Volume of surface is included in excavation quantities.

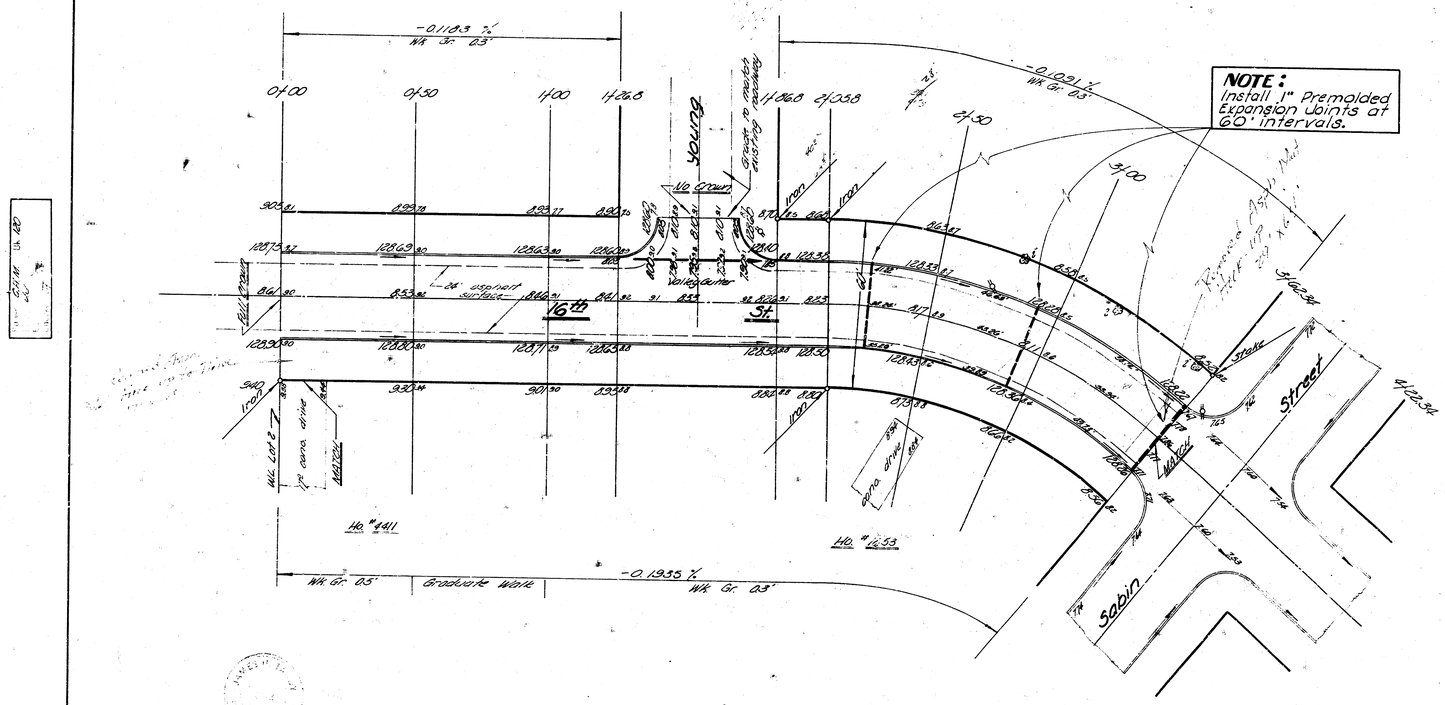



CURVE DATA
Length = 154.54' on N. ℄ R = 222.36'
Δ = 20° 18' 00" Min per ft = 7.72327

Sta	arc	Chord N. ℄	Chord ℄ after ℄ N 25	Chord ℄ after ℄ S 65	Defl.	Σ Defl.
	R=	222.36	215.24	189.36		
2f038						
2f30	44.2	44.13	42.74	33.62	5° 41' 28"	5° 41' 28"
3f00	50	49.89	48.33	38.01	6° 26' 40"	12° 07' 32"
3f62.34	62.34	62.14	60.13	47.34	8° 01' 28"	20° 09' 00"

Excavation

Prop.	C.Y.
429.2	761
42.9	76
472.3	837

B.E. SMITH
LICENSED
435
KANSAS
REGISTERED ENGINEER

16th St.

W.L. Lot 2, Blk 2, N. Lynn 4th Addition to W. Sabin

30' conc. & cb.

B.E. Smith City Engineer
Date: Sept. 1961 Proj. No. C11-32