
Note: Paving contractor to clear right of way, grade parkings and construct compacted fill for proposed sidewalk. Sidewalk to be constructed by others.

Note: Adjust walk on north side to match exist. ground if driveways are not constructed

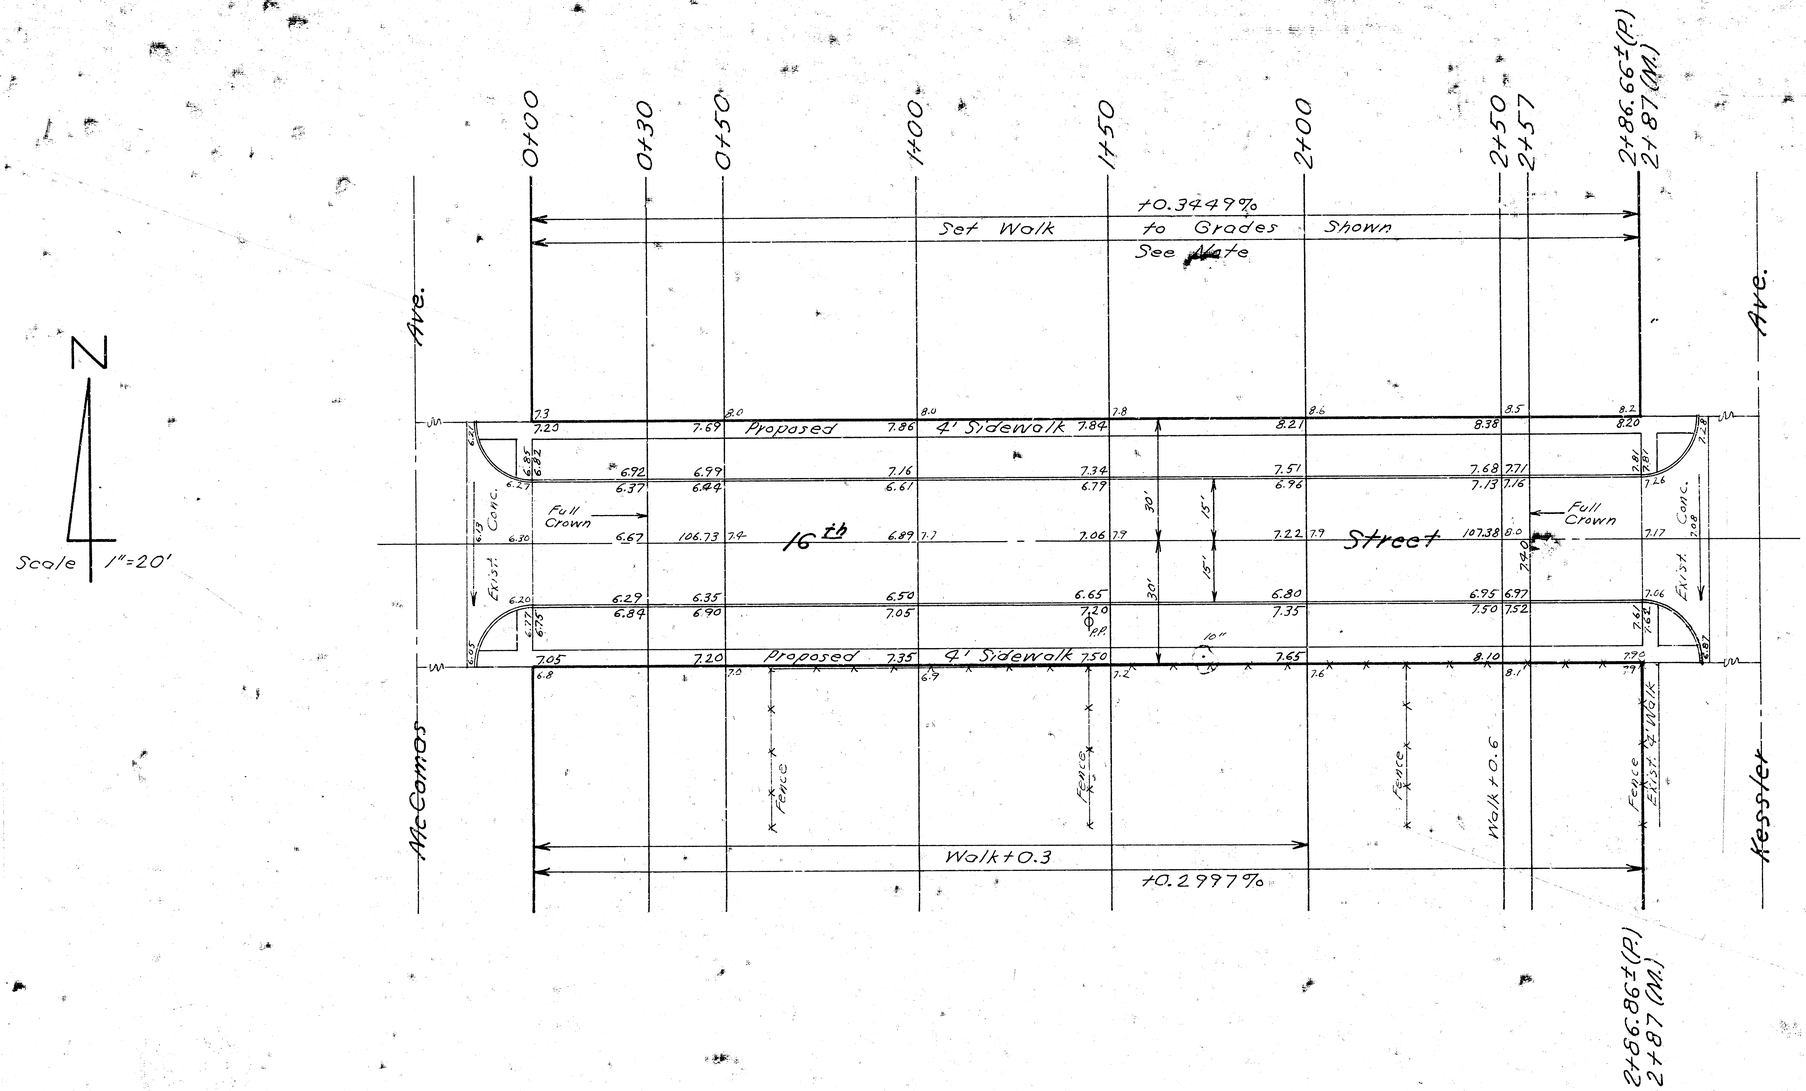

N

Scale 1"=20'

B.M. 127.74 N.E. corner conc. step house no. 1631 N. Kessler.

Earthwork
Property
412.4 ~~219.9~~ + 21.4 = 235.3 C.Y. Excavation
11.8 ~~5.8~~ + 0.6 = 6.4 C.Y. Comp. Fill
175.3 175.4 C.Y. Comp. Fill S.G.M. for Pavement Subgrade

1/2

16th. STREET
E. L. McComas to
W. L. Kessler
30' CONCRETE
CITY OF WICHITA, KANSAS
B. E. SMITH, CITY ENGINEER
PROJ. NO. C 10-26
DATE: Sept 1970