


D.M. 119.16 Sta. N.E. Cor. 17th & Arkansas
D.M. 119.54 Iron in Thumb 4 Jackson No. N.E. 16th

NOTE: REMOVE AND REPLACE APPROX 30' OF EXISTING P.V.T. FLATTEN CROWN FOR APPROACH TO VALLEY GUTTER

NOTE: REMOVE CROSS WALKS AT E. SIDES OF INTERSECTION.

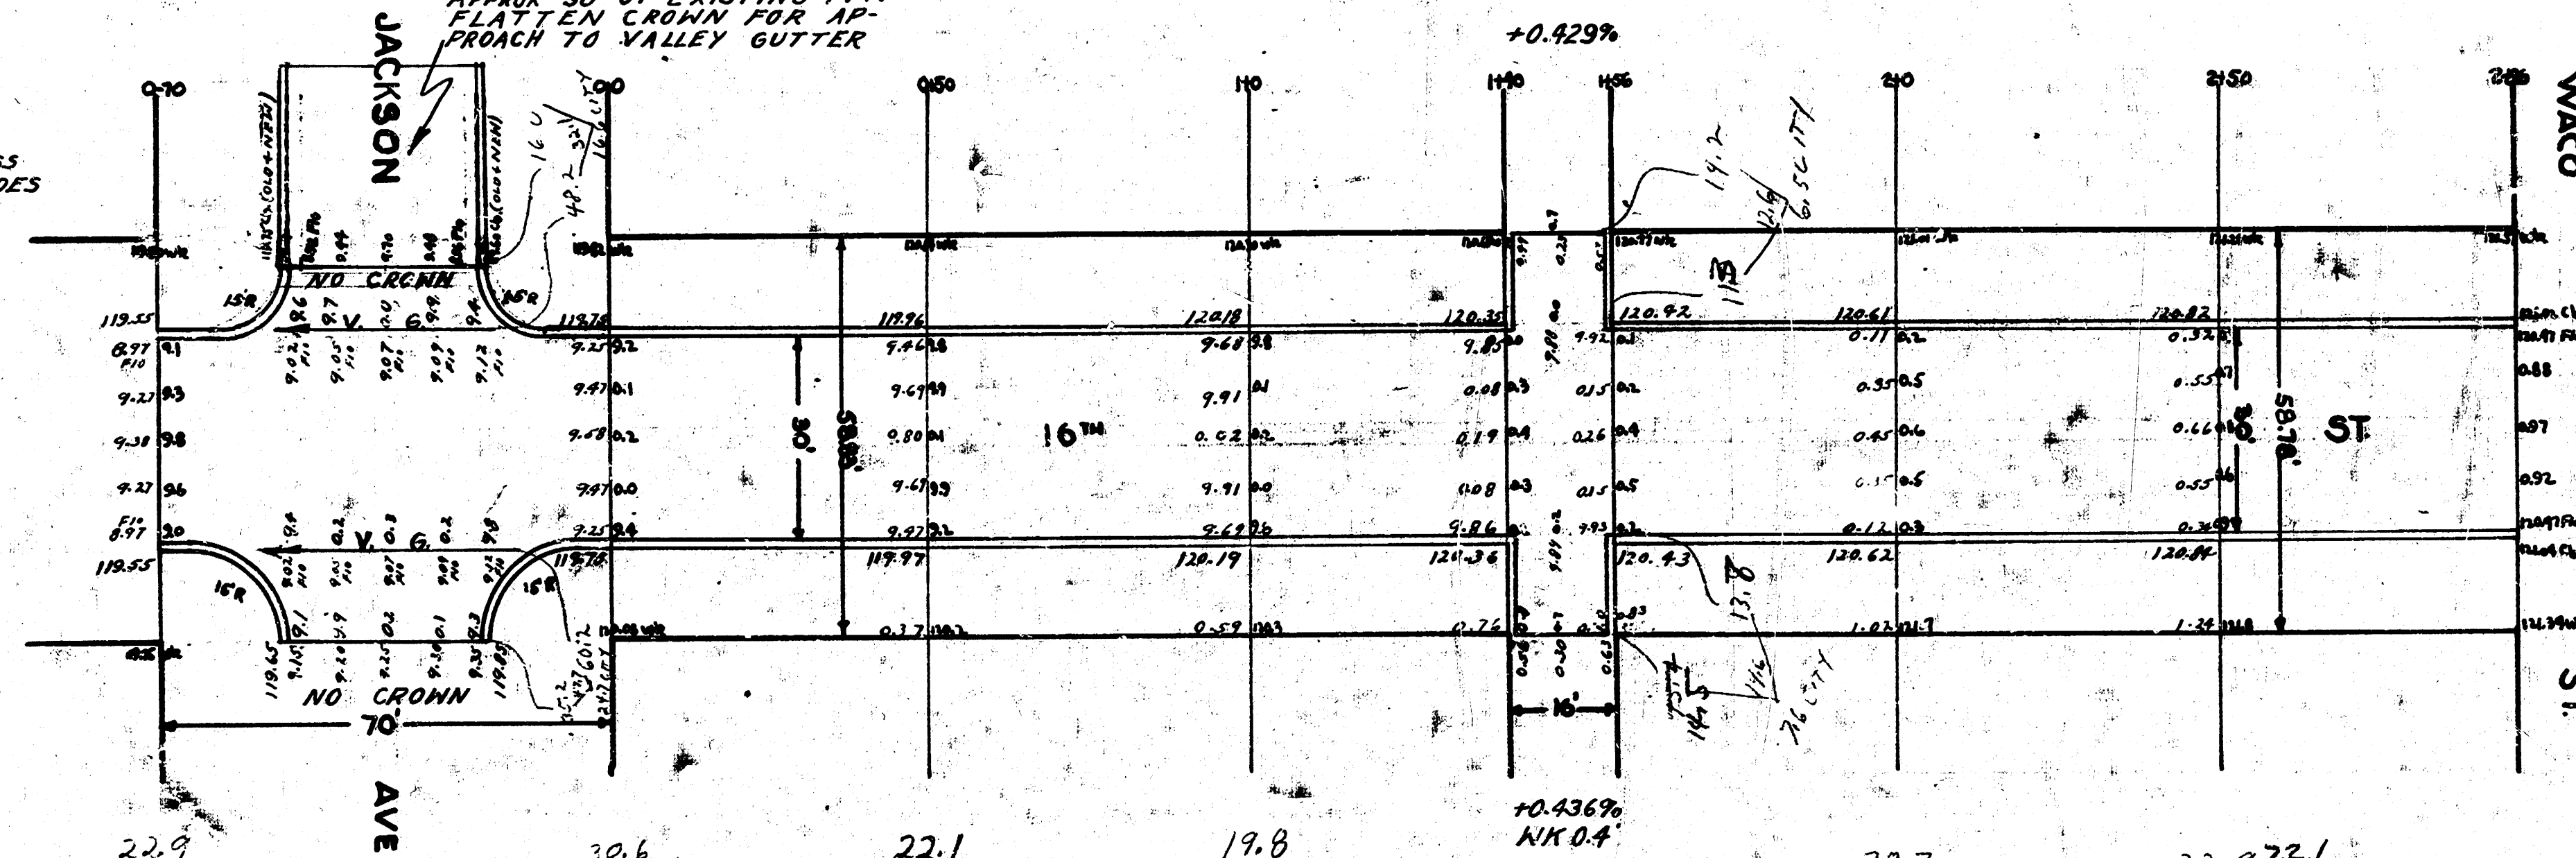

NOTE: REPLACE BROKEN CB & STR IN RETURN.

P.M.P.	51.7
42.7	69.5
28.7	13.5
21.9	7.6
35.0	6.5
44.3	16.6
36.8	24.7
235.4	132.4
4147	235
256.9	13.8
	152.2

16th ST.
W.L. WACO TO W.L. JACKSON
30' CONCRETE & CB.
CITY OF WICHITA, KANSAS
L.K. WHITE CITY ENGINEER
Aug. 1946