

Survey KRAUS
Plan JEZ
ENG JEZ

[illegible]

+135 214' *ET* TO CLUMP SMALL ELMS
 +39 255' *ET* TO CLUMP SMALL ELMS
 +45 228' *ET* TO CLUMP SMALL ELMS
 +52 181' *ET* TO DEADEND
 +58 235' *ET* TO CLUMP SMALL ELMS
 +55 W. L. KANSAS
 +65 222' *ET* TO CLUMP ELMS
 +73 158' *ET* TO POWER POLE (KGA#)
 +90 160W & 1/2 *ET* KANSAS

2425 E.L. KANSAS

+49.5 3 1/2' LT. TO 800' CONC. DRIVE
+60 230' LT. TO WATER METER

20.0' EX TO WATER METER
+21 17.8' EX TO & OF 12"x12" MCP ENT. PIPE
+21 30.5' EX TO & OF 8.9' CONC. DENE

+32 228' LT. TO WATER METER
+41 128' RT. TO 36" BRICK WK.
+47 218' RT. TO 2" IRON

+65 W.L. ALLI NORTH & SOUTH
+66 143' BY 70 POWER POLE
+66 348' BY 70 DEADMAN

485 E. ALLEY NORTH & S.

+95 128' EX TO 18" TREN

+95 128' EX TO 18" TEST
+95 156' EX TO JEREMAN & CLUMP SMALL FILMS


4+1/2 1/2 9' 1/2 TO 17' 1/2 18" METAL FLEX PIPE

4+13 189' L.R. TO & 17'x18" METAL ENT. PIPE

26

5+25 W.L. MINNEAPOLIS


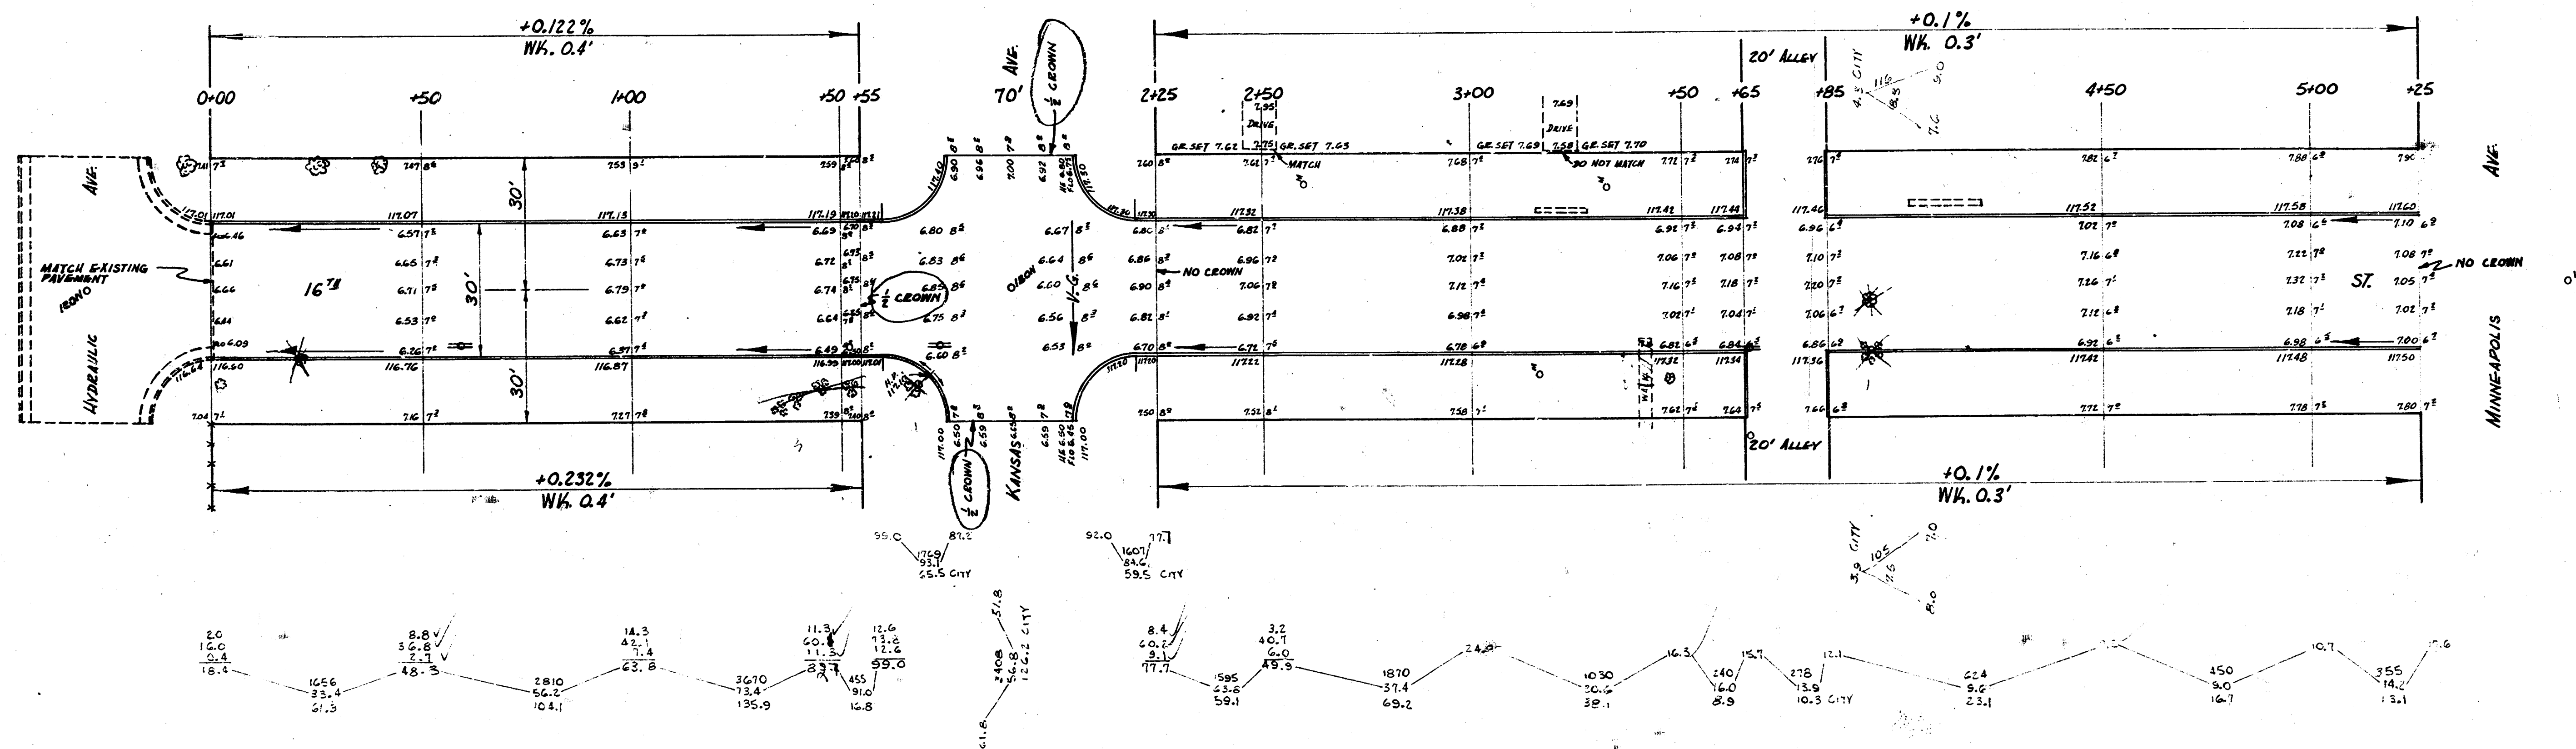

Clumps of trees
scattered & small trees.

TOTAL EXCAV.	
PROP.	CITY
546.3	809.7
+10% 54.6	+10% 80.9
600.9 Cu.Yd.	890.6 Cu.Yd.



16TH ST.
E.L. HYDRAULIC - W.L. MINNEAPOLIS
30' CONC. & CB.
CITY OF WICHITA, KANS.
B.E. SMITH CITY ENGINEER
APRIL, 1954 PROJ. NO. C 14 - 4