


1941
14TH ST. EL VASSAR TO 150 FT EAST OF VASSAR
COMB CURB & GUTTER

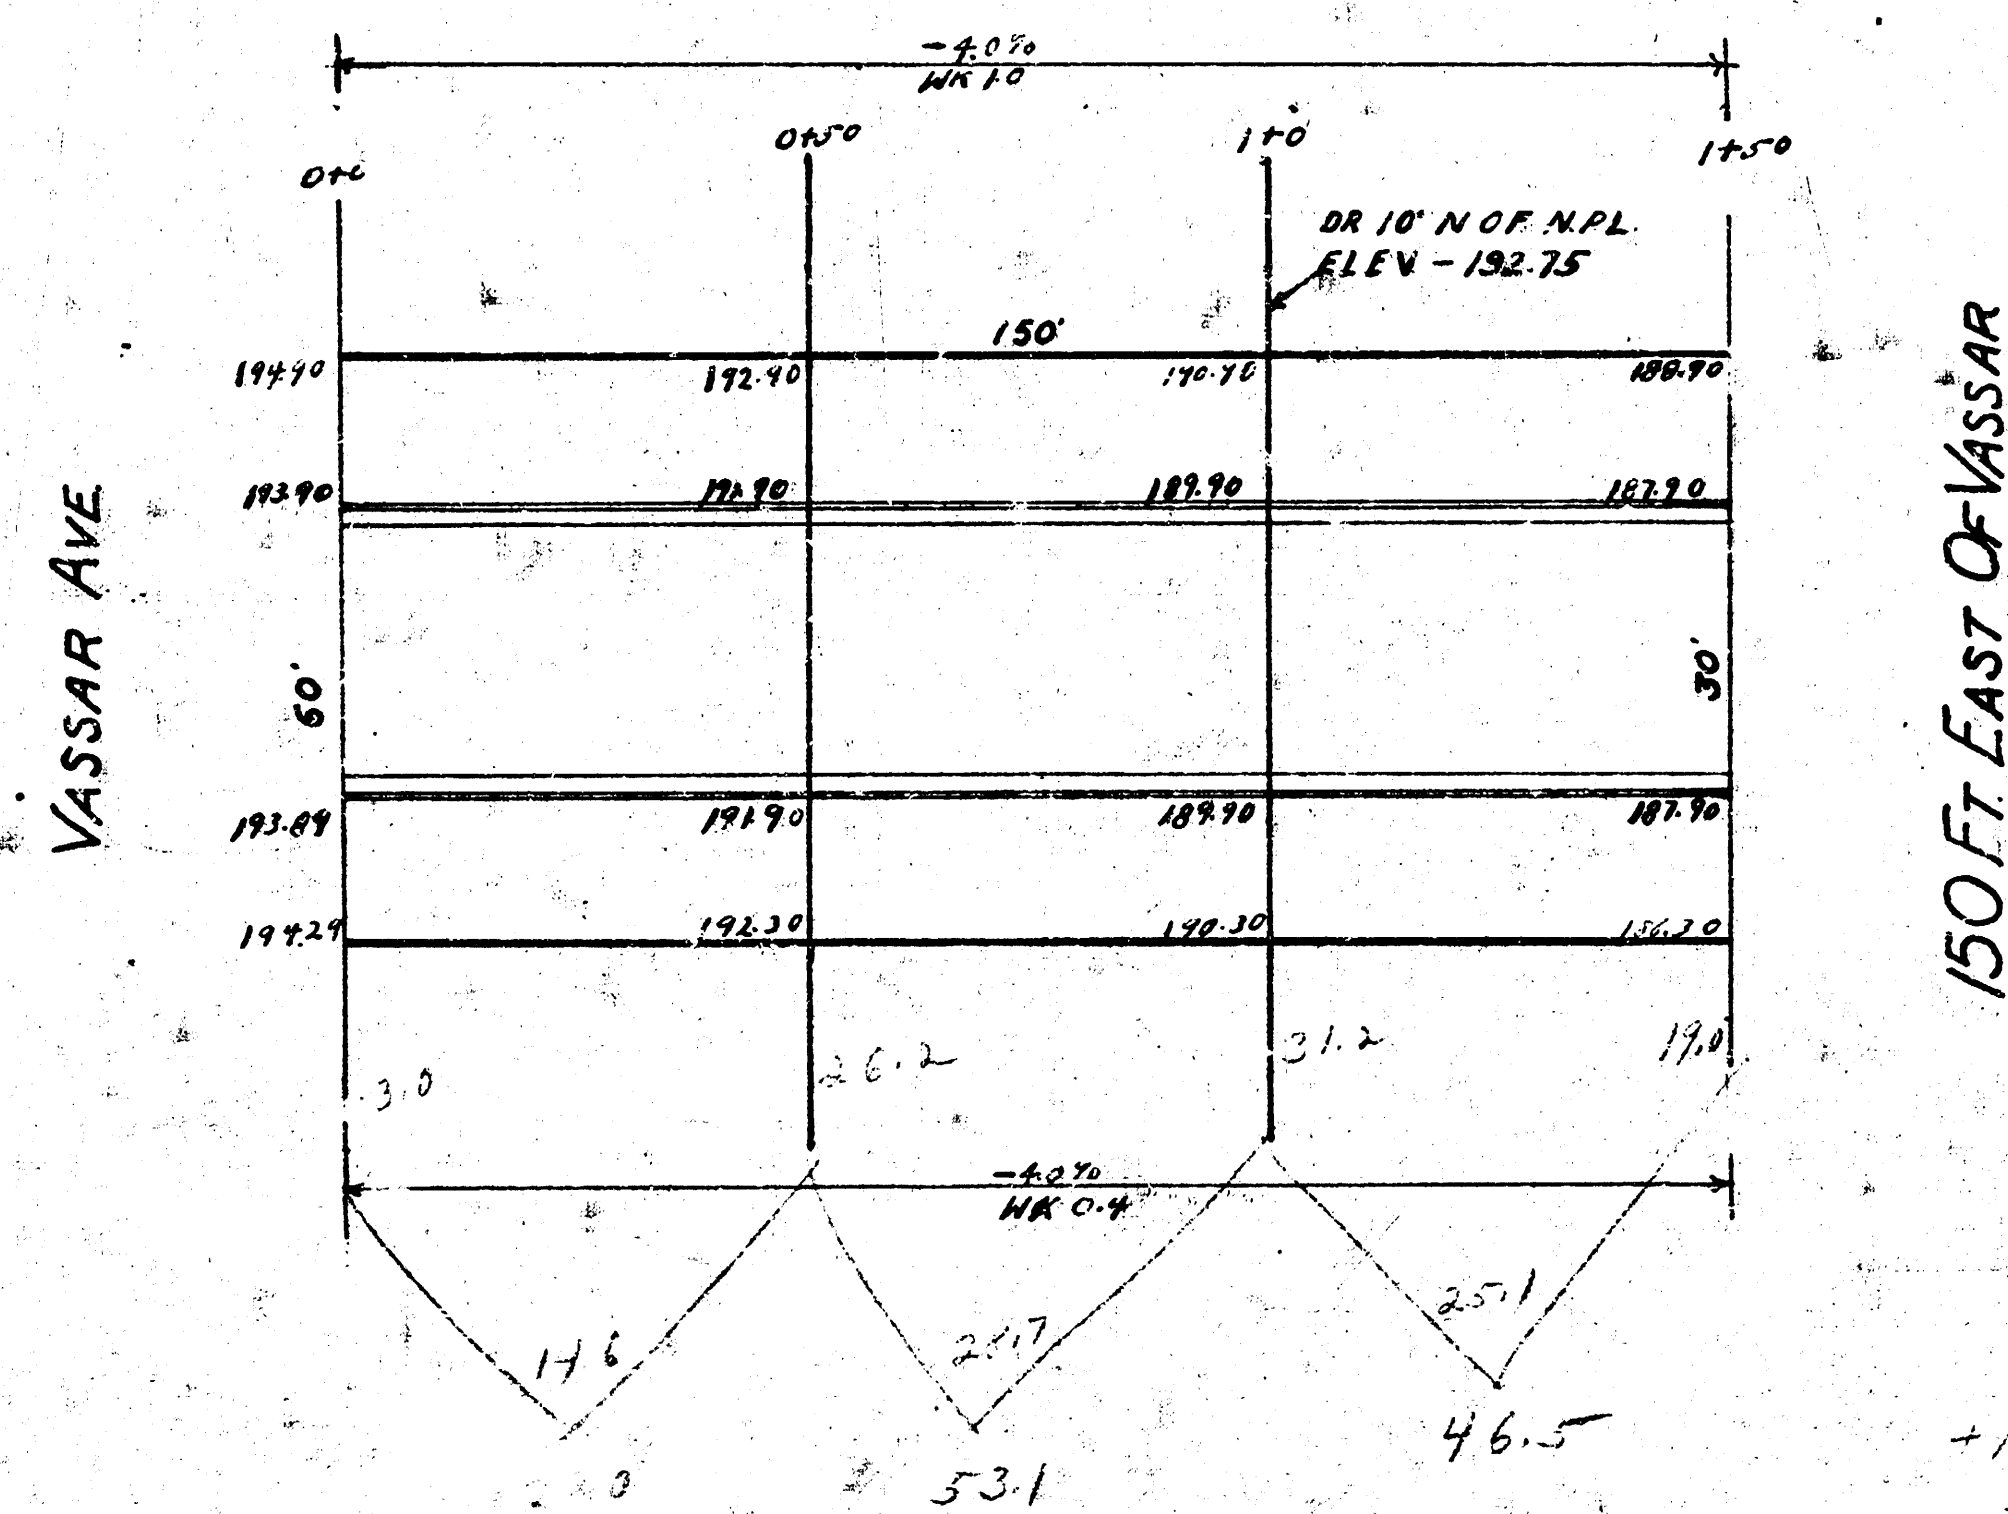

150 FT EAST OF VASSAR

Prop
27.6
52.1
46.5
126.2
+1970 12.7
Total 139.3

BM 19437 W IN WILSON BR OF WK NE COR 14TH + VASSAR

5.07
33.5
1.75
30
15.70