


B.M. 117.03 "G" in Globe L. Co. Pennsylvania, S.L. 154
 NOTE: Chaining on & from East to West

TIES TO IRONS:
 15th & New York
 75.25' S.W. to center 5" Elm.
 51.80' E.N.E. to nail in S.S. RR
 15th & Pennsylvania
 69.00' N.E. to S.W. cor. of conc. pillar support
 S.W. cor. porch Ho.

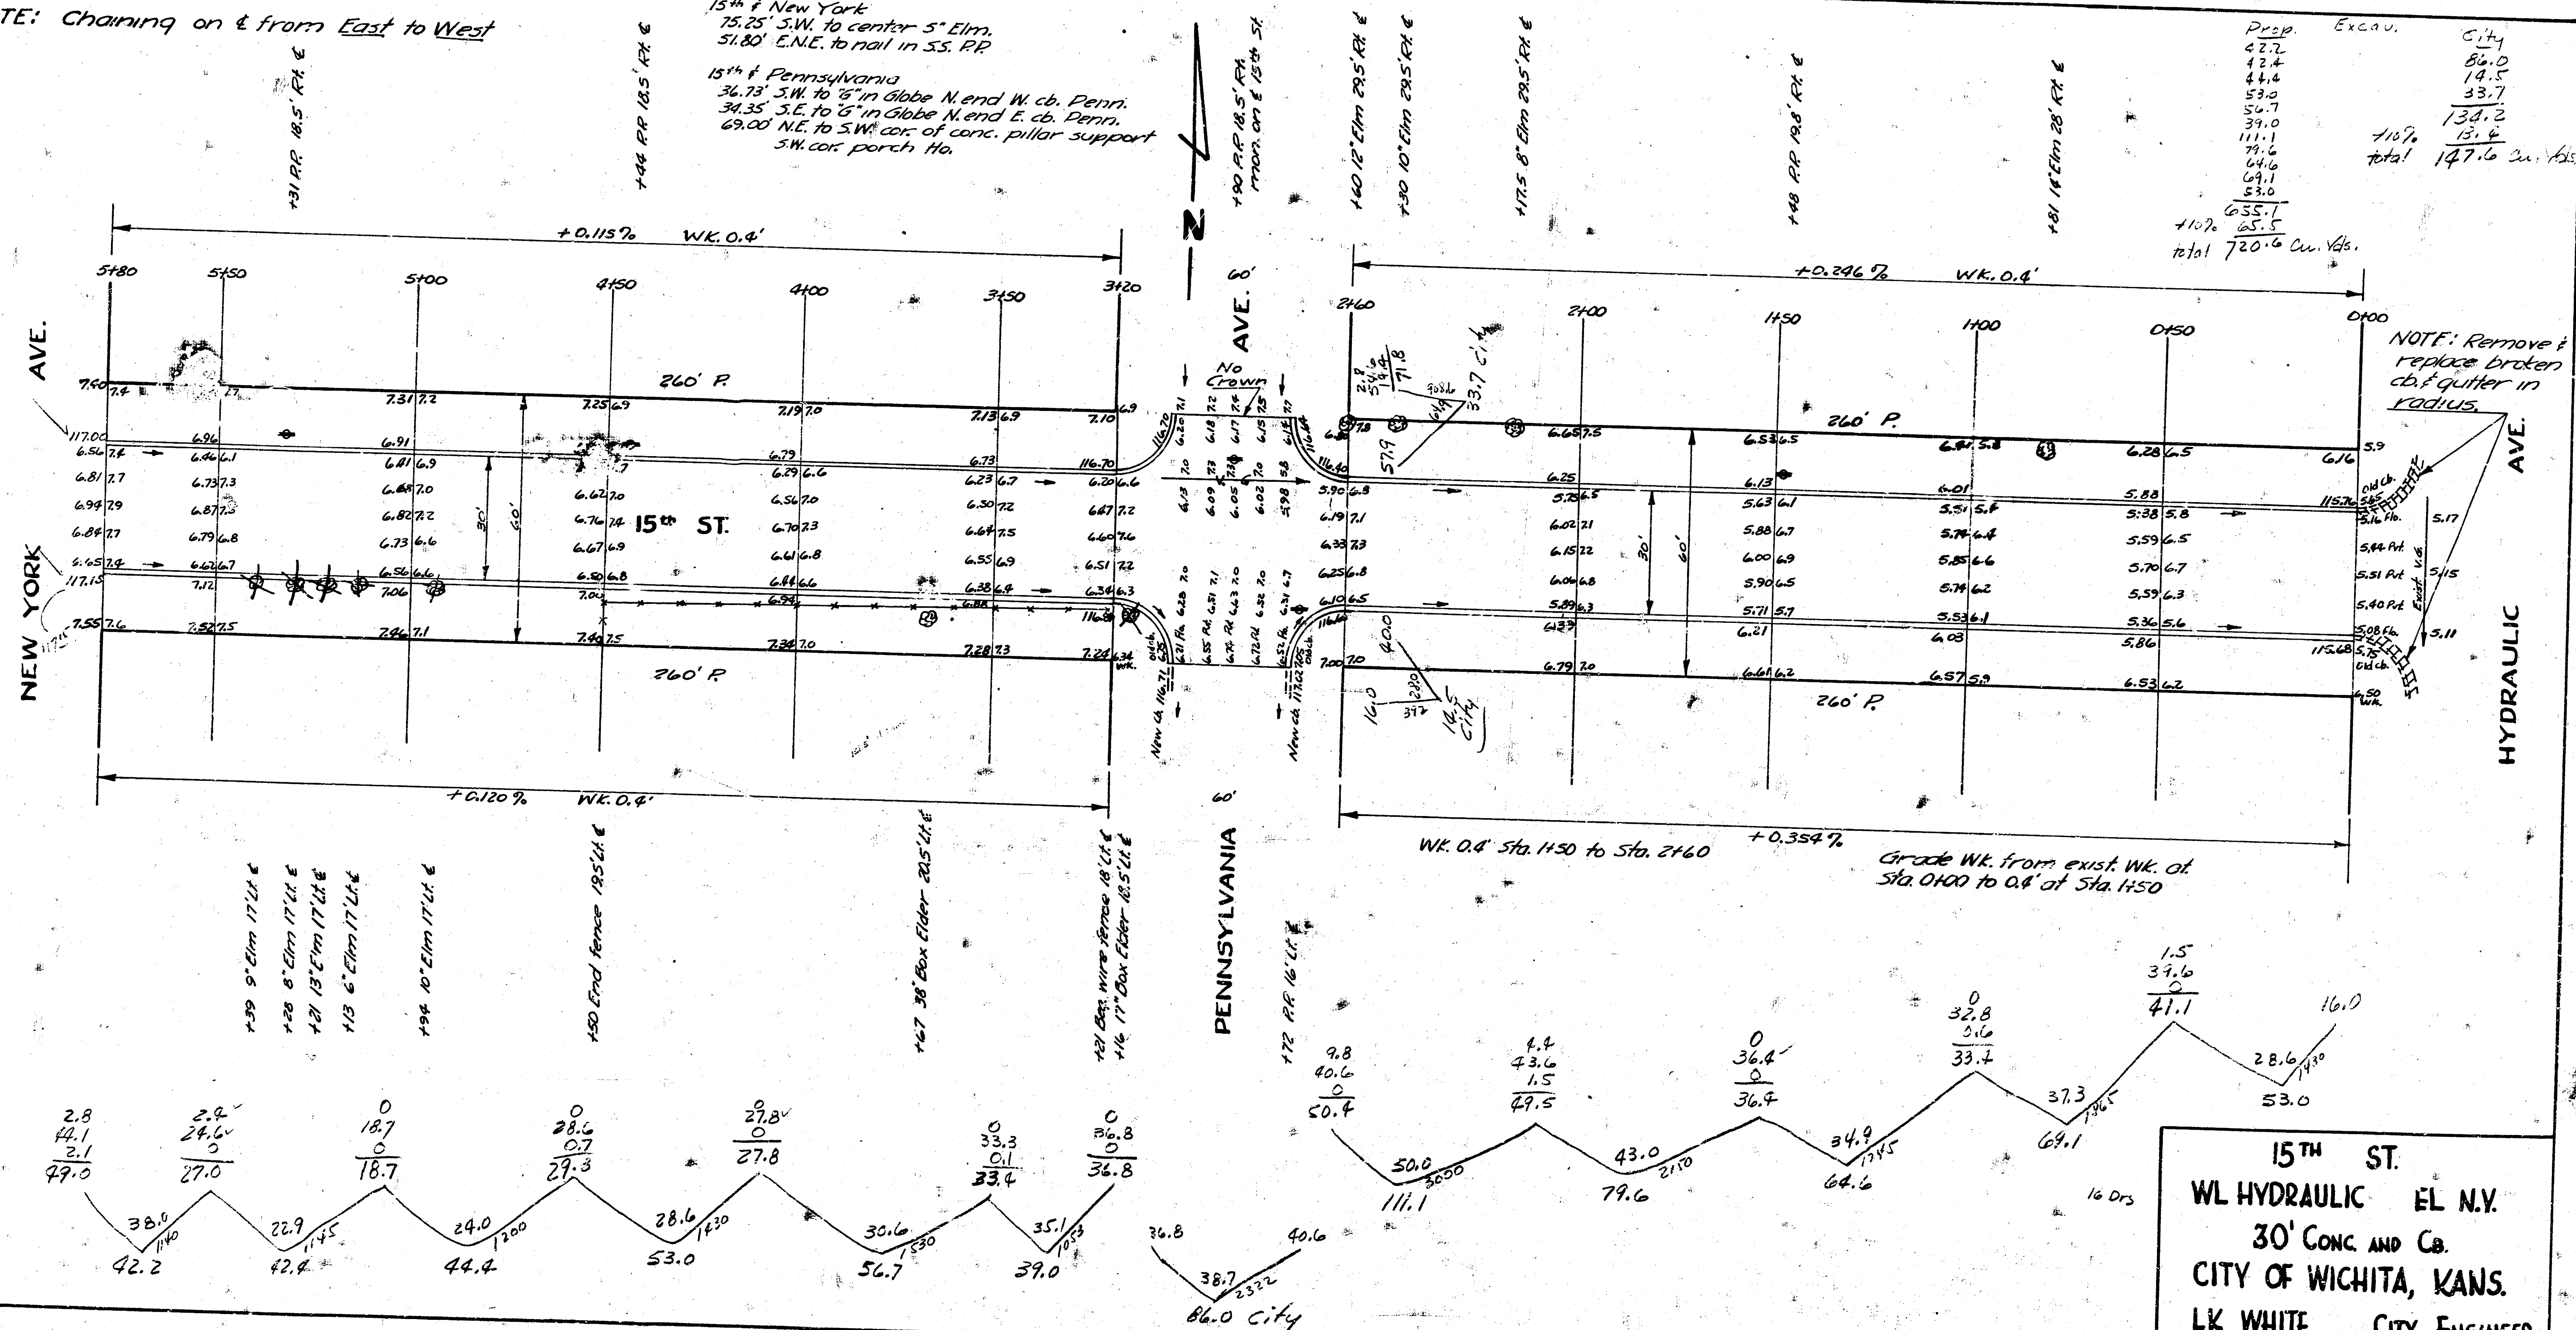

15th ST.
 WL HYDRAULIC EL. N.Y.
 30' CONC. AND Cb.
 CITY OF WICHITA, KANS.
 LK WHITE CITY ENGINEER
 MAY, 1950 PER No. C10-38