


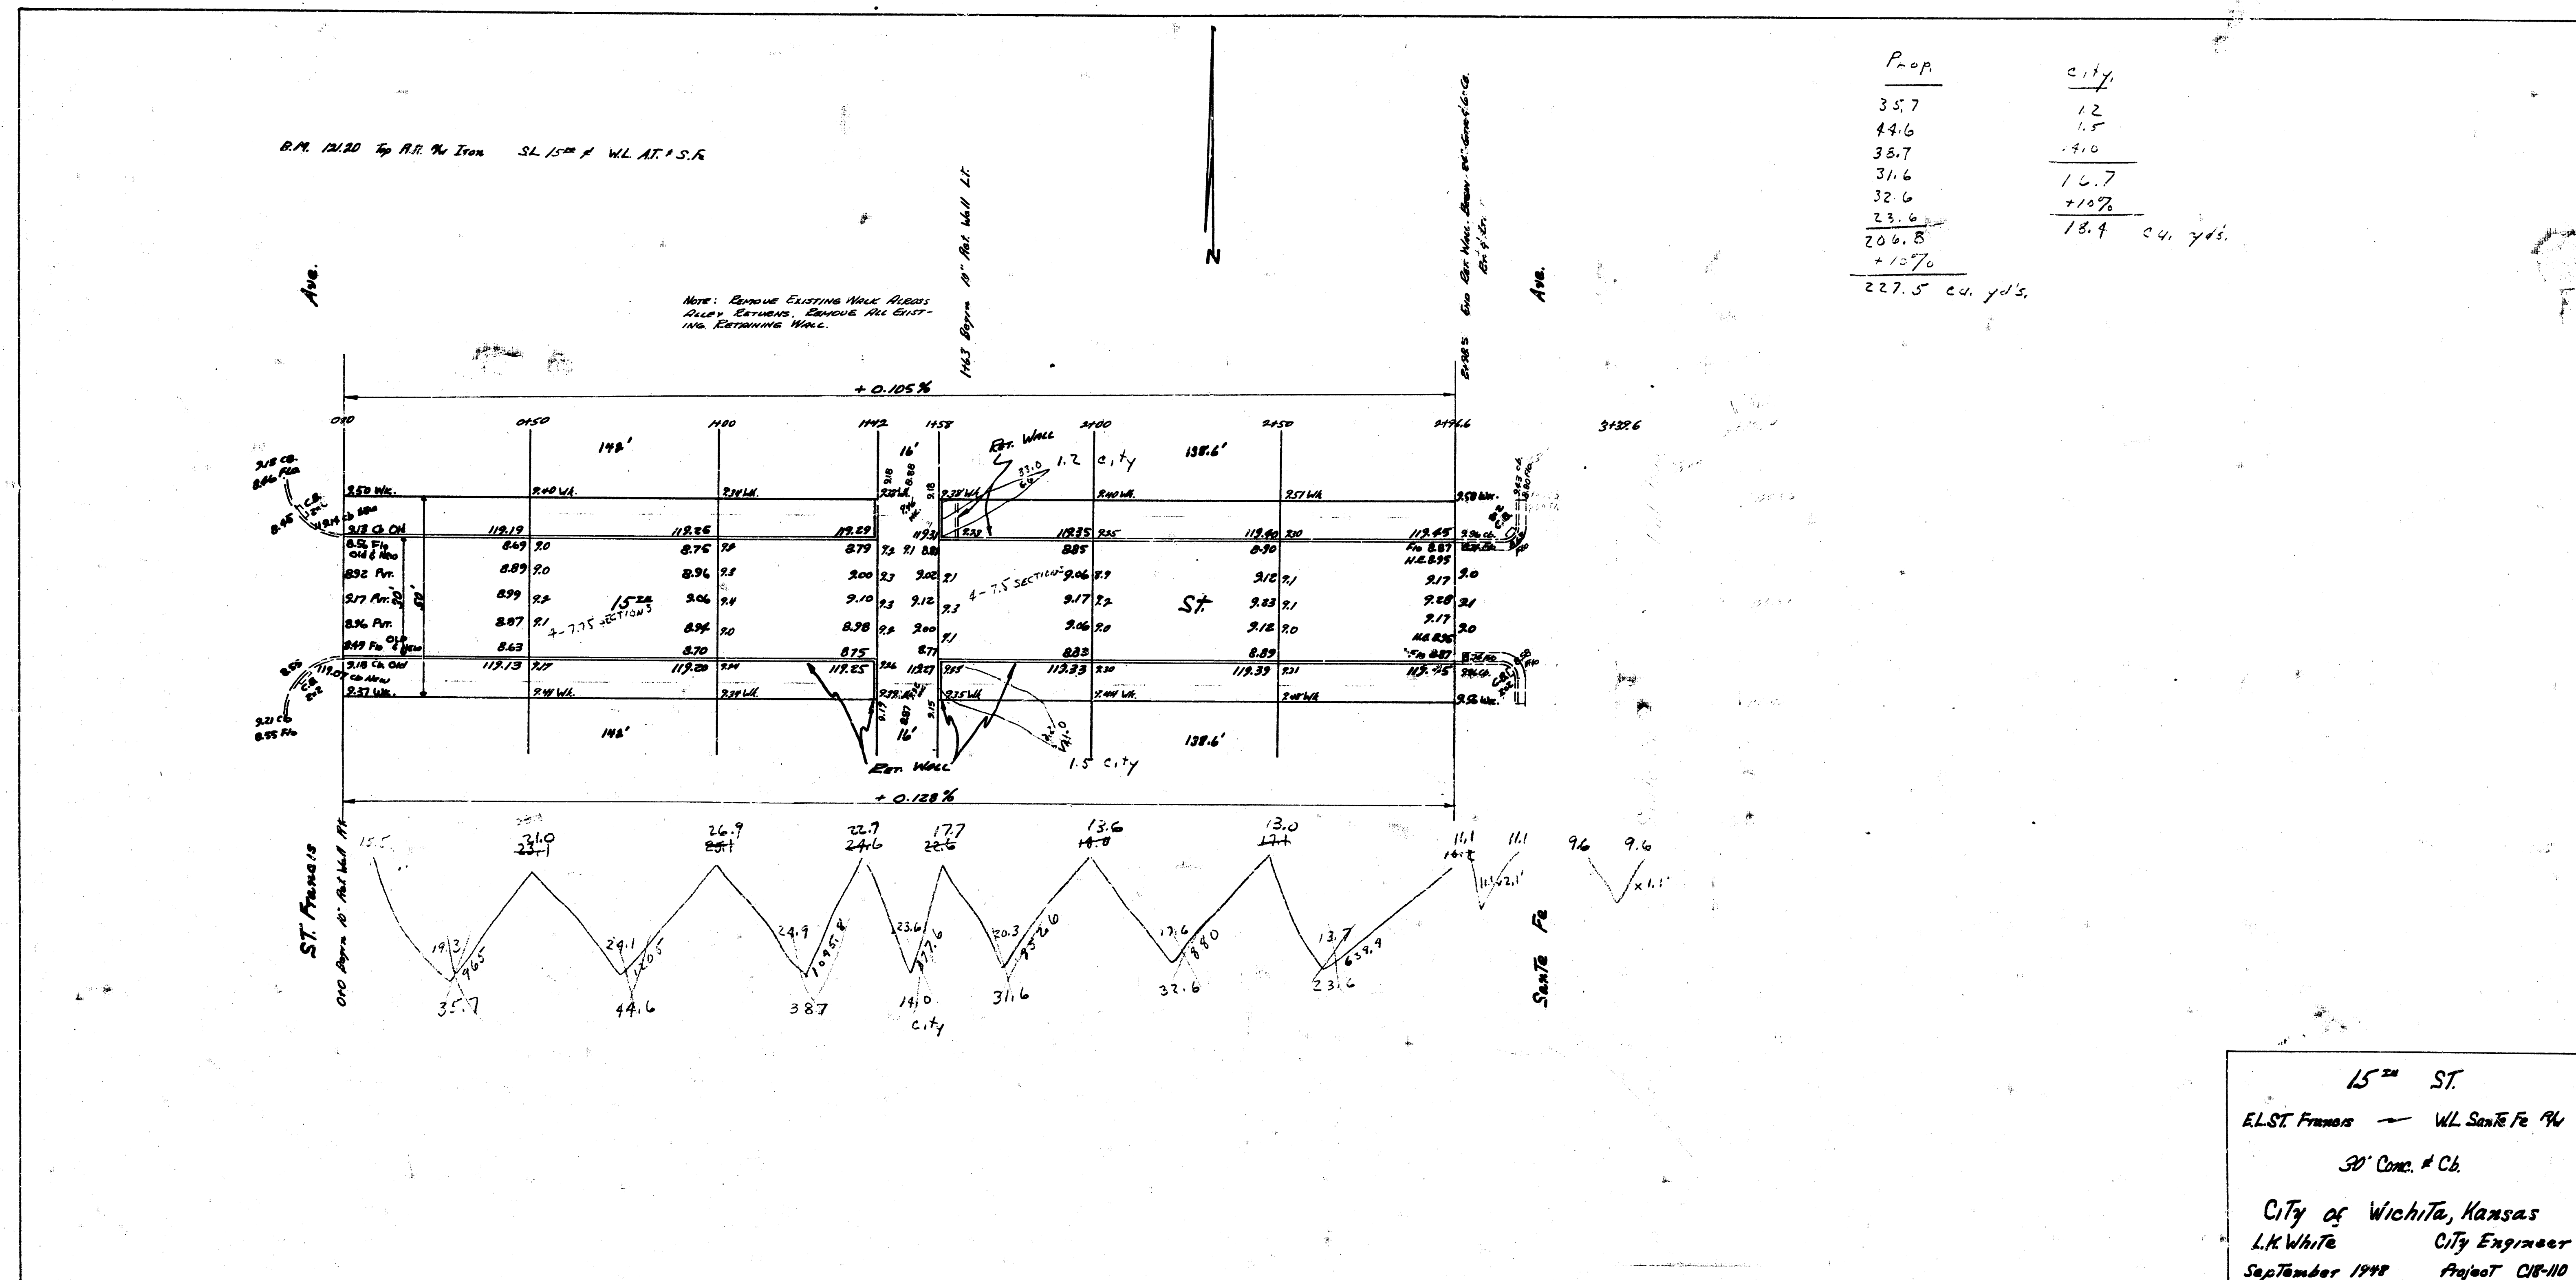

4 12 1 1