


THIRTEENTH STREET

FROM W.L. BITTING AVE. TO (RT.) BANK LITTLE ARKANSAS RIVER

B.E. SMITH CITY ENGINEER CITY OF WICHITA KANSAS

PROJECT NO. C15-53

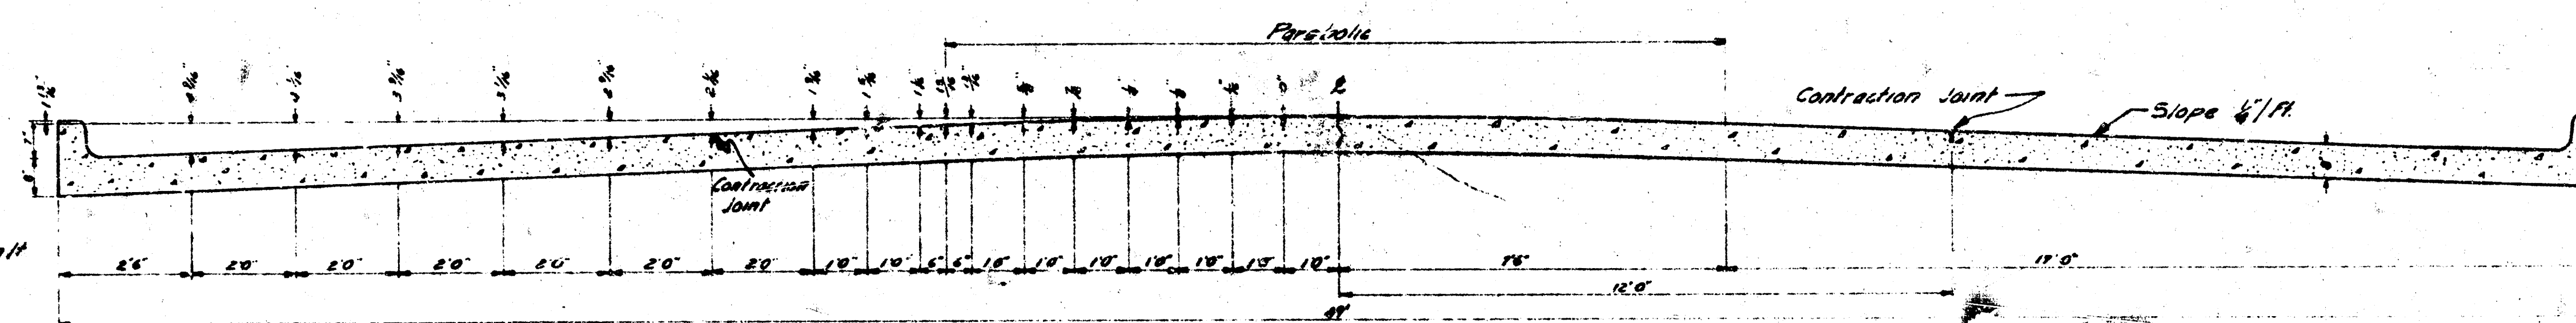


TYPICAL SECTION

No Scale

CONTRACTION JOINT

No Scale


To Be Used At 30' Intervals
Except Where An Expansion
Joint Is Used

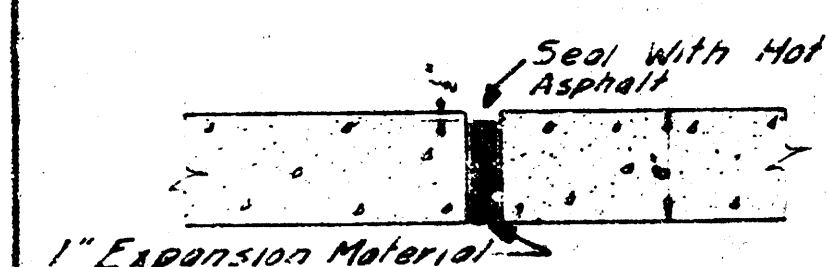

EXPANSION JOINT

No Scale

To Be Used At 120' Intervals

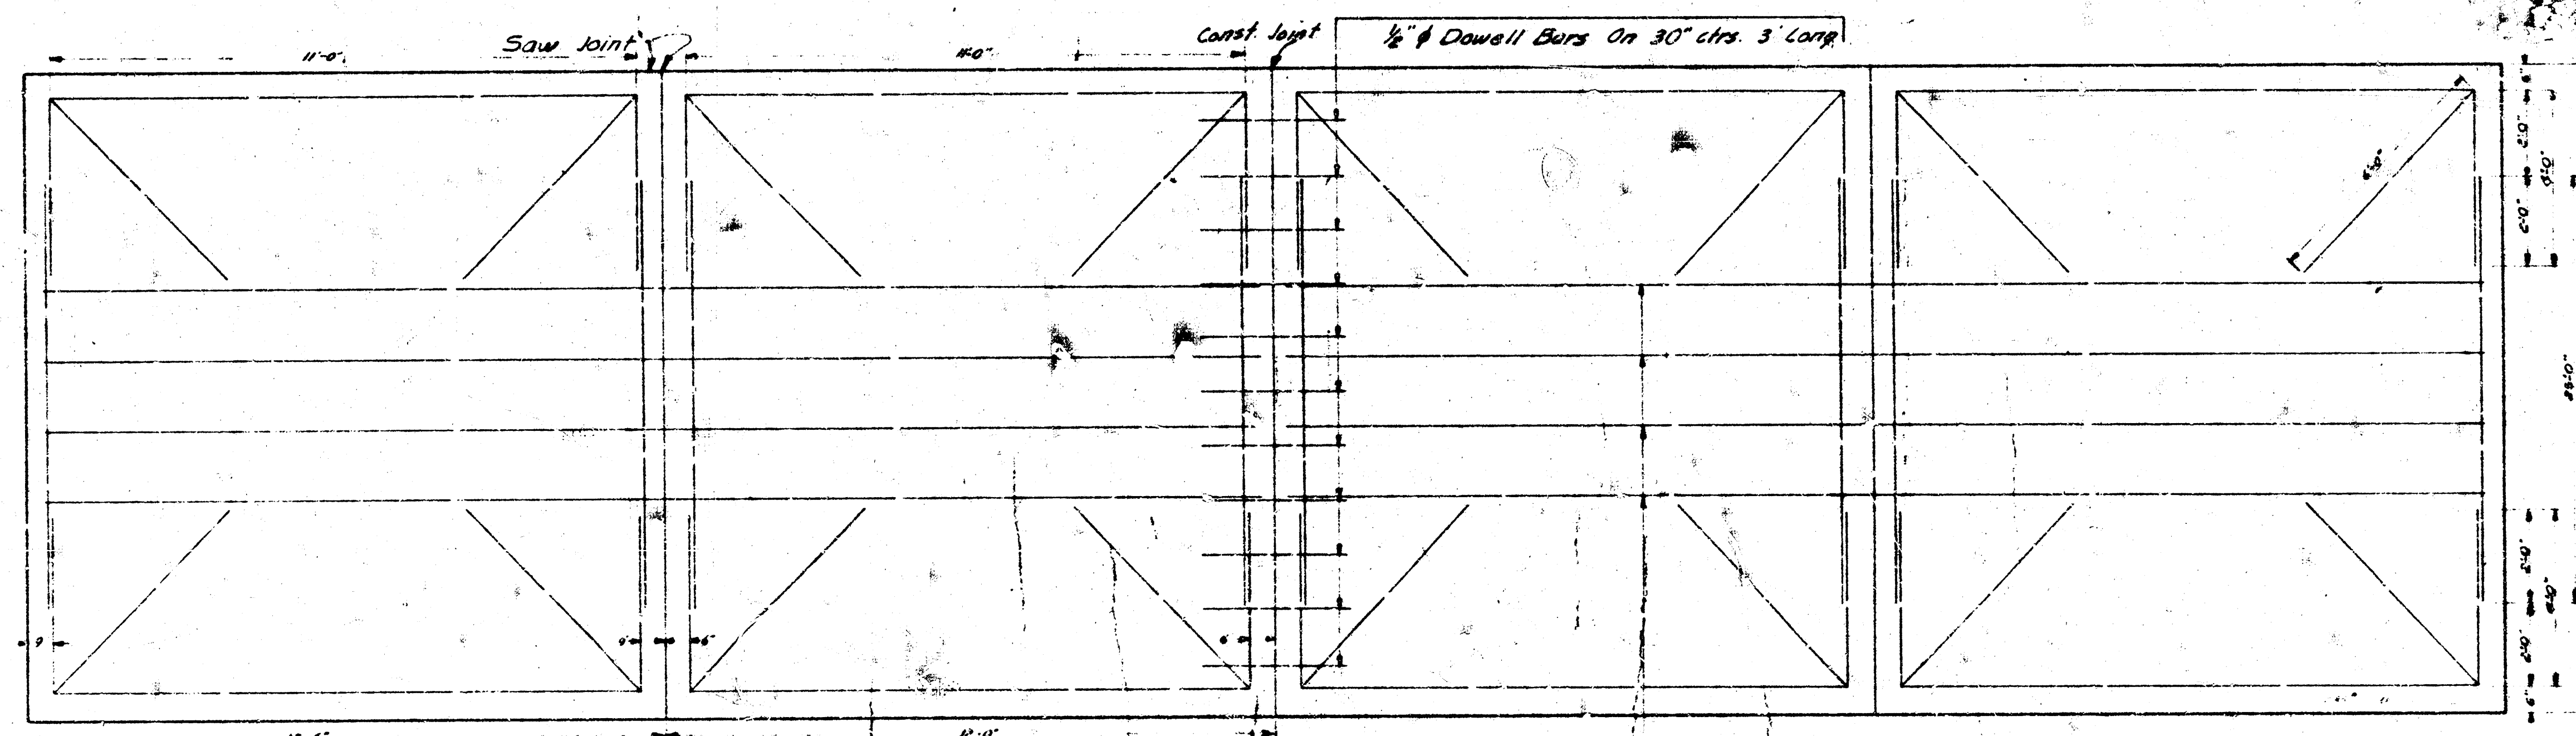


STEEL PATTERN


No Scale

Use 3/8\"/>

4 - 3/8\"/>

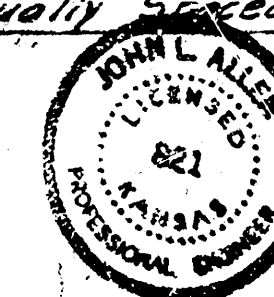

1/5

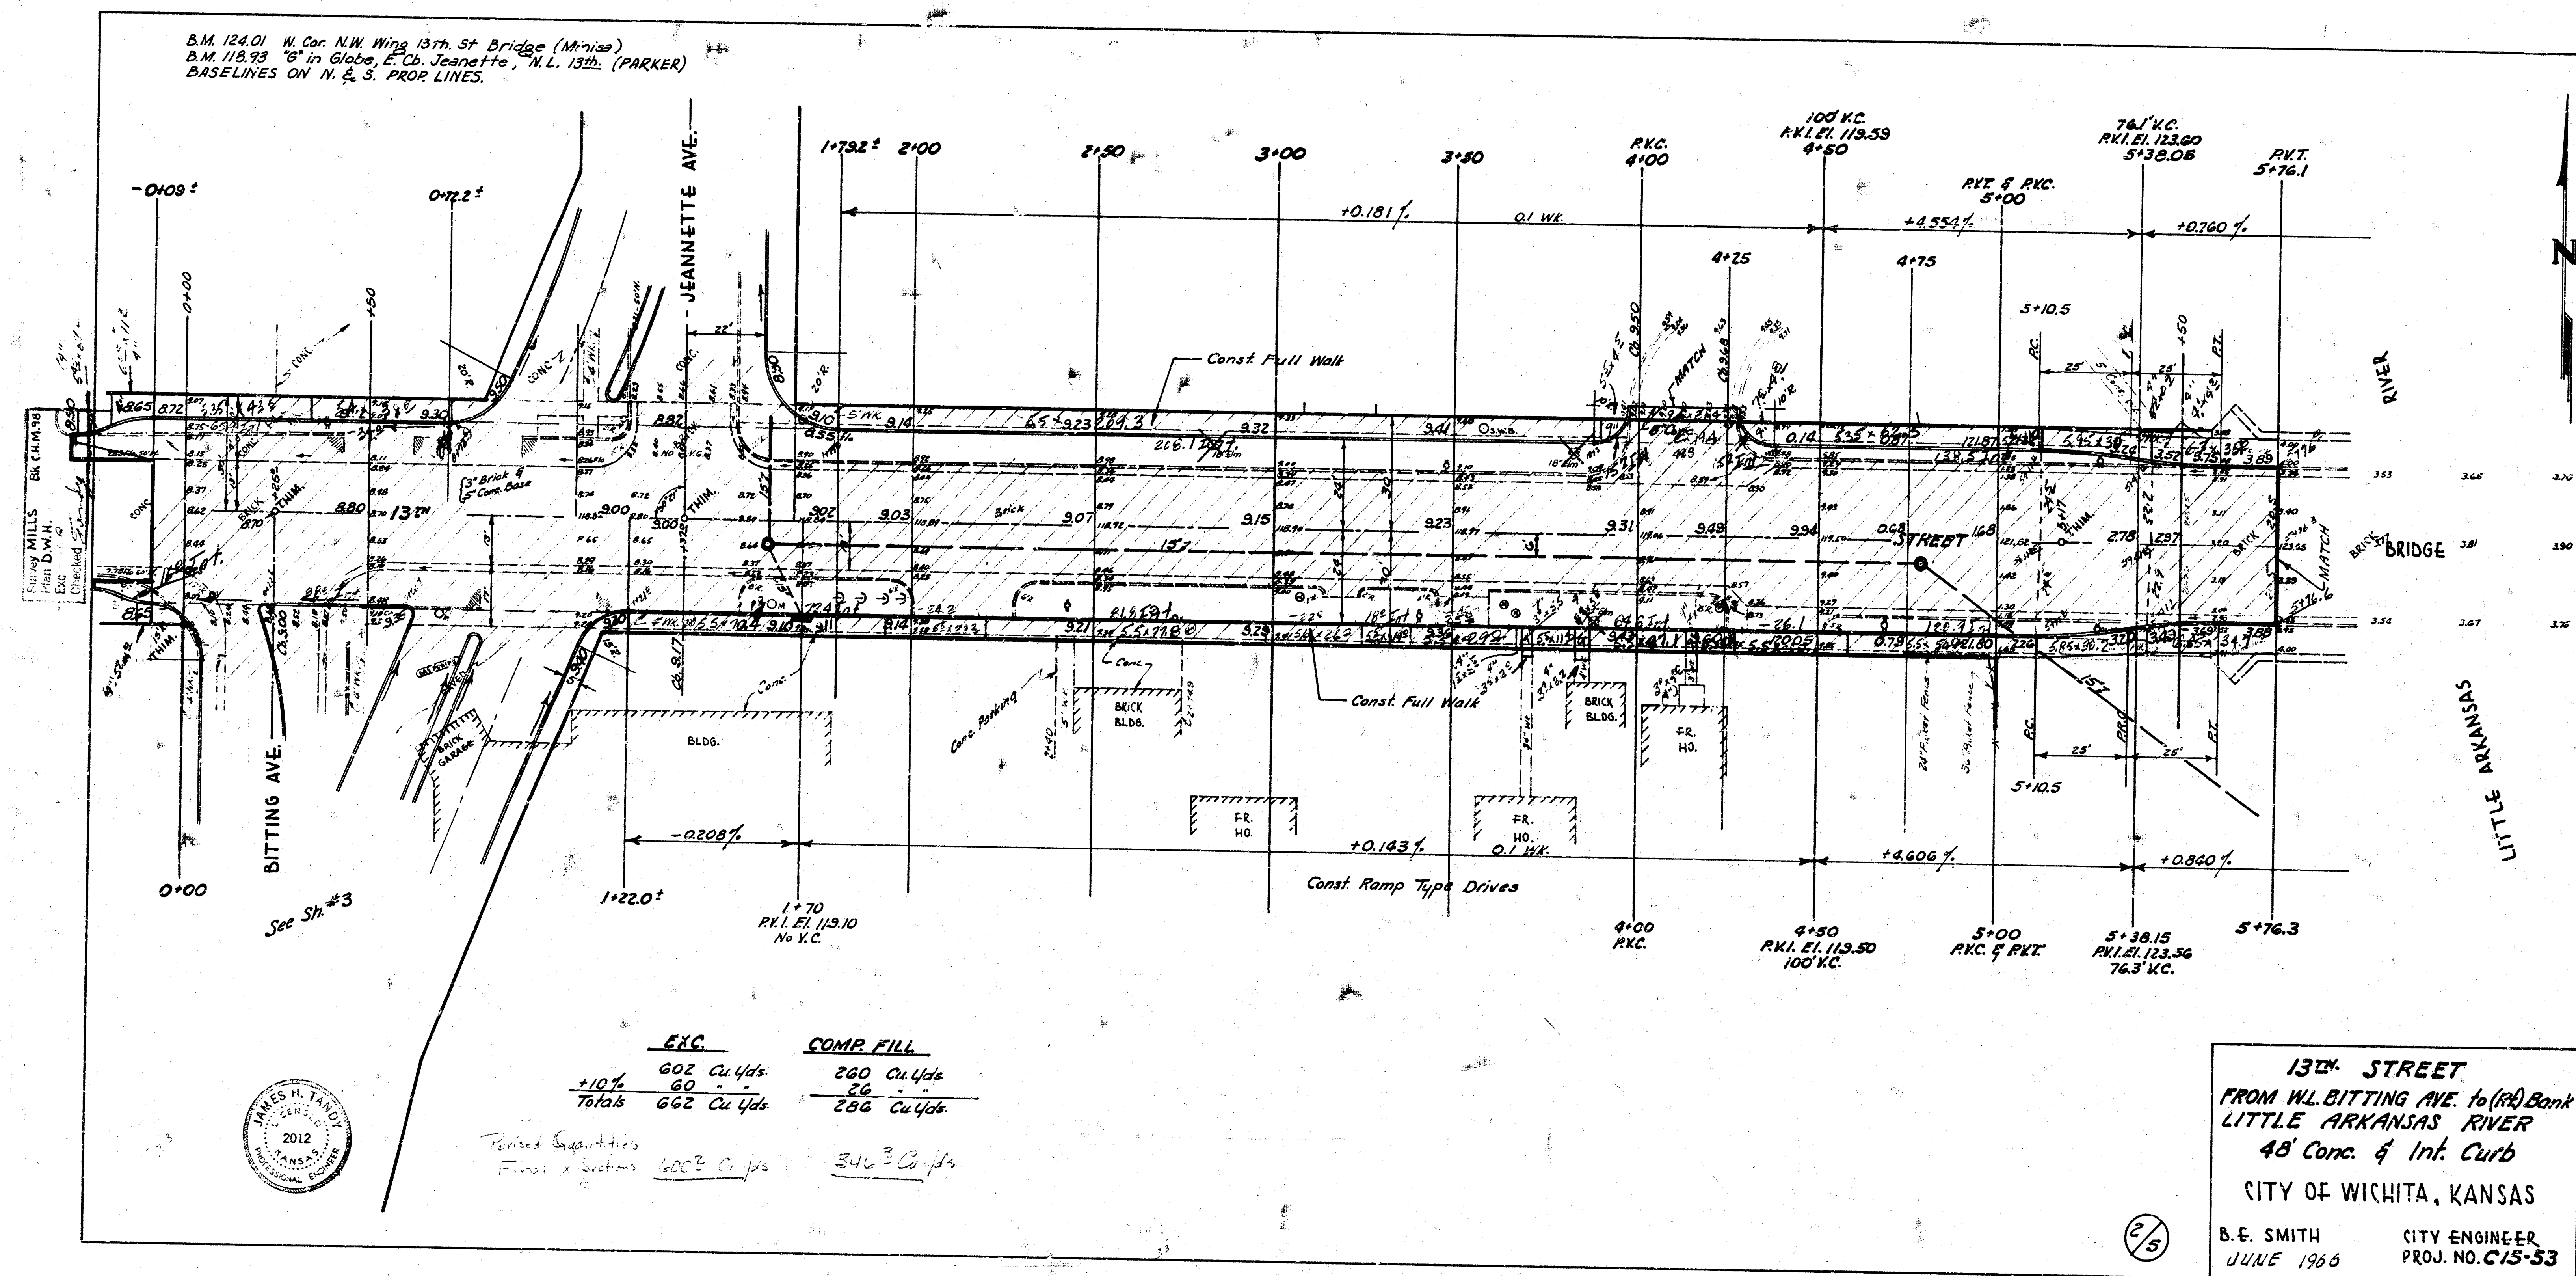

Survey 1152 - 8/1/27
Plan
LLA
Exc
Checked

