

NOTE:

FIELD ENGR. & CONTRACTOR


Cross hatching indicates area of removal & replacement.

Alleys & Drives replaced will be RAMP TYPE.

Reconstruction of Drives & Alleys Returns on 13th St. Waco to Little Ark. River

City of Wichita, Kansas
B.E. Smith City Engineer

Checked

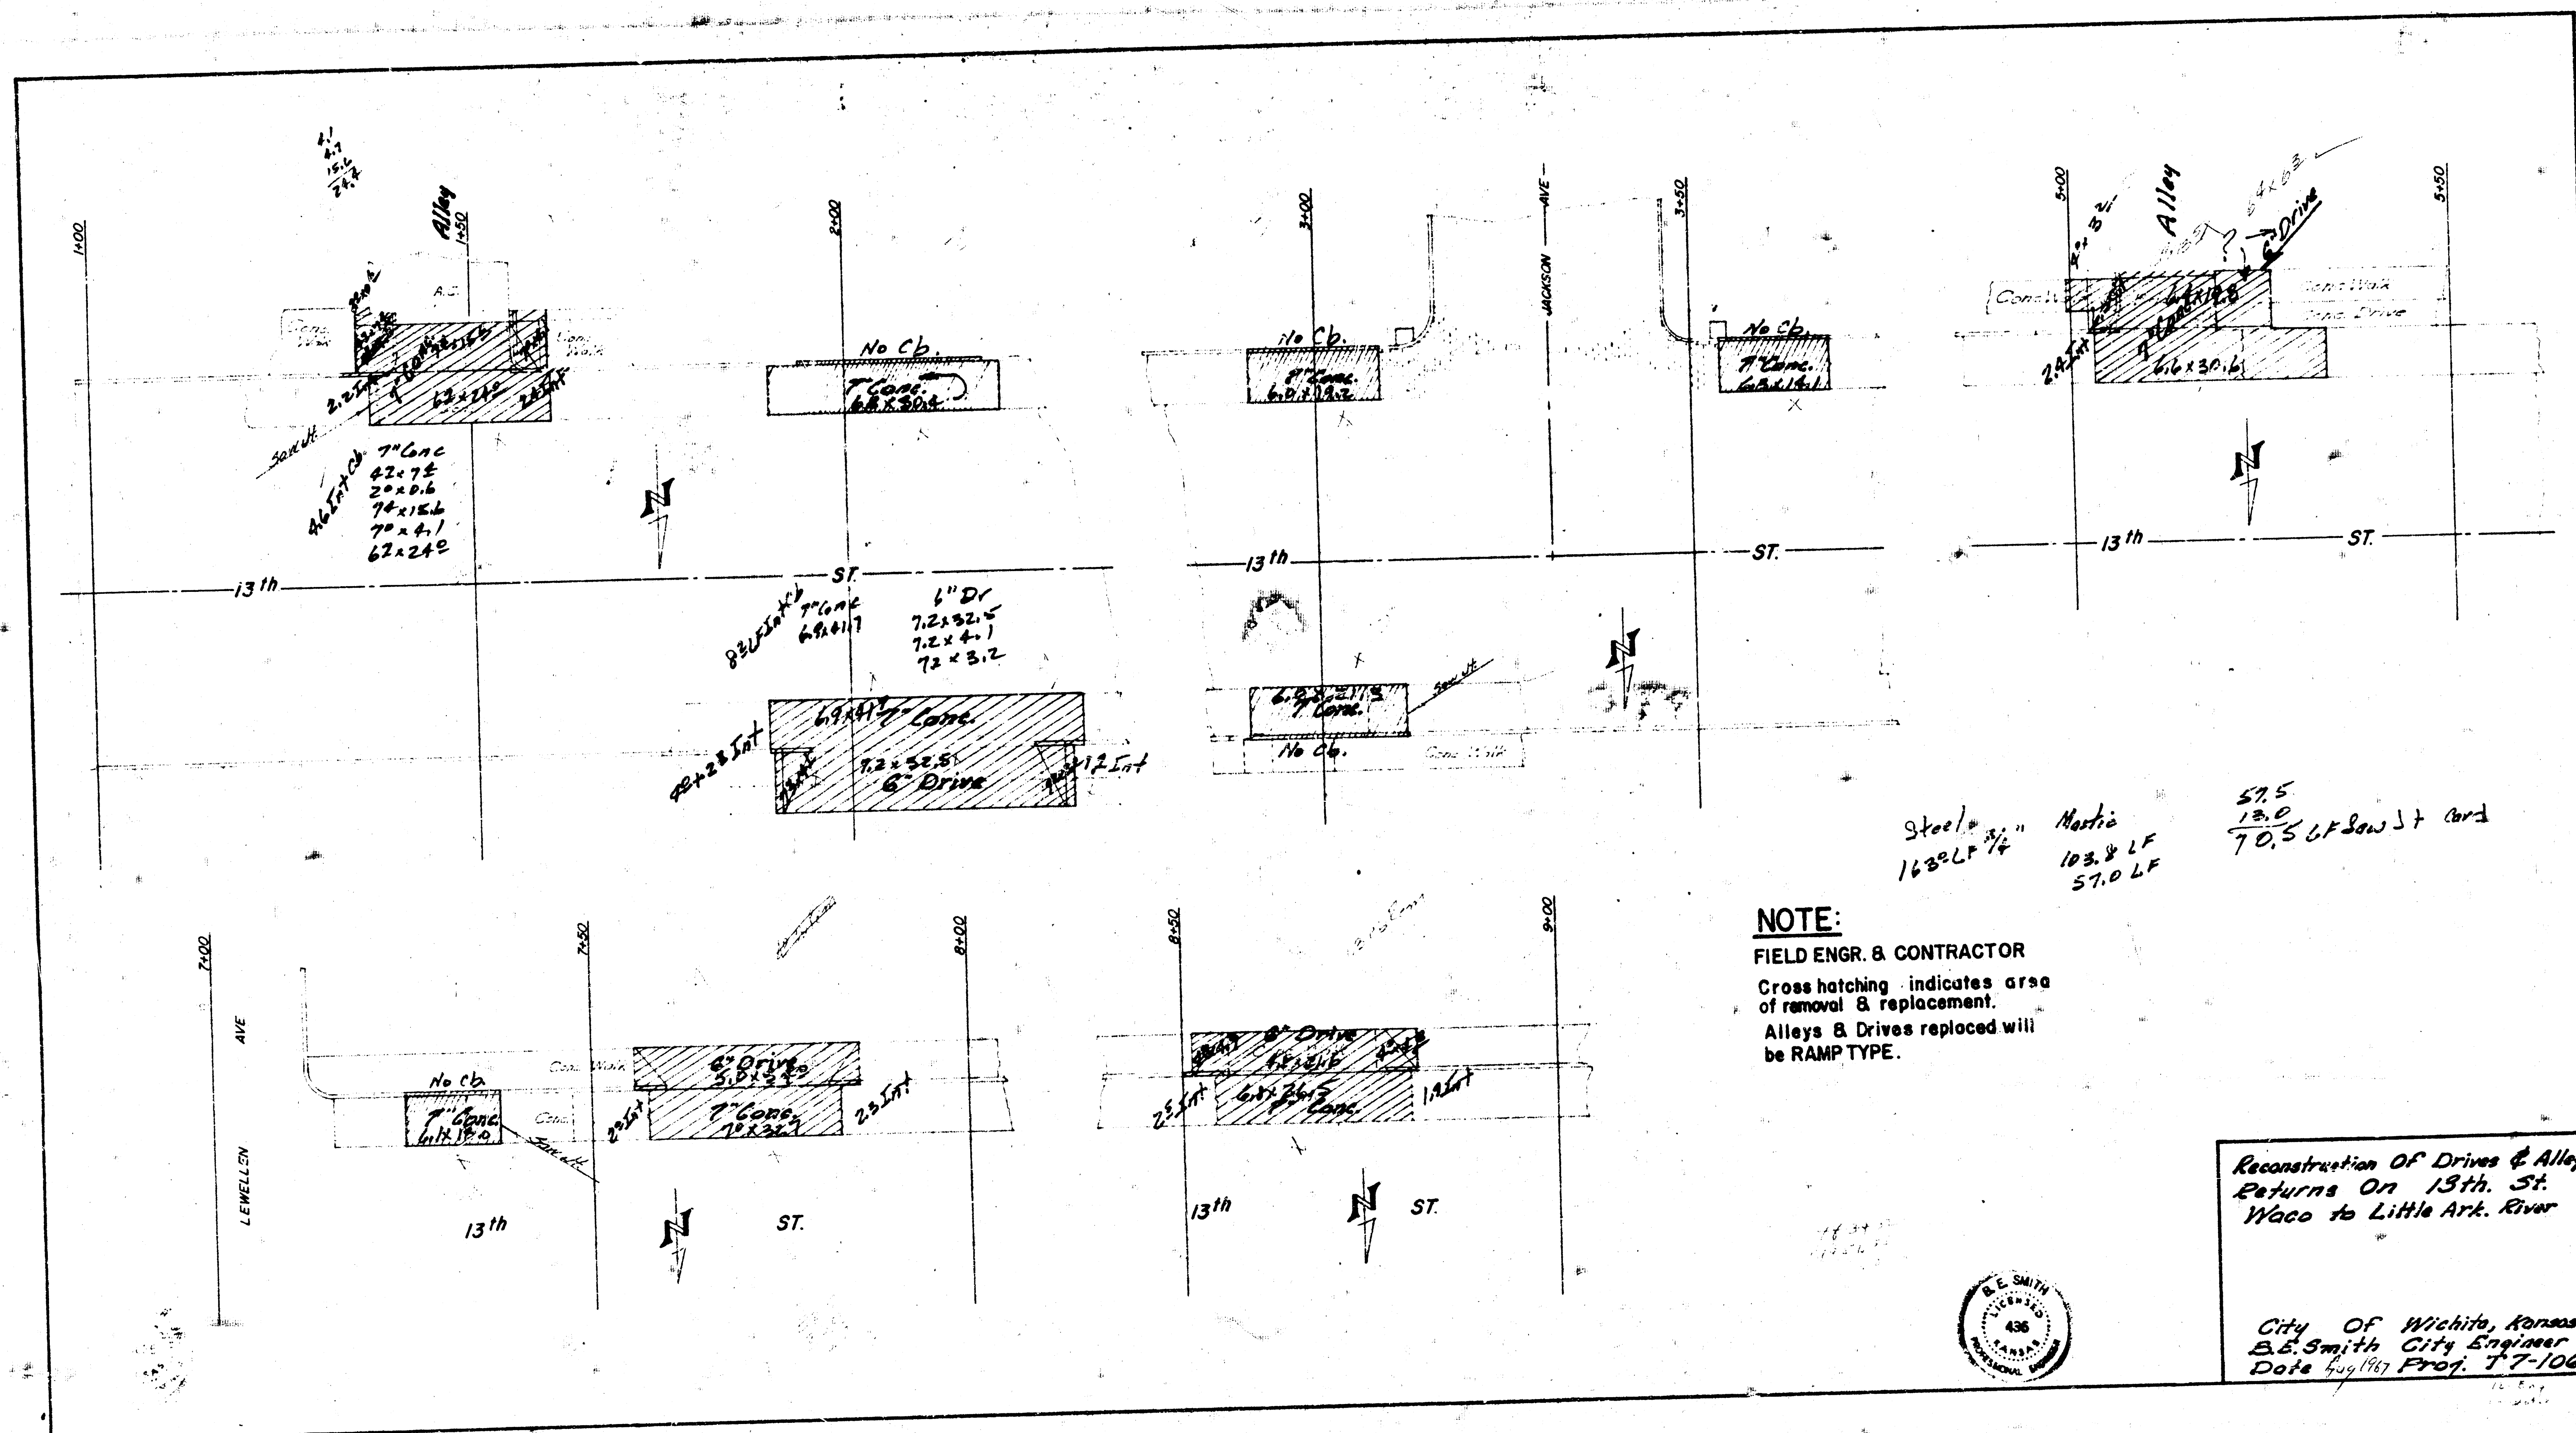

NOTE:

FIELD ENGR. & CONTRACTOR
Cross hatching indicates area
of removal & replacement.
Alleys & Drives replaced will
be RAMP TYPE.

Steel 1/4" 163' LF
Nashia 103.8 LF
57.5 LF
12.0 LF
70.5 LF Saw St Card



Reconstruction of Drives & Alley
Returns On 13th St.
Waco to Little Ark. River

City of Wichita, Kansas
E.E. Smith City Engineer
Date 4/24/67 Proj. T-7-106