


[illegible]

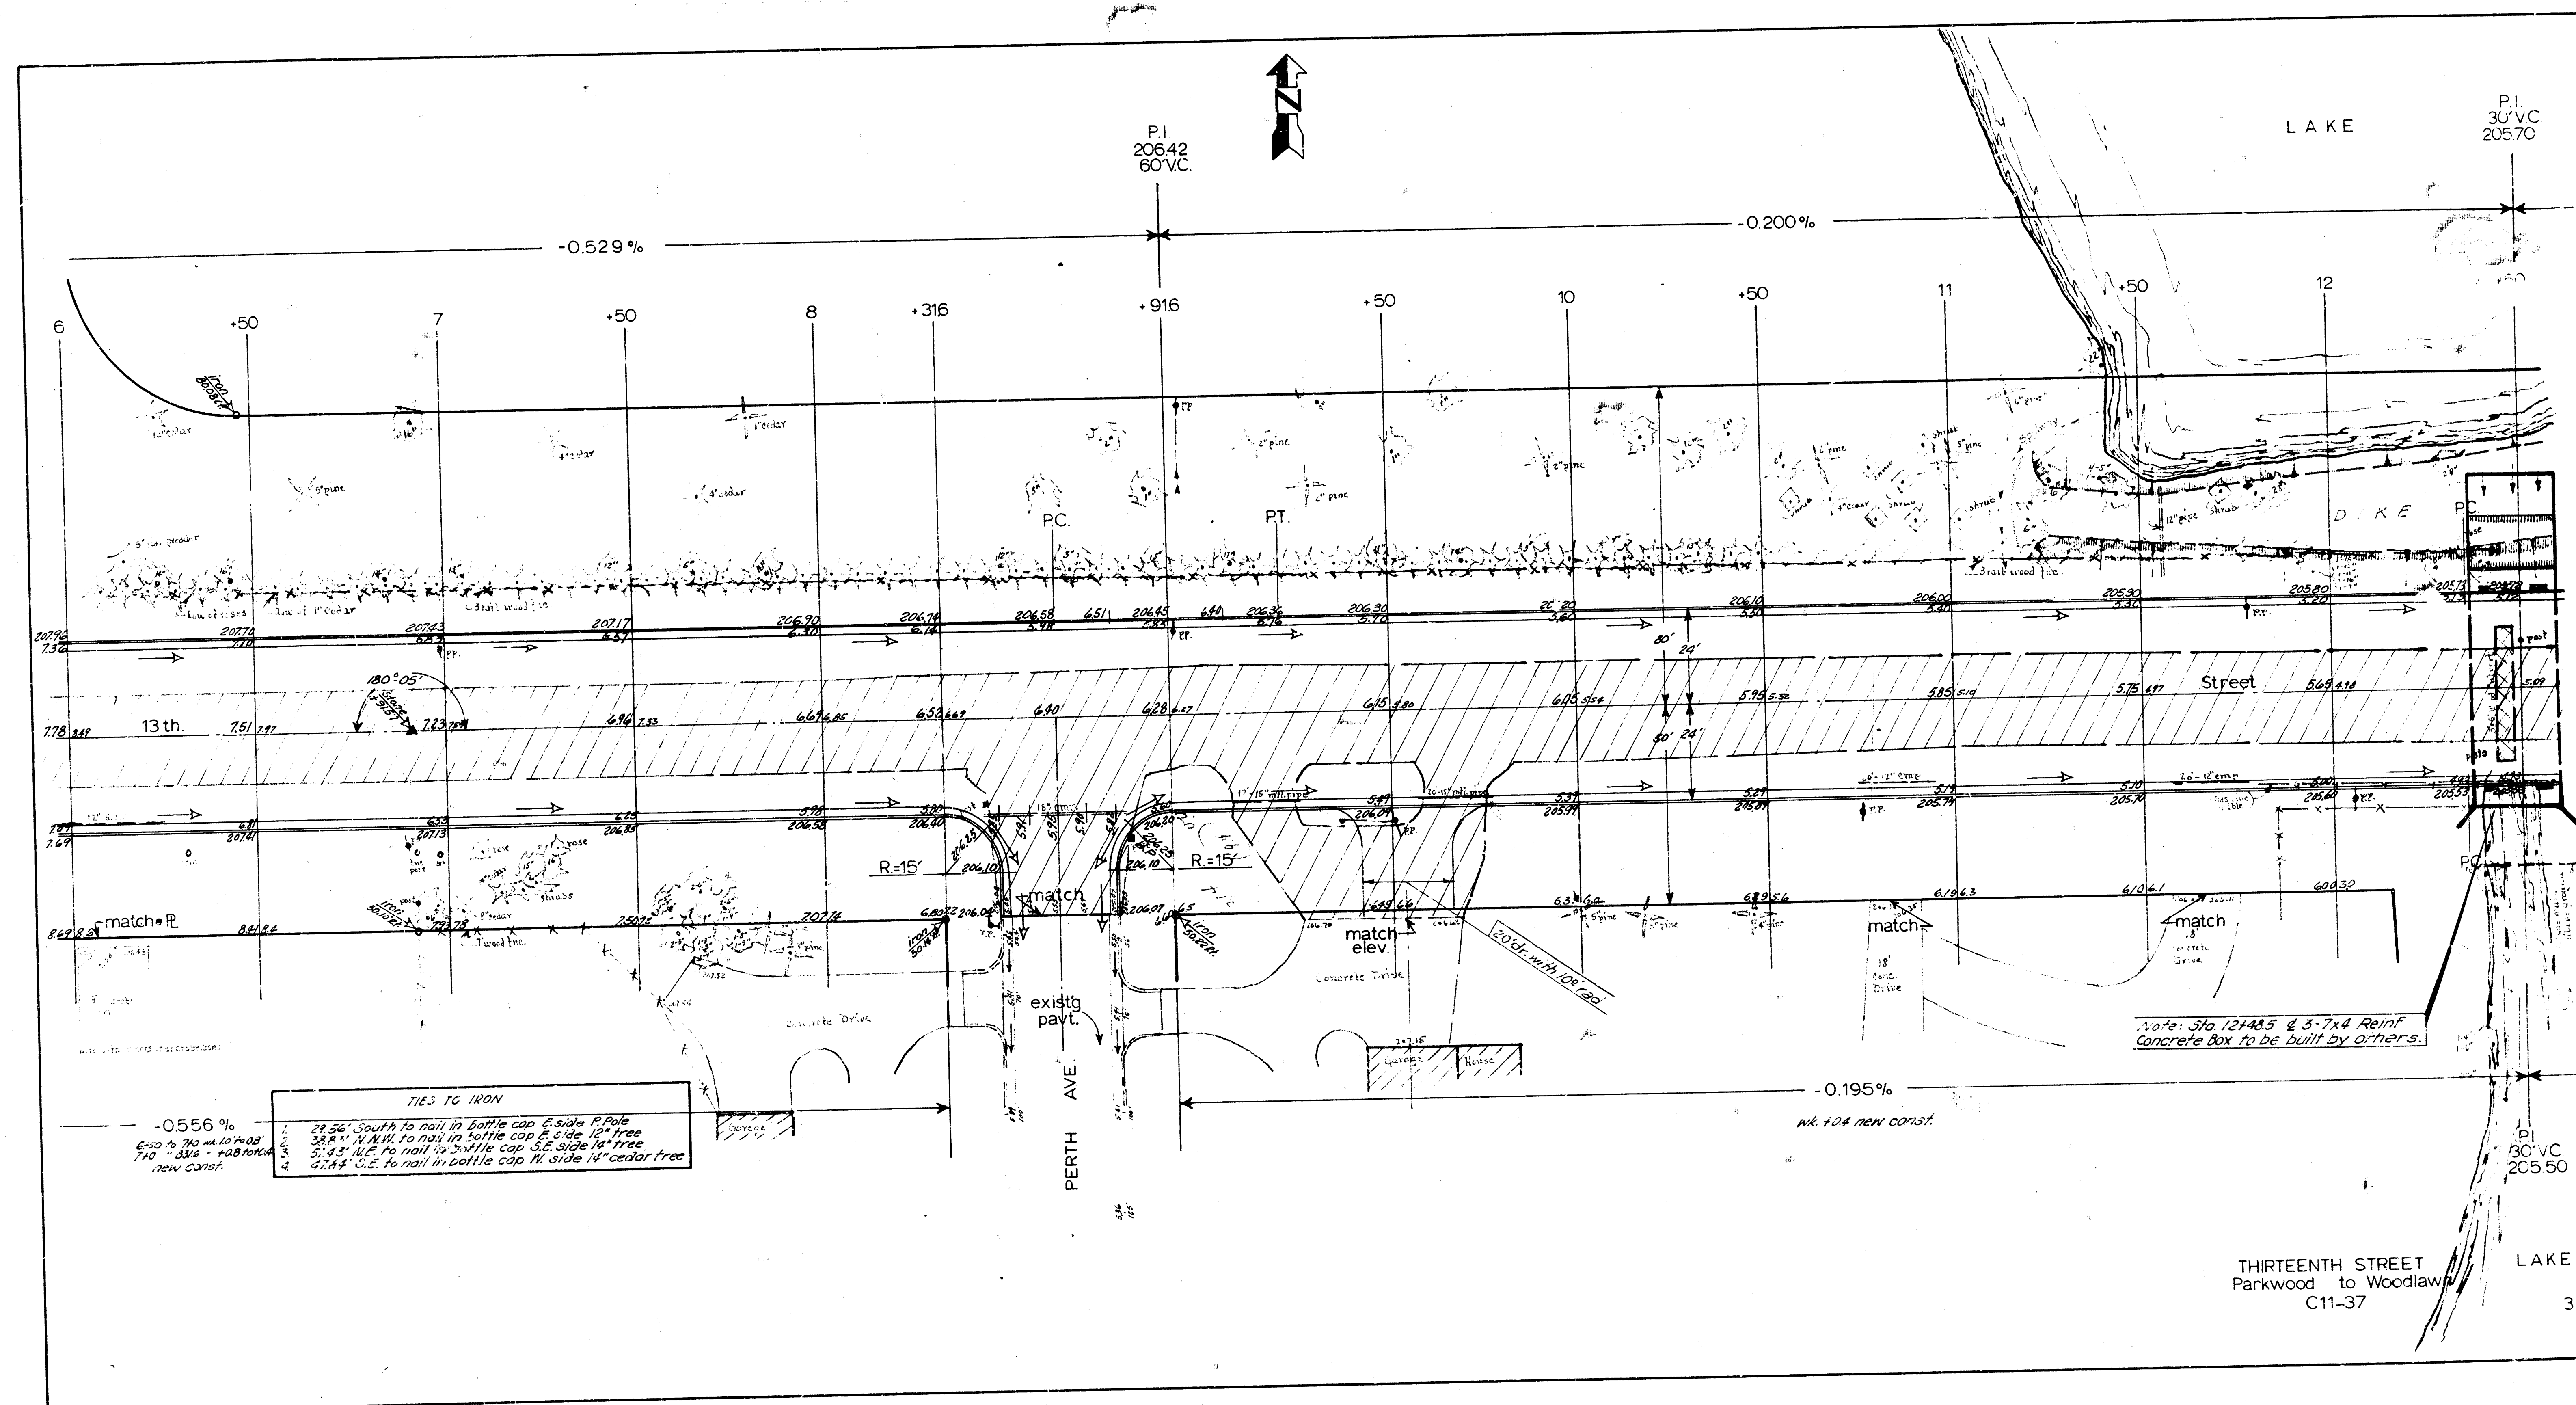












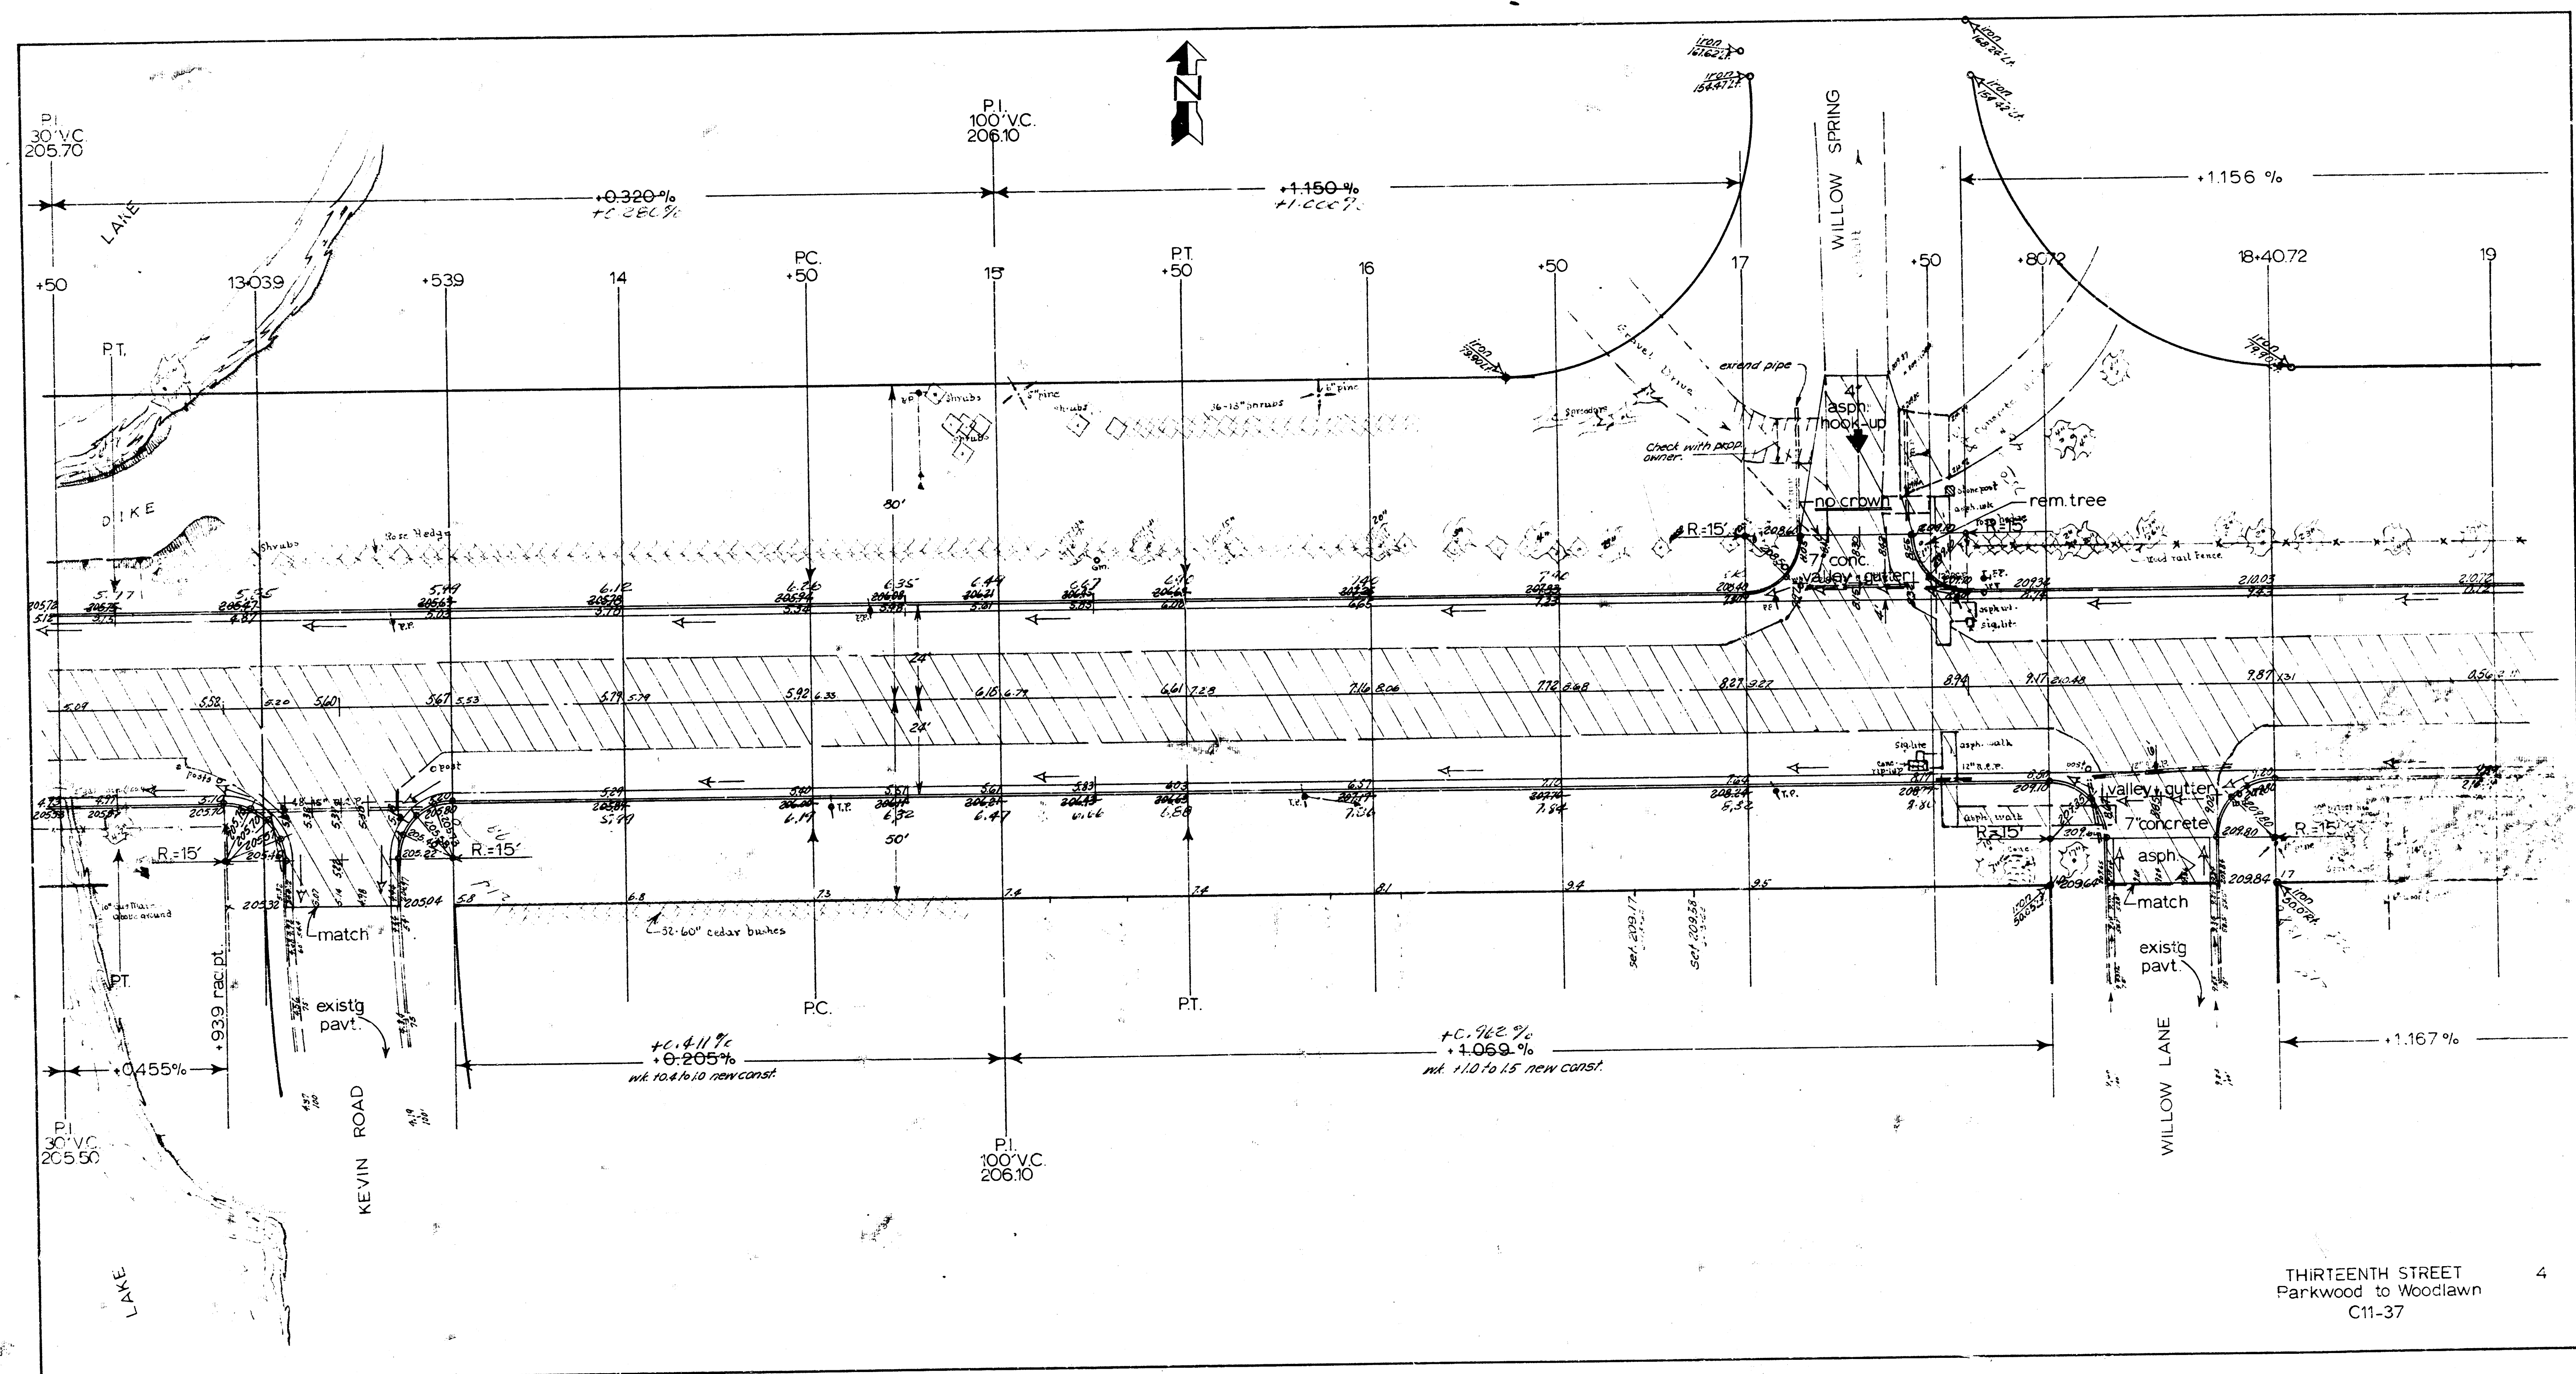




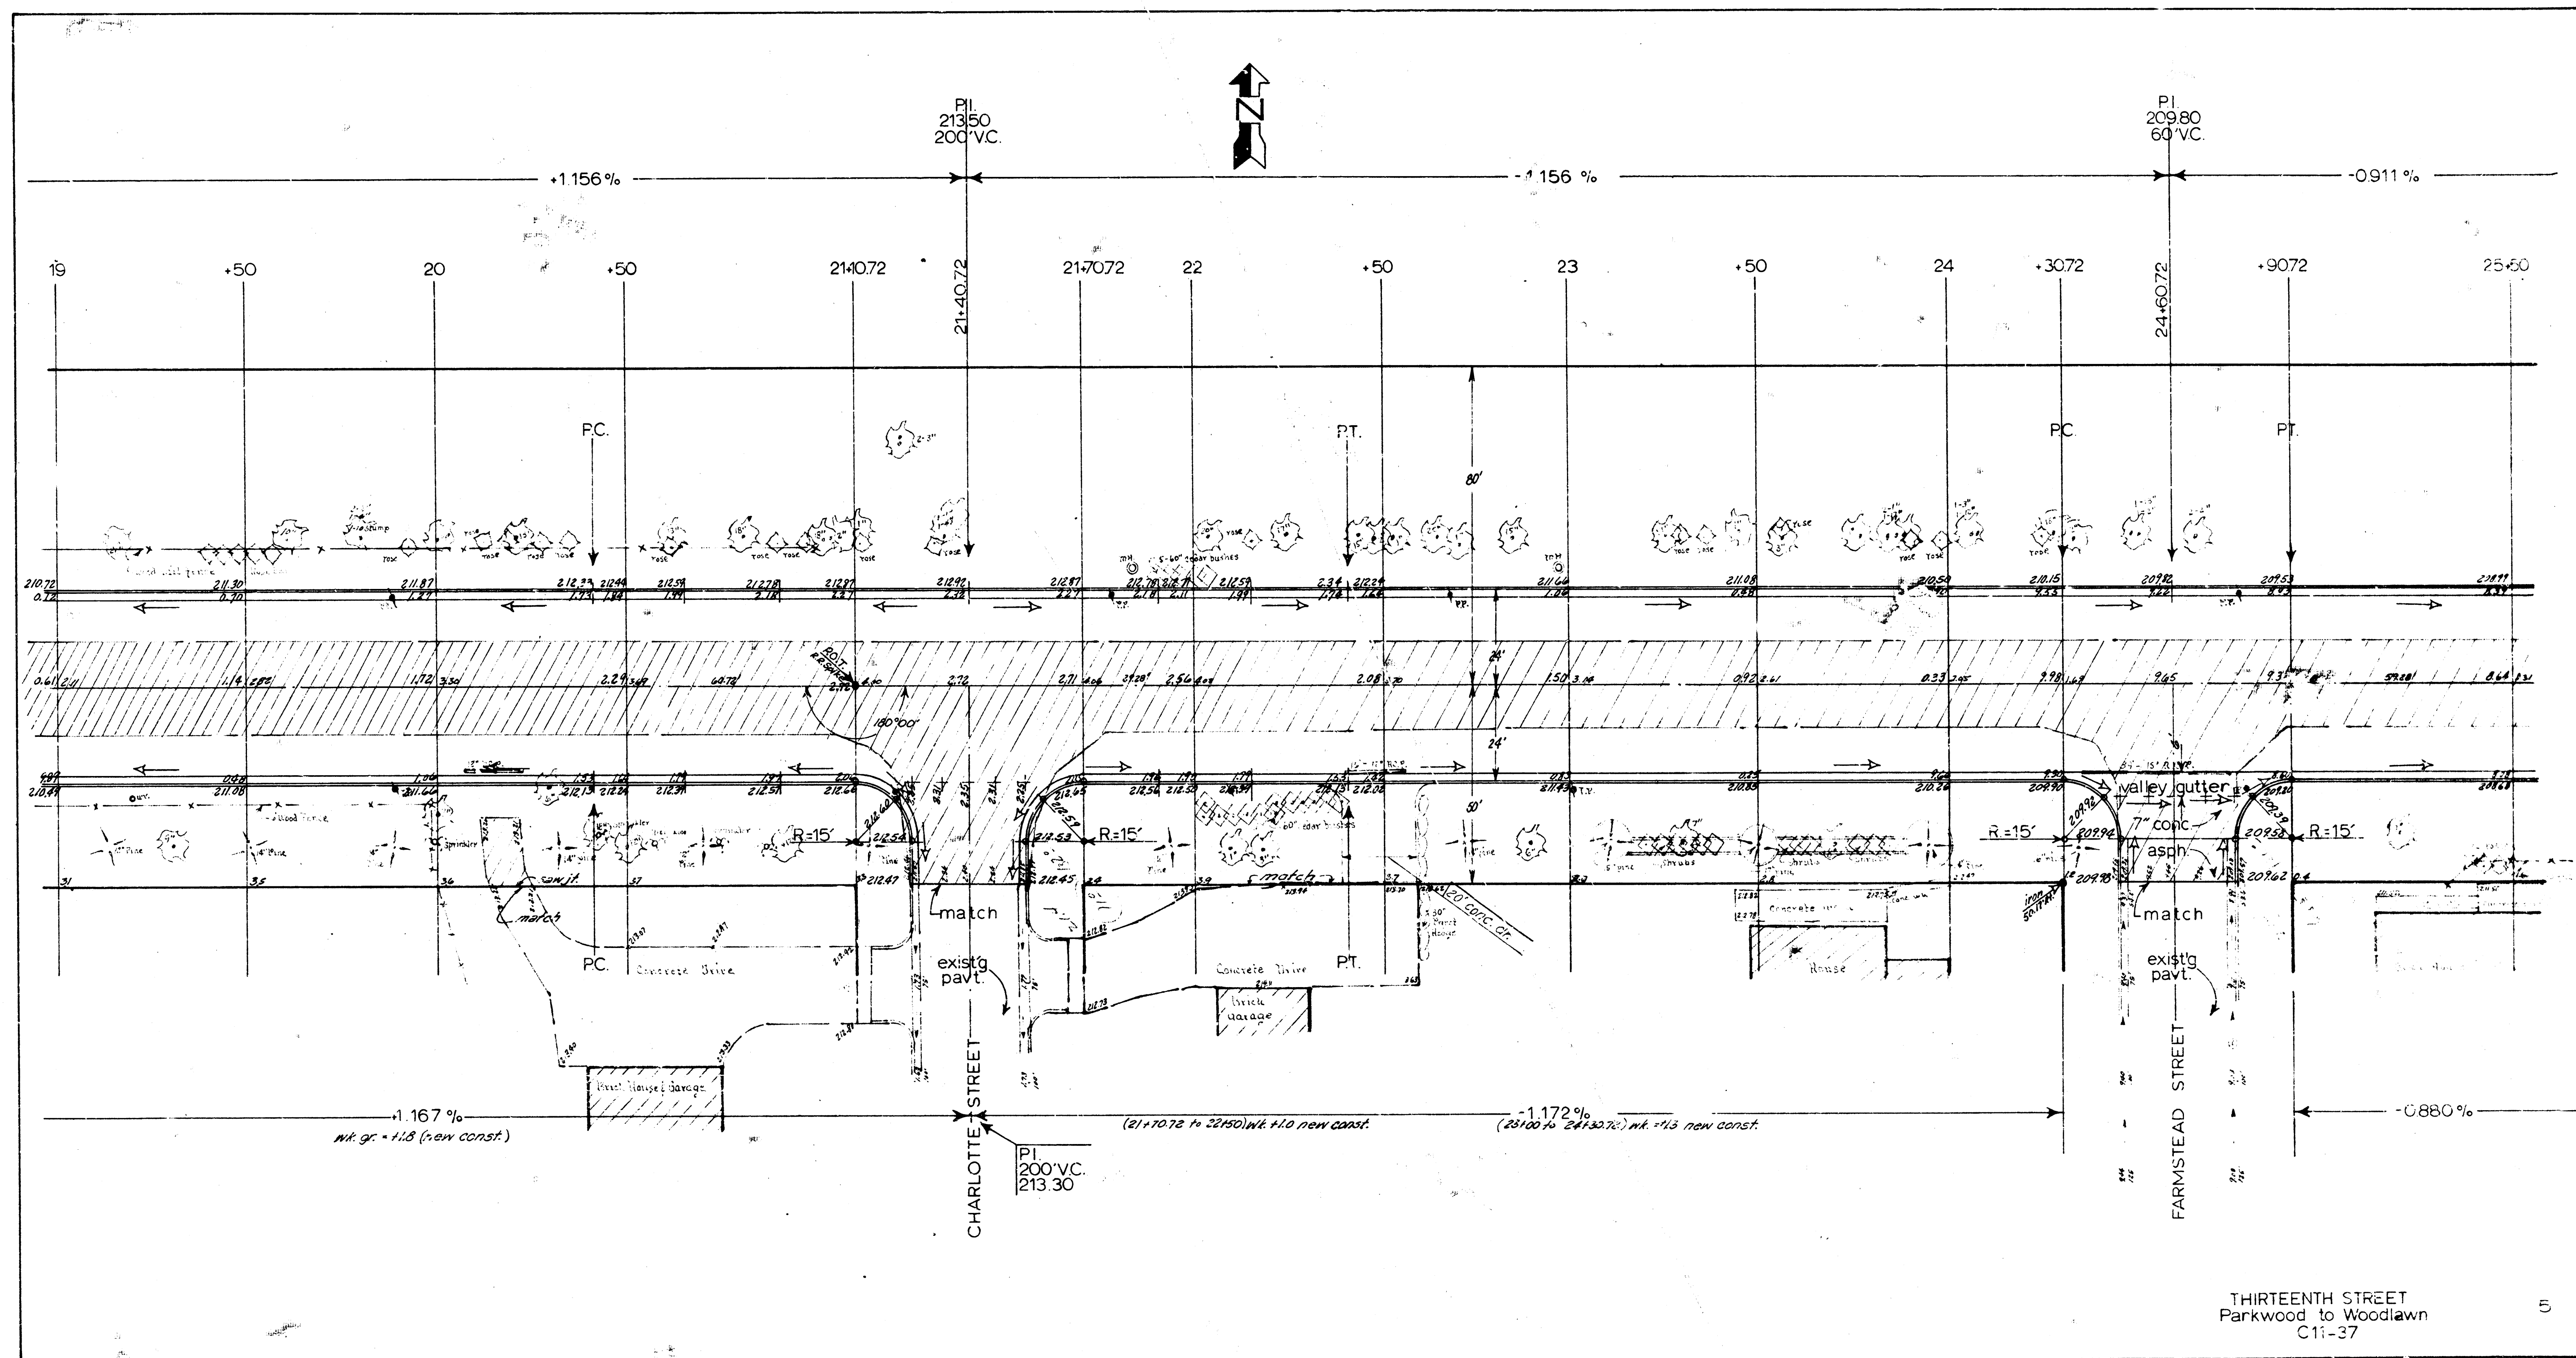



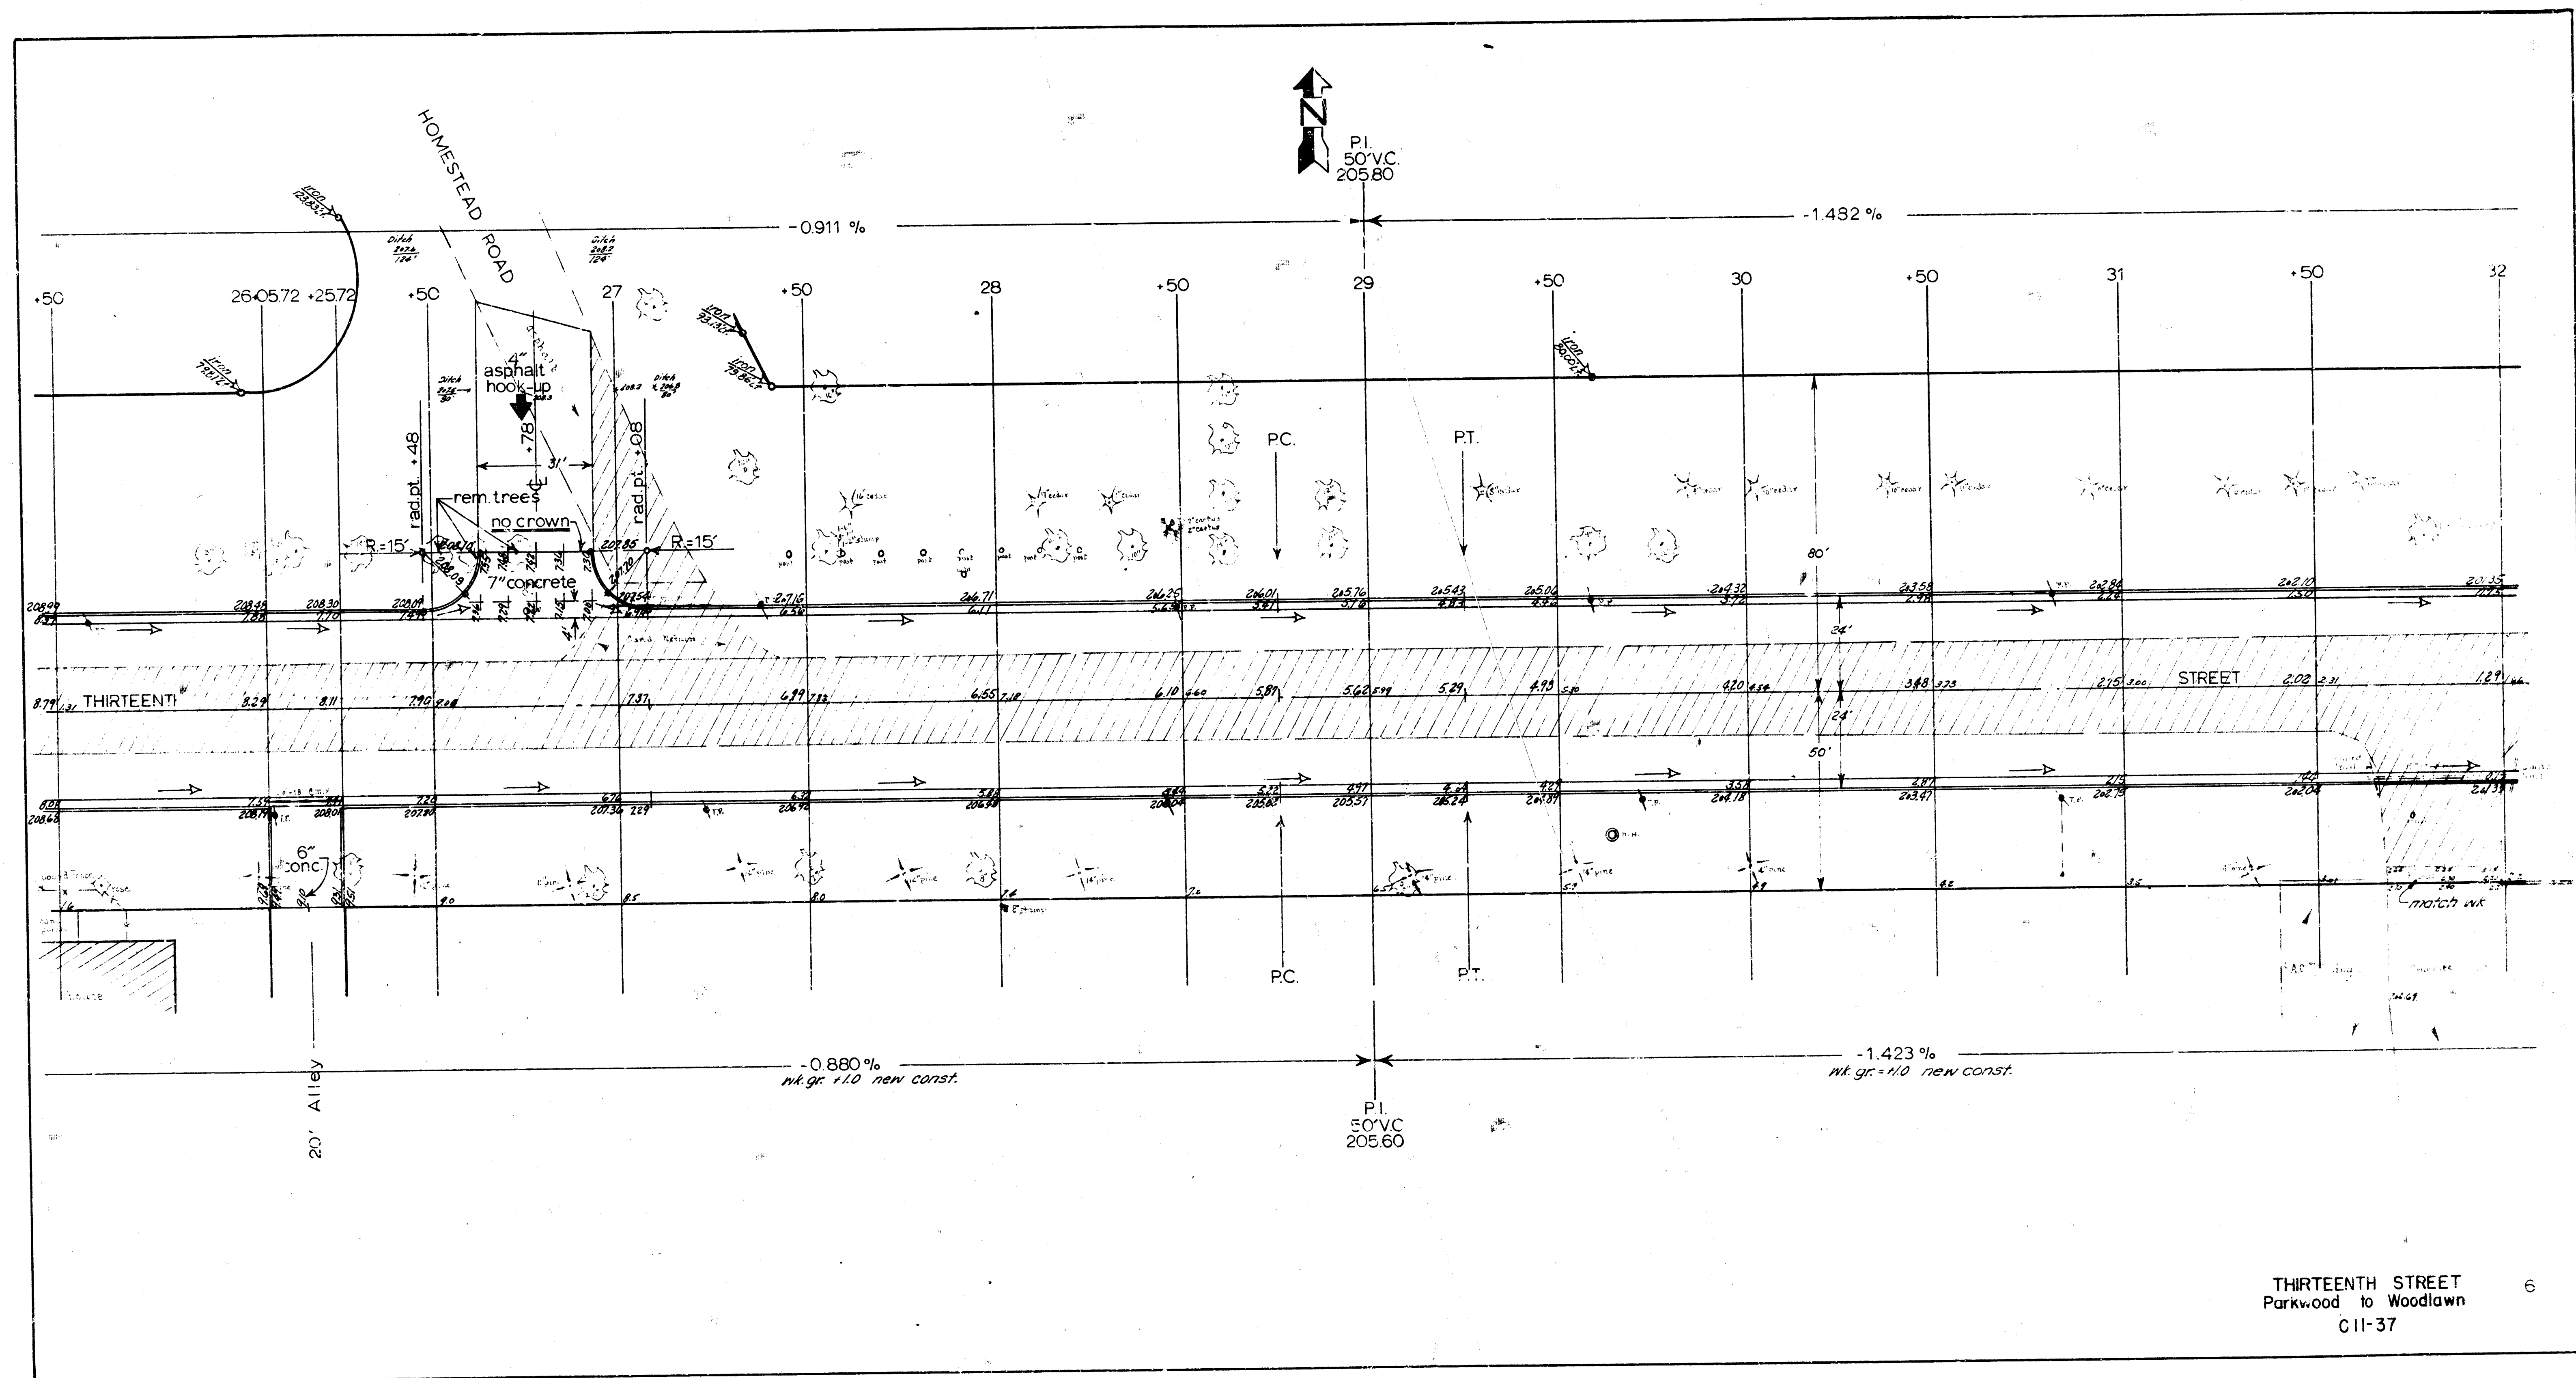



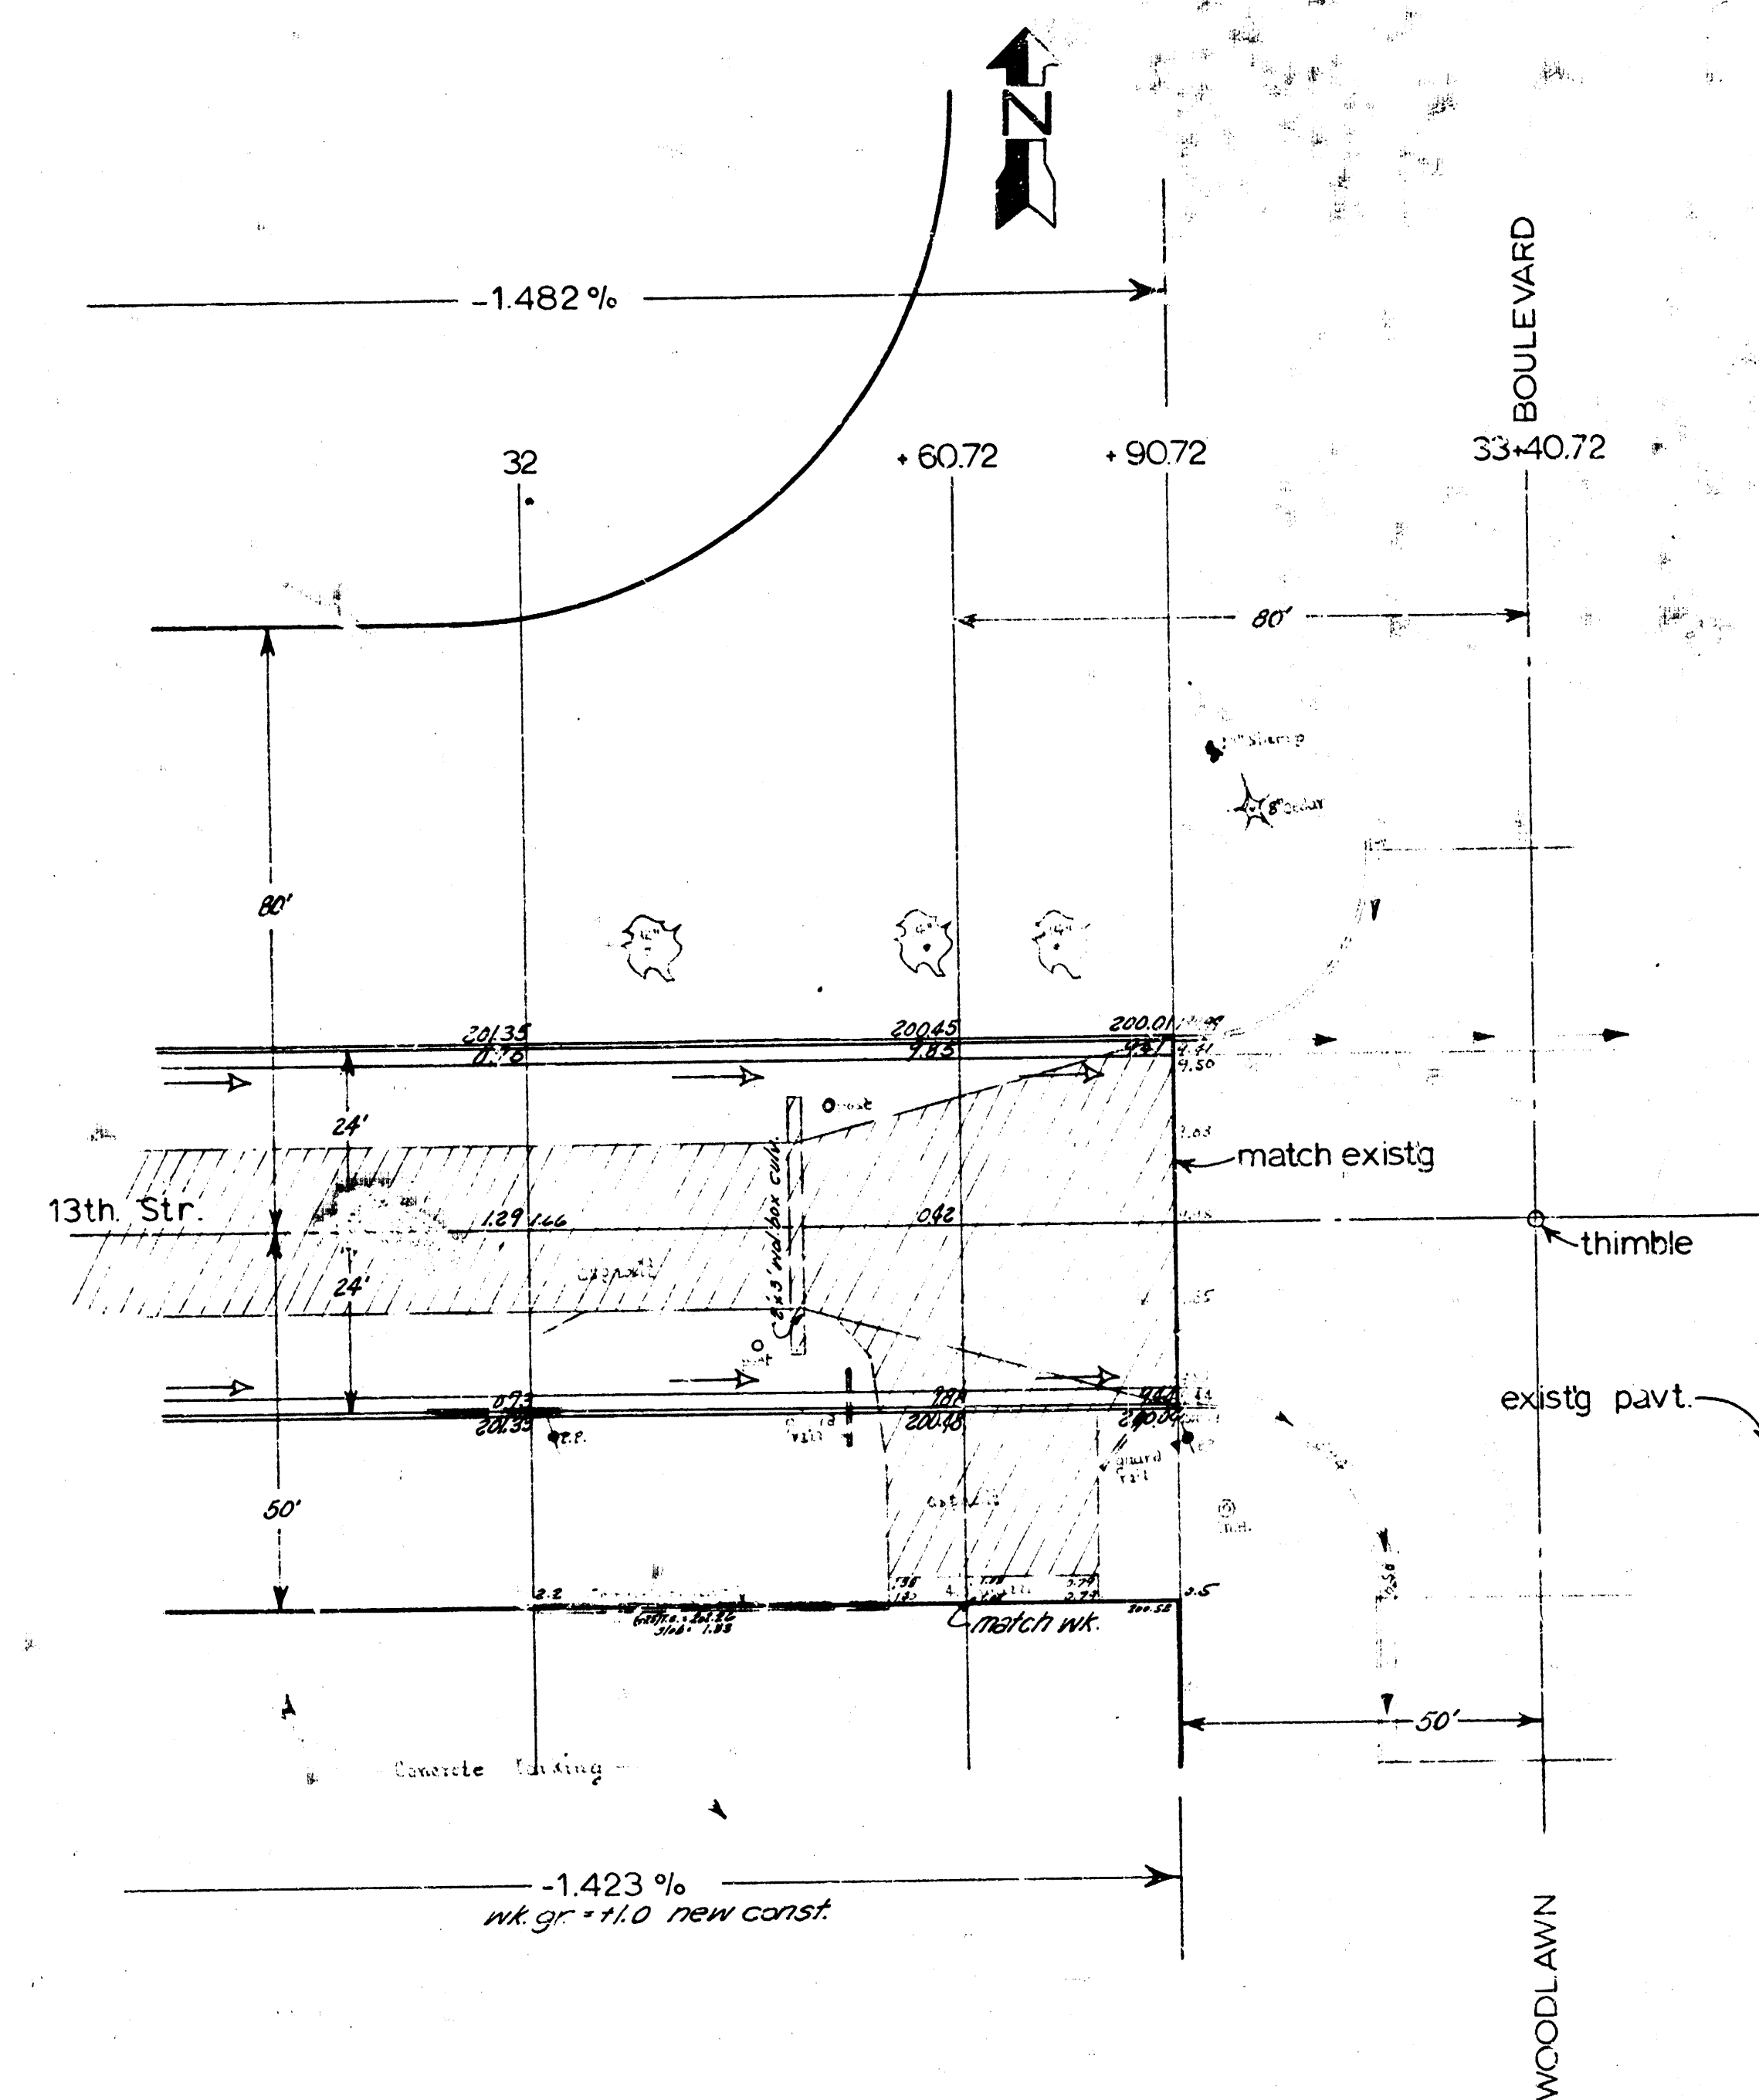

THIRTEENTH STREET  
Parkwood to Woodlawn  
C11-37