

B.M. 209.69 Knurled 3/60 spike in tree, N.E. Cor 13th & Oliver.

Note: Stationing is on S.P.L.
Grades set on Cb. line distances.

Note: Install drain pipe under intersection of 15th & Oliver, E.L. Oliver. Connect conc. pvt. on 15th to pvt. on Oliver with Asph.


500P
1162
 1670
 1197
1180
 642
 74.
137
112.5
 646.5
 +102
953.2 Cur Lts

<u>Grand Total</u>	
<u>Prop</u>	<u>City</u>
9532	73.9 Cu Yds.
6239	
<u>1,577.1 Cu Yds.</u>	

15th ST
E.L. Oliver - W.L. Northeast Parkway
30' Conc. & Cb.
City of Wichita, Kansas
L.K. White City Engineer
September 1998 Project C18-423

Prop
 101.5
 83.2
 72.0
 81.1
 92.3
 136.7
 567.2
 +10.6
 623.9 @ 40.

5.44
 0

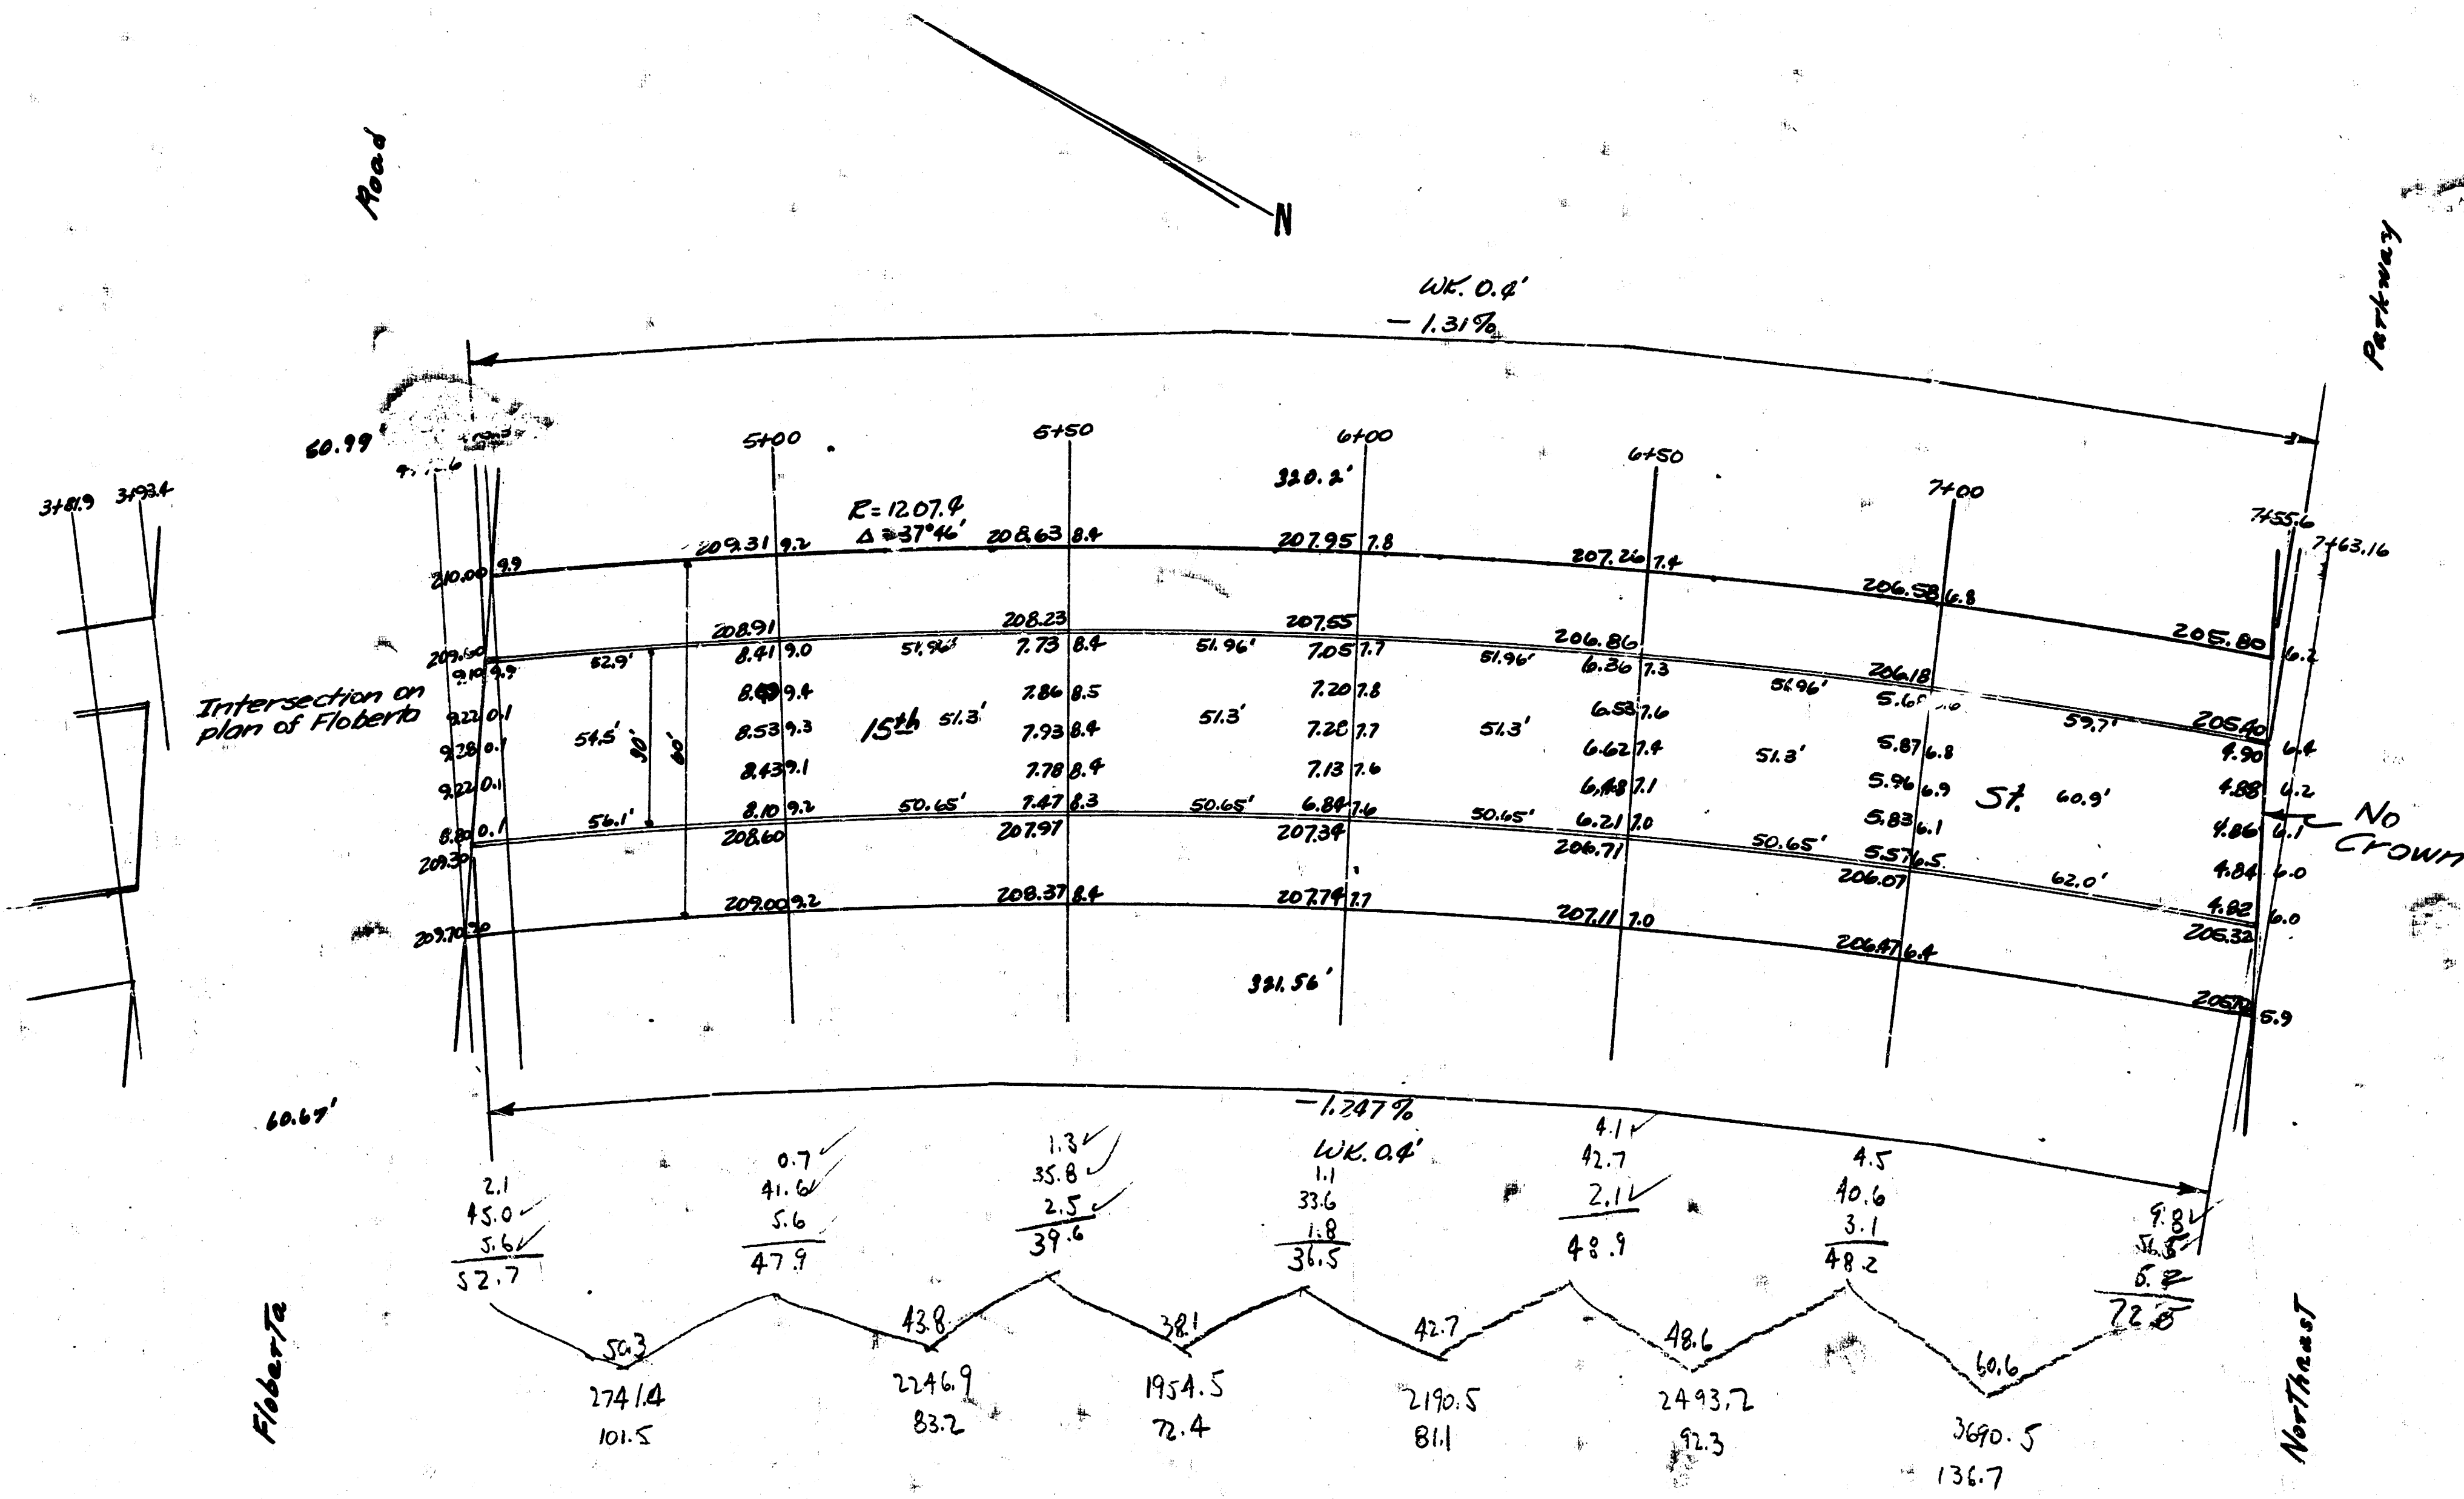

2
 2

4 14 5 6