
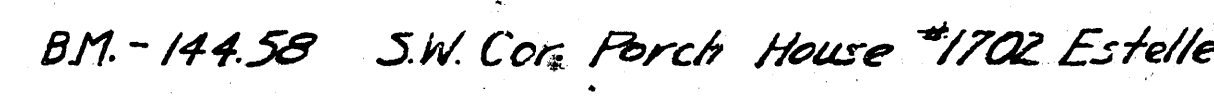


[illegible]

$$\begin{array}{r} 116.5 \\ + 117 \\ \hline 233.5 \end{array}$$

40' observation
 in the high
 lane that in the
 parking
 lane.

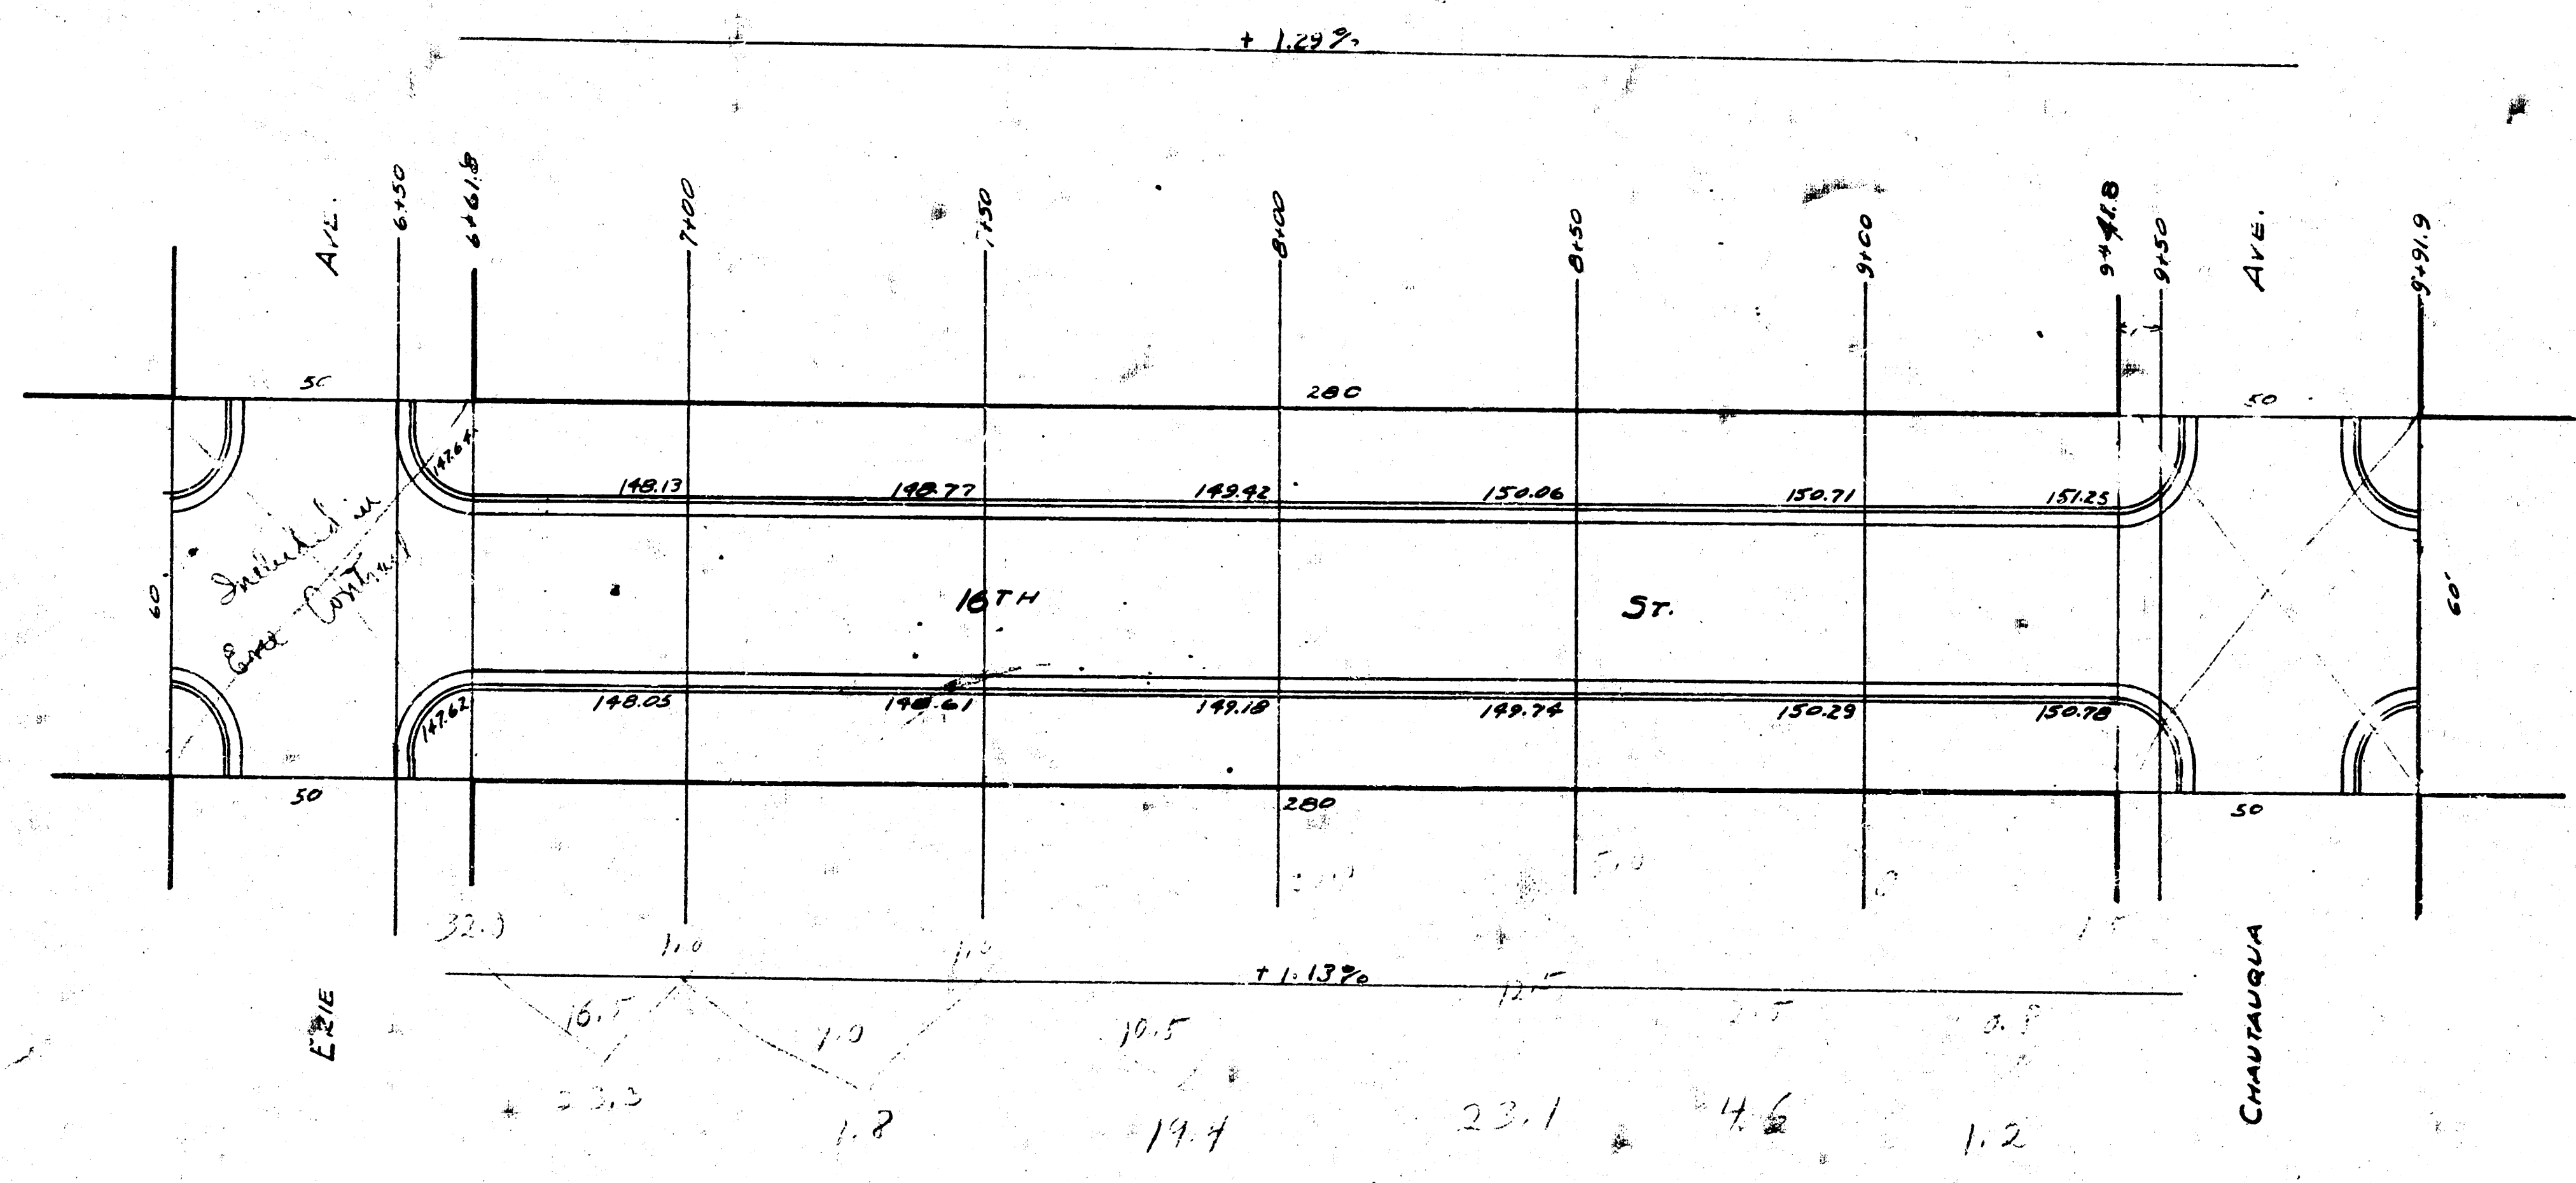

1.100
 23.3
 1.8
 1.1
 23.1
 4.6
 1.2
 73.4
 + 1.2
 74.6
 70.7