



CH Mills
Greene J.W.
Greene J.W.
CH Mills

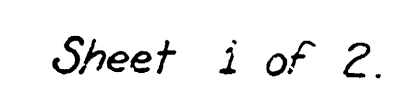

Walk grade has been raised from 04 to 07 on S. side Sta. 0+00 to 6+00. Check if new walk grade will match existg construction.

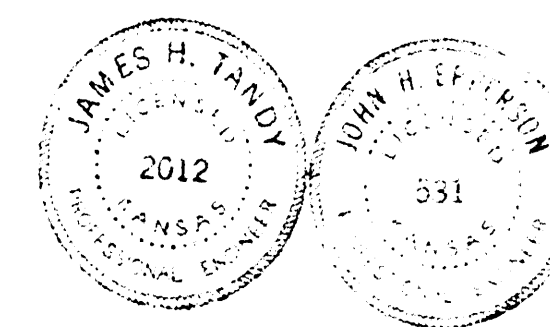

19TH ST.
EL West St. to WL Westridge Dr.
26- 2- 30AC
CITY OF WICHITA, KANSAS
B.E. SMITH CITY ENGINEER
SEPT. 1958, PROJ. NO C15-148

