


Final Notes
 Put Section (Book 10)

B.M. 121.46 - "X" front of walk S.W. cor. Woodland & 19th.
 B.M. 119.82 Top of elm. ckn. 18th. & Woodland.


Prop.	City
38.0	7.0
37.6	78.6
27.1	20.7
9.8	21.3
15.6	58.9
37.8	19.2
16.6 + 10%	20.1
182.5	5
	22.8 - 10%
	25.5

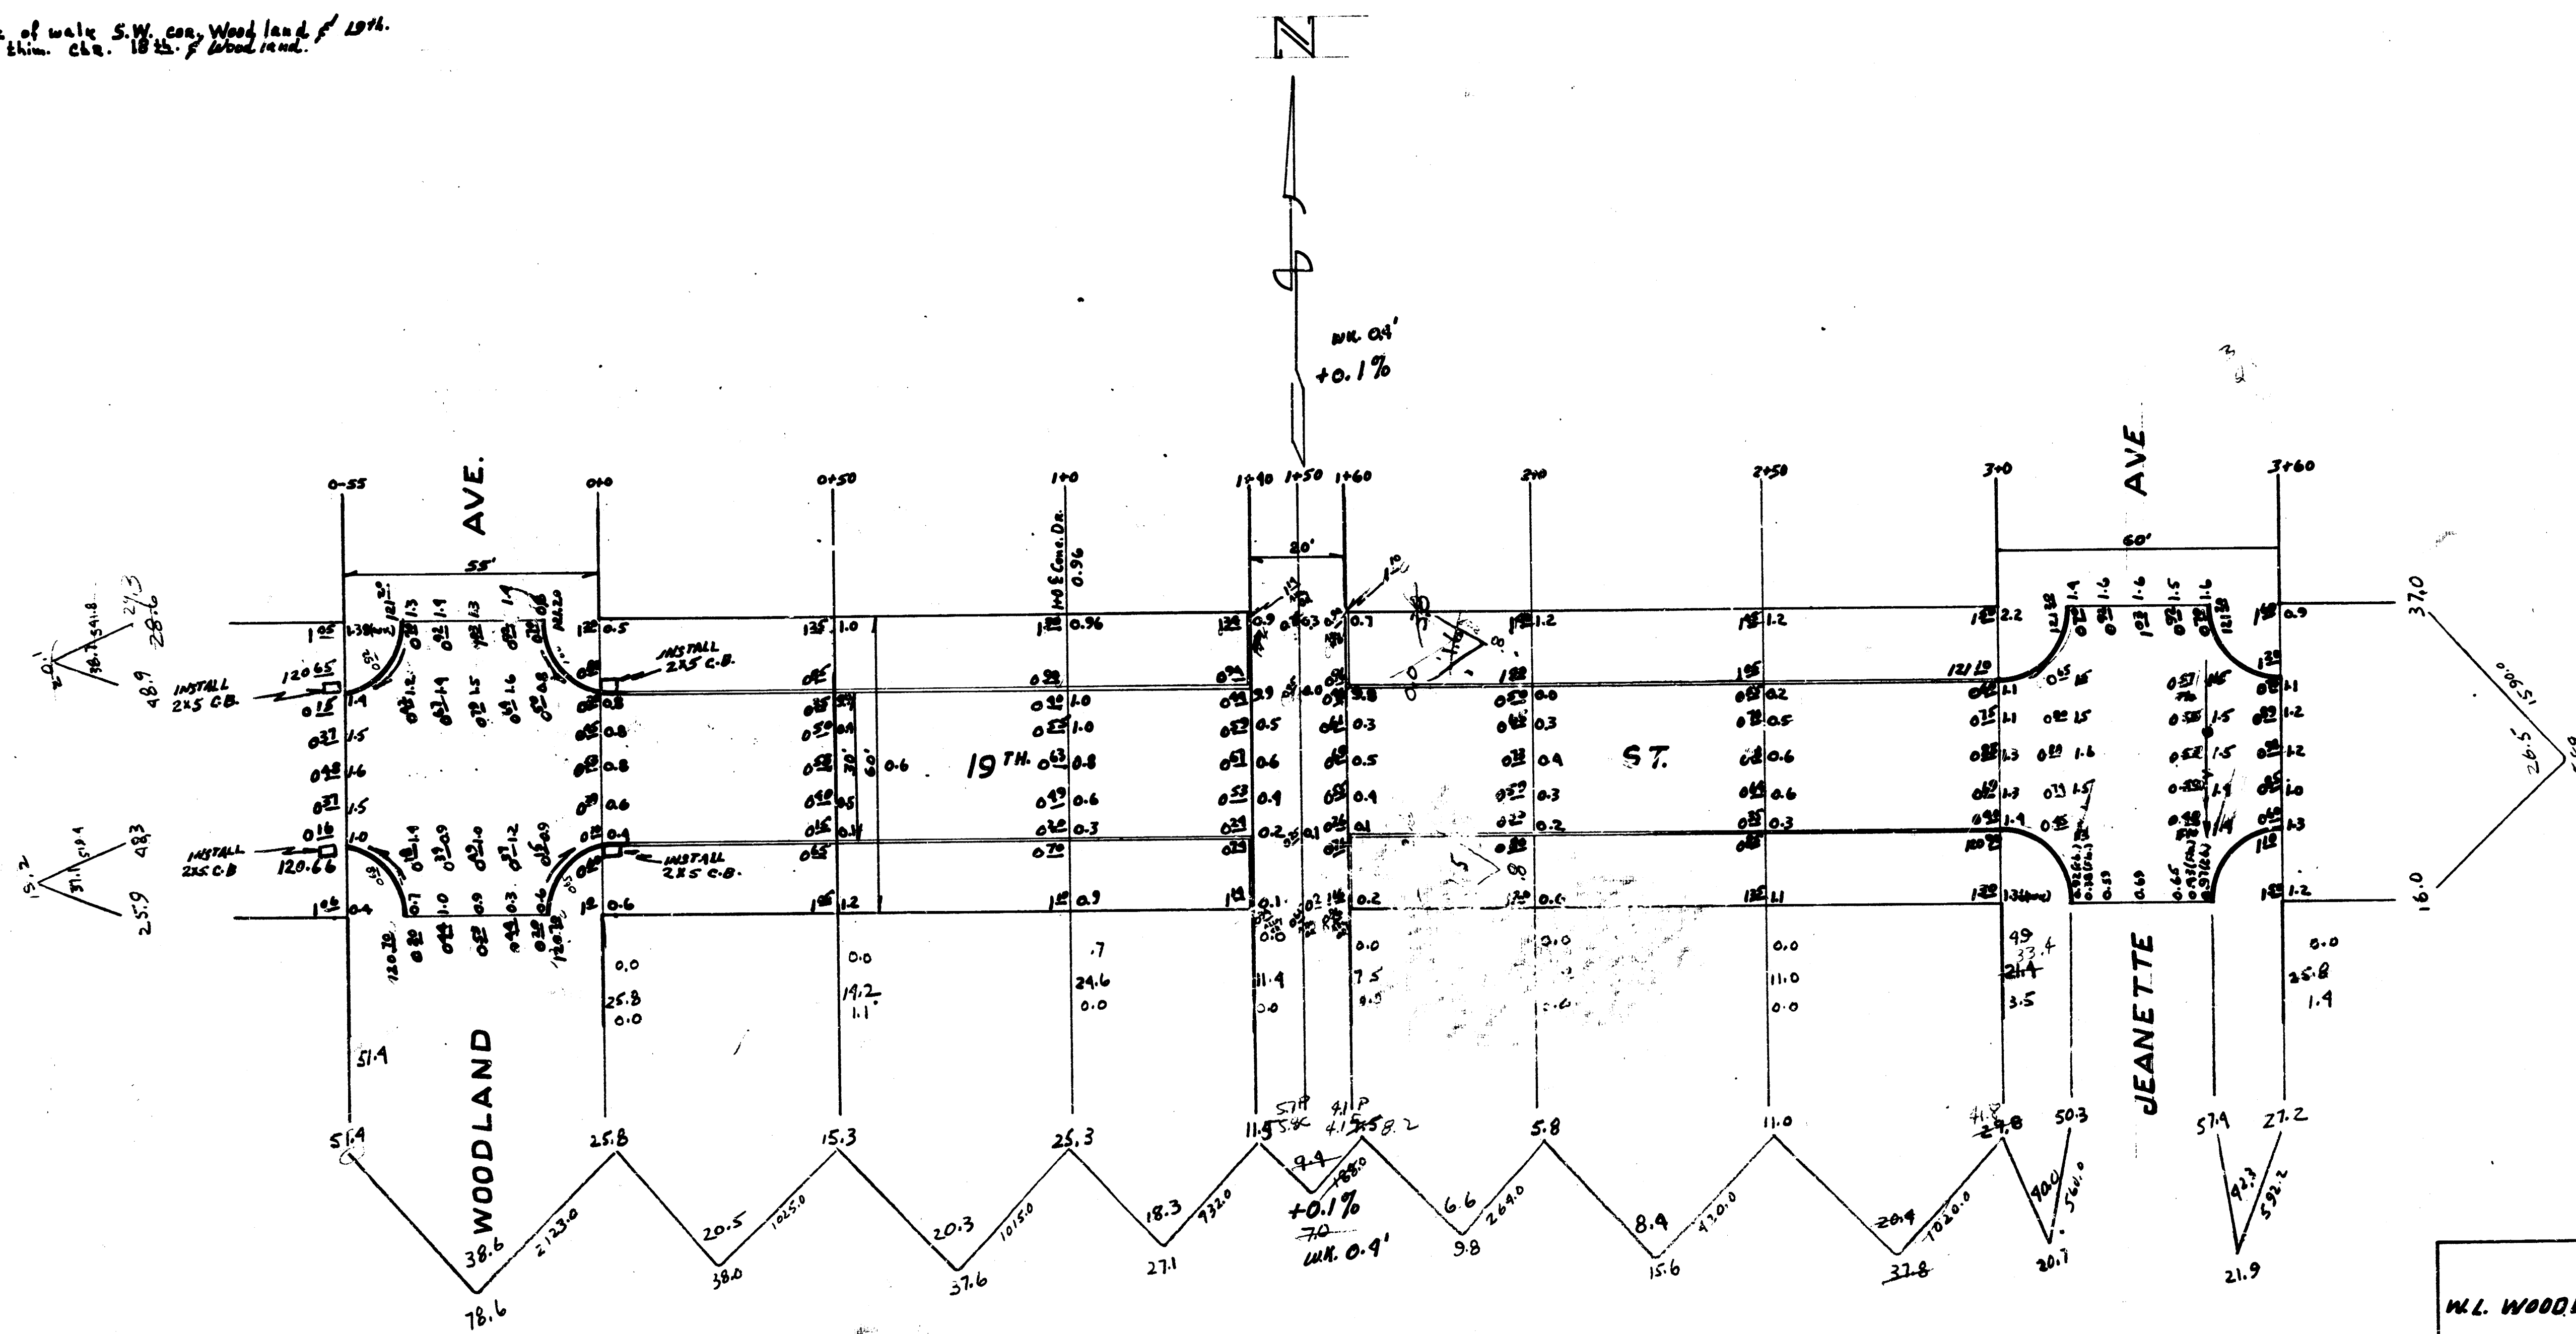

19TH ST.
 W.L. WOODLAND W.L. JEANETTE
 30' CONC. / CB
 CITY OF WICHITA, KANSAS
 L.K. WHITE CITY ENGINEER
 JULY, 1947

15 4 5

B.M. 12156 "X" on front of W.C. Slat Canyon, 1115 & Woodland
 B.M. 12010 "O" in Globe End of ch. 43, Jeanette S.E. 1115
 B.M. 12181 Top of old step on old Tele. Pole. Sump 15' N. of line of Sta 6100

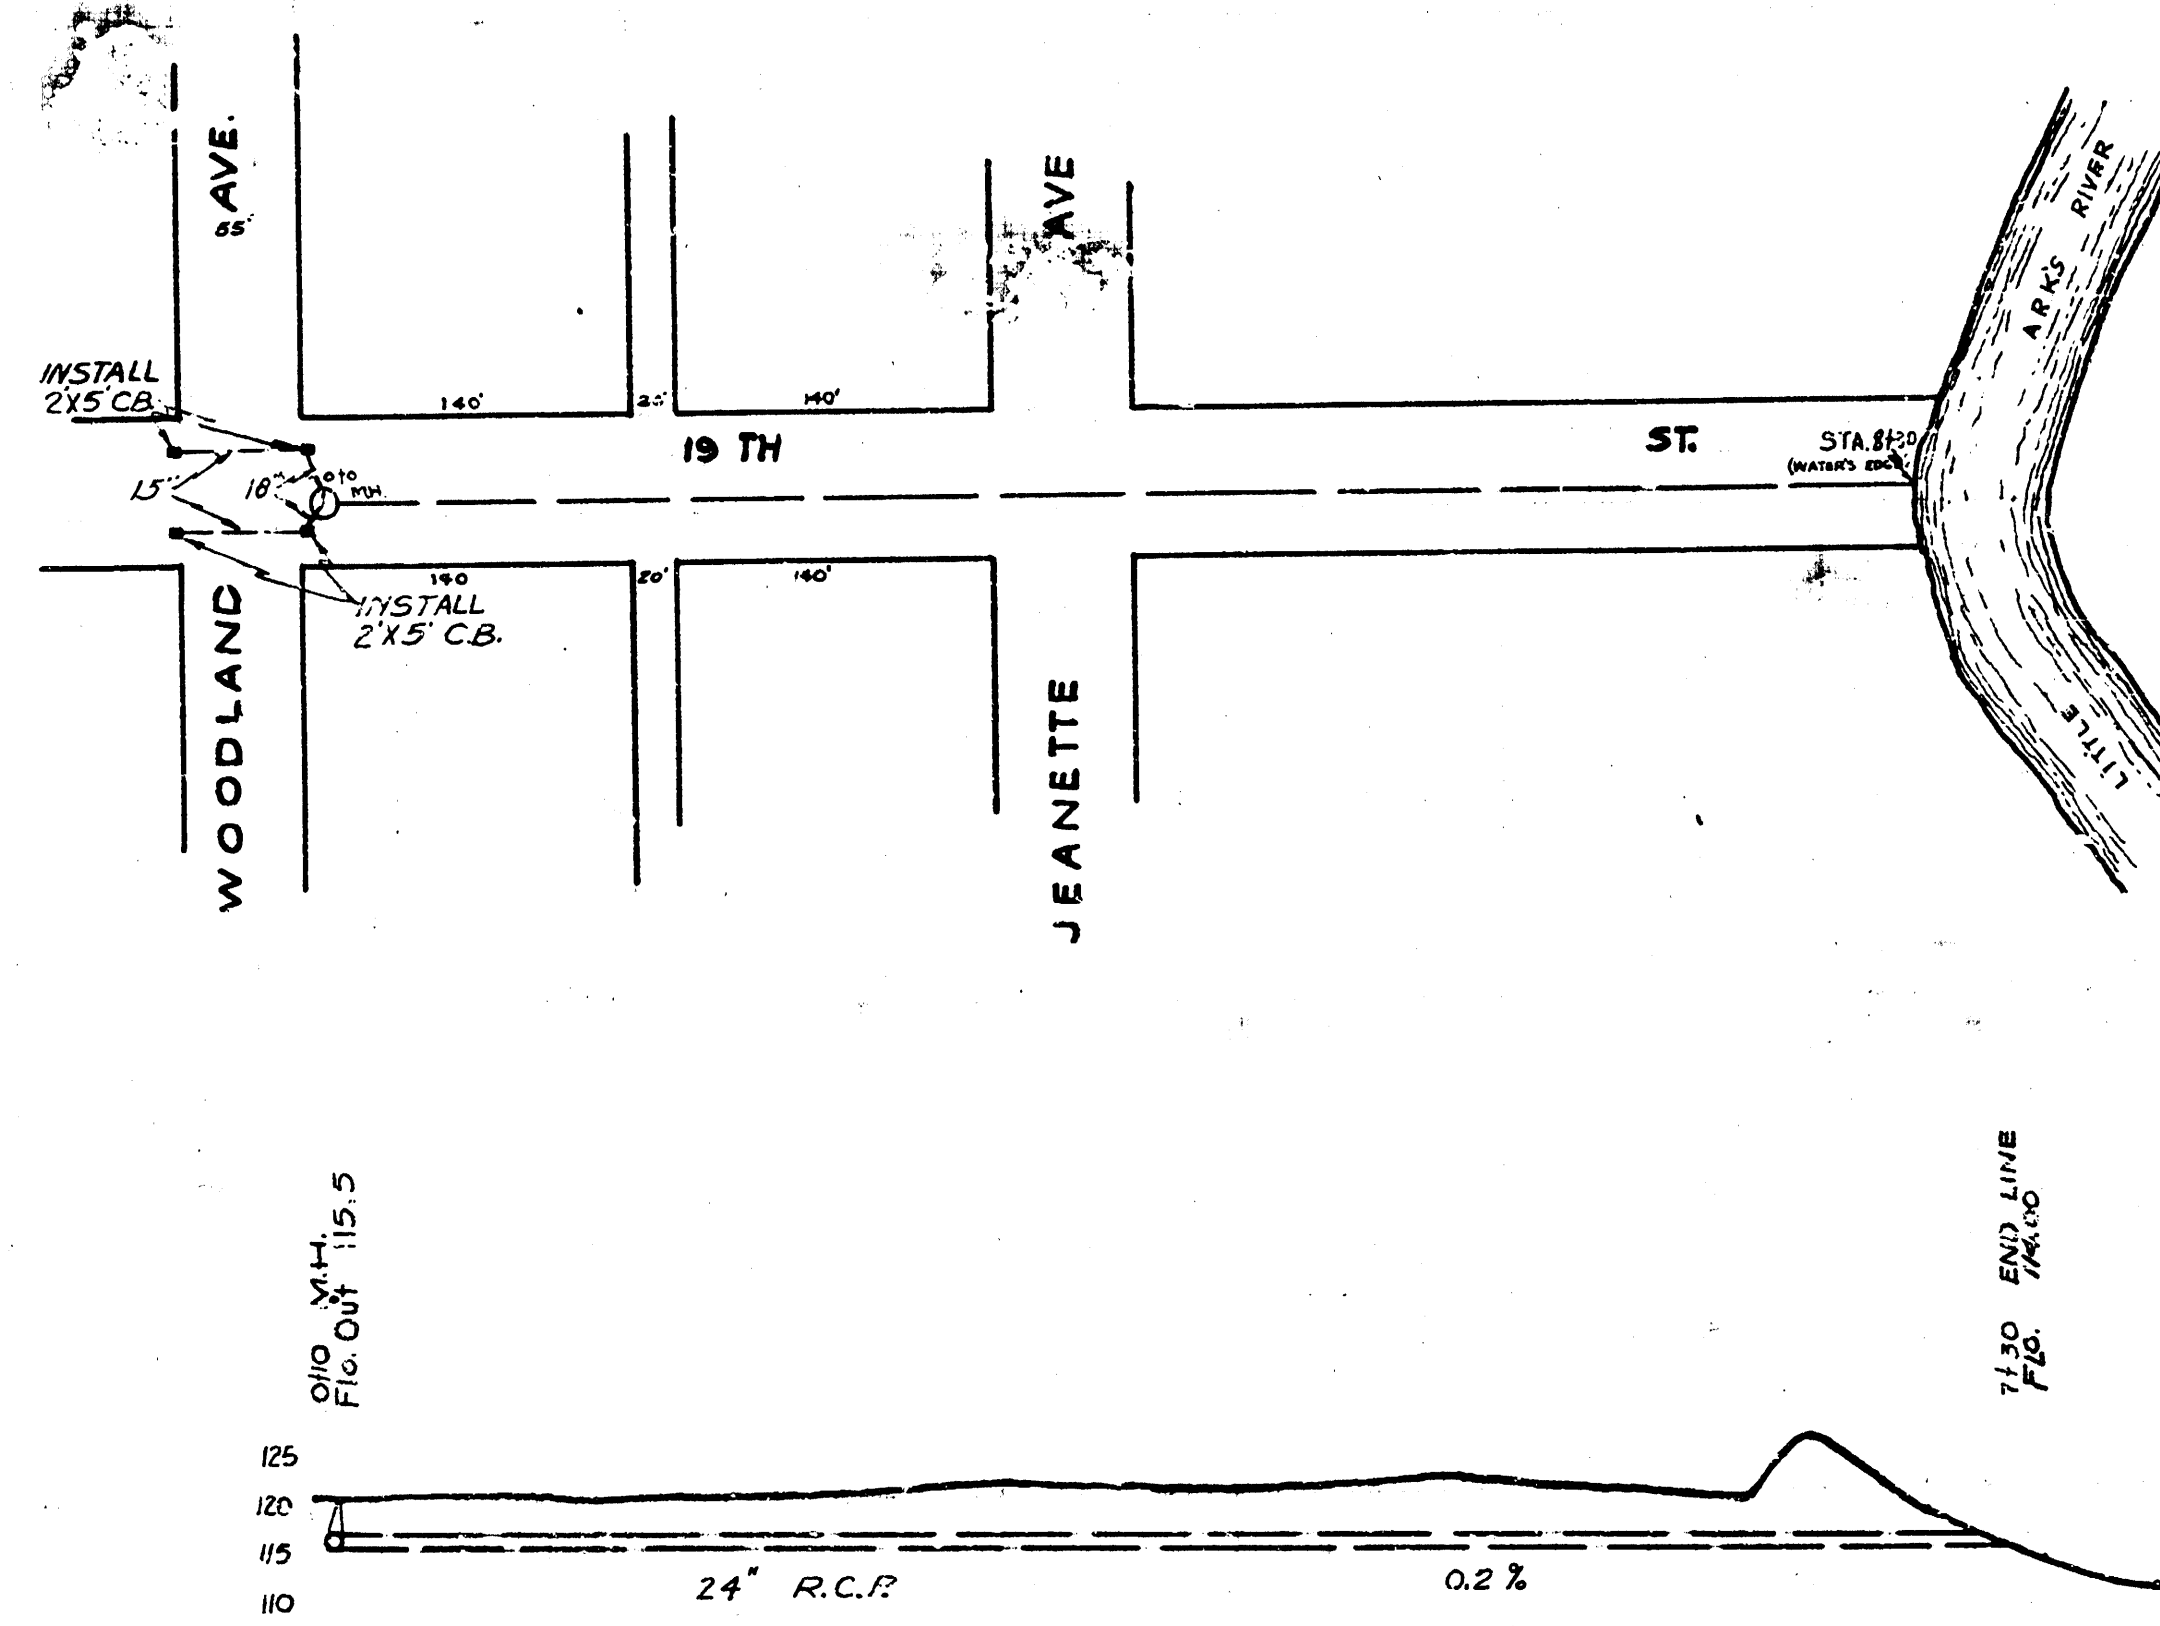

INCIDENTAL DRAINAGE
 IN CONNECTION WITH PAVEMENT
 19th ST - WOODLAND TO JEANETTE