



BM 122.40 "K" in Kensler. Nend W. So. S.W. Cor. Salina to 1974
 B.M. 124.40 Step Bench 2nd Power Pole W. of Salina 55 2074
 B.M. 122.65 "O" in Globe. N. end E. Co. E. Side Burns 55 2074

Prop. Exc.
 120.0
 104.3
 124.1
 125.2
 125.7
 96.0
 96.4
 116.6
 112.4
 97.7
 92.3
 94.4
 1336.8
 +10%
 1470.5 Sample
 -0.1019%
 W. 0.4'

City Exc.
 160.4
 +10%
 176.4 Sample

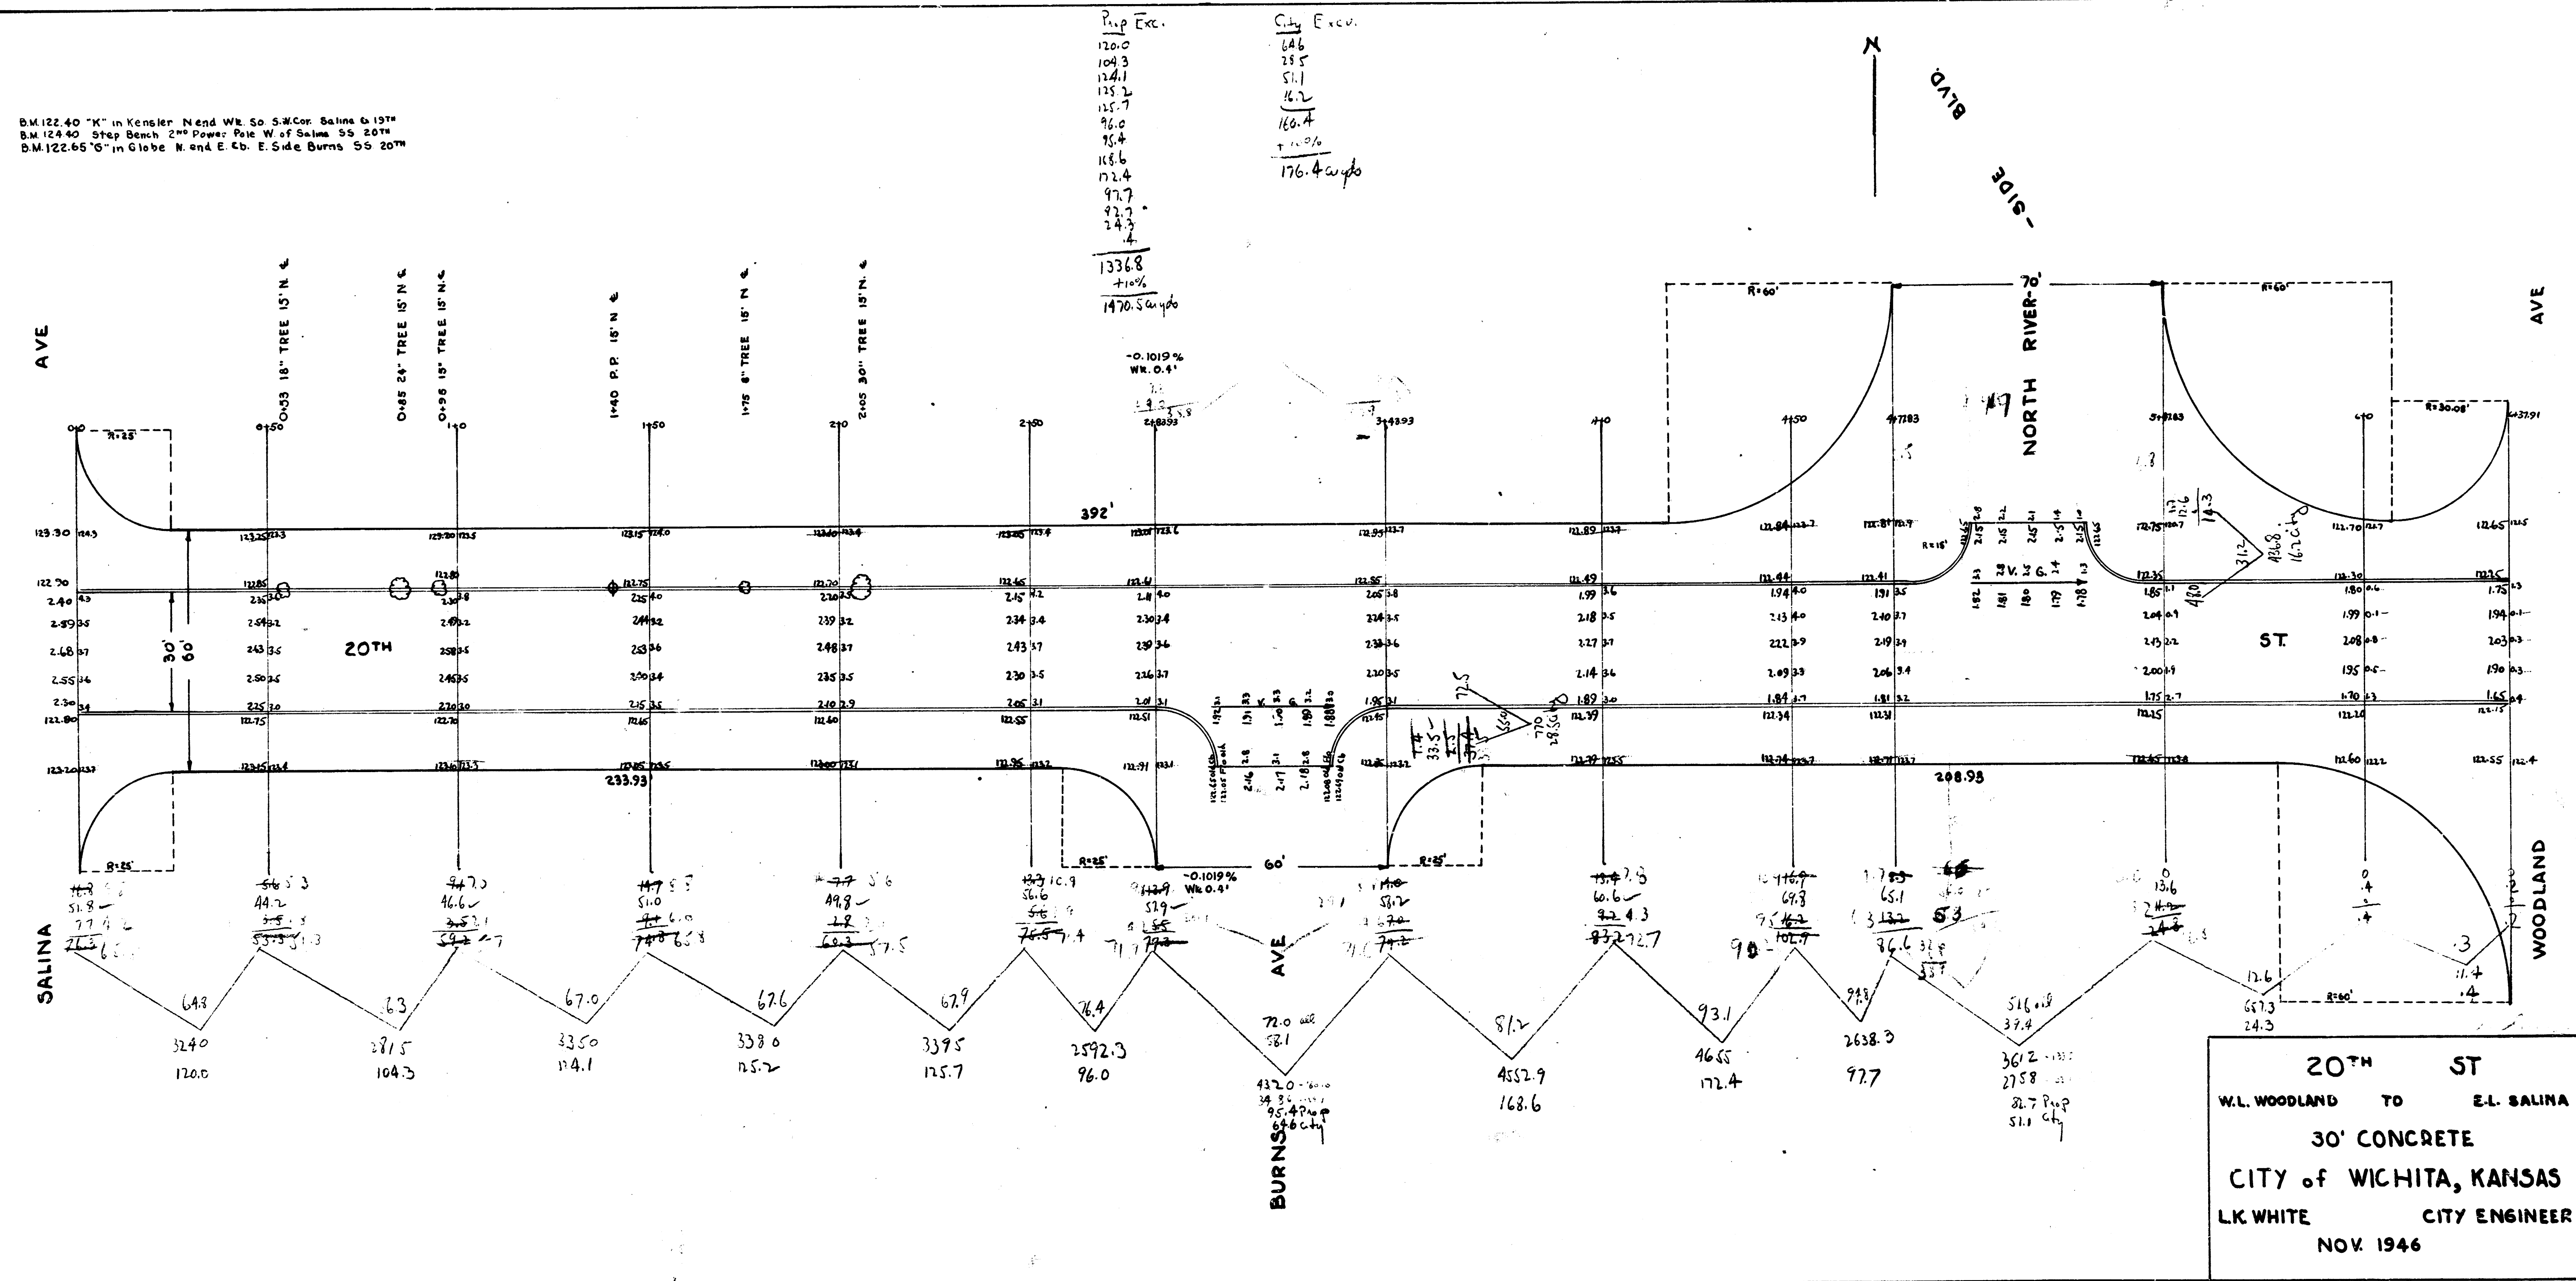

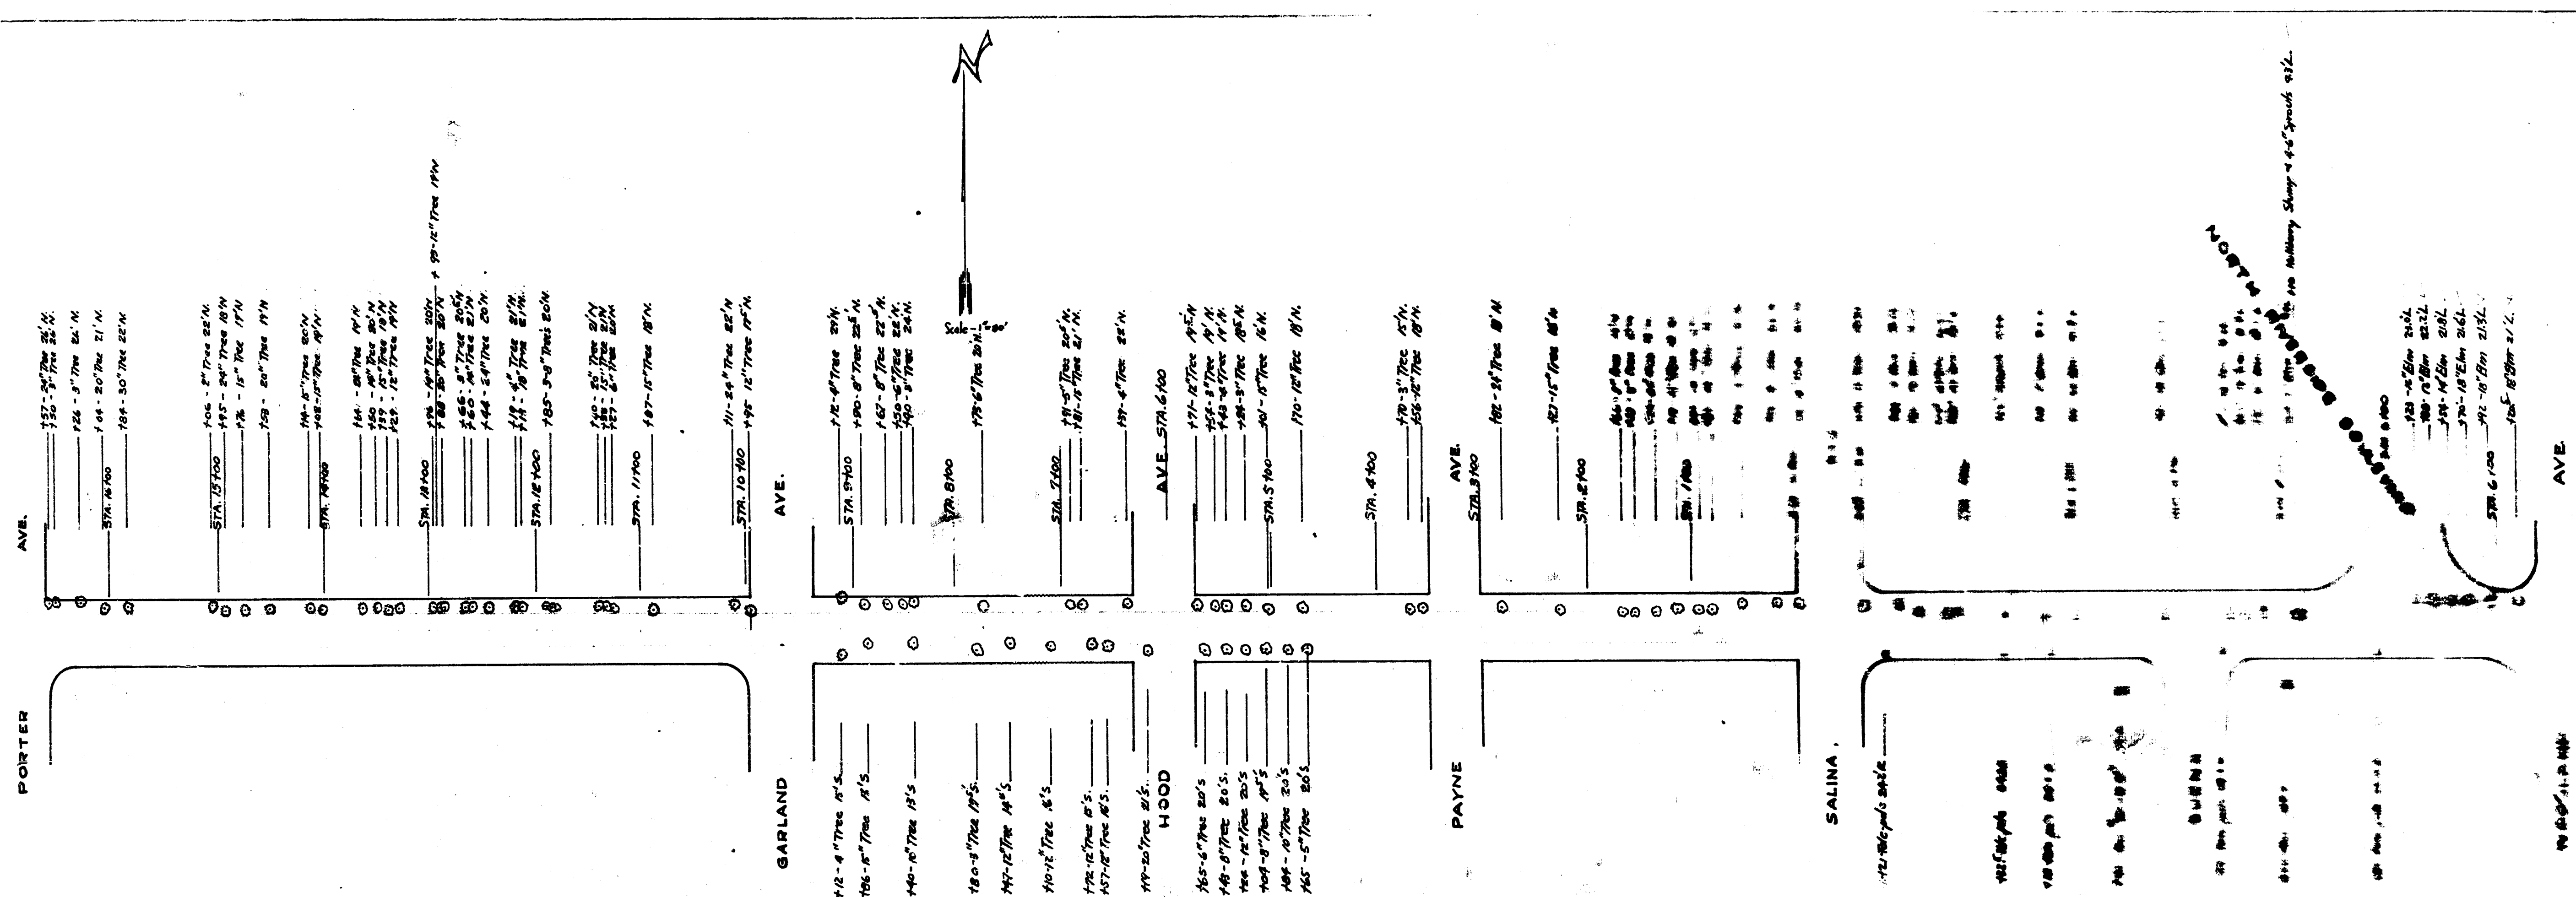

20th

PORTER to

CITY of WICHITA, KANSAS

L.R. WHITE CITY ENGINEER

JULY 1997