
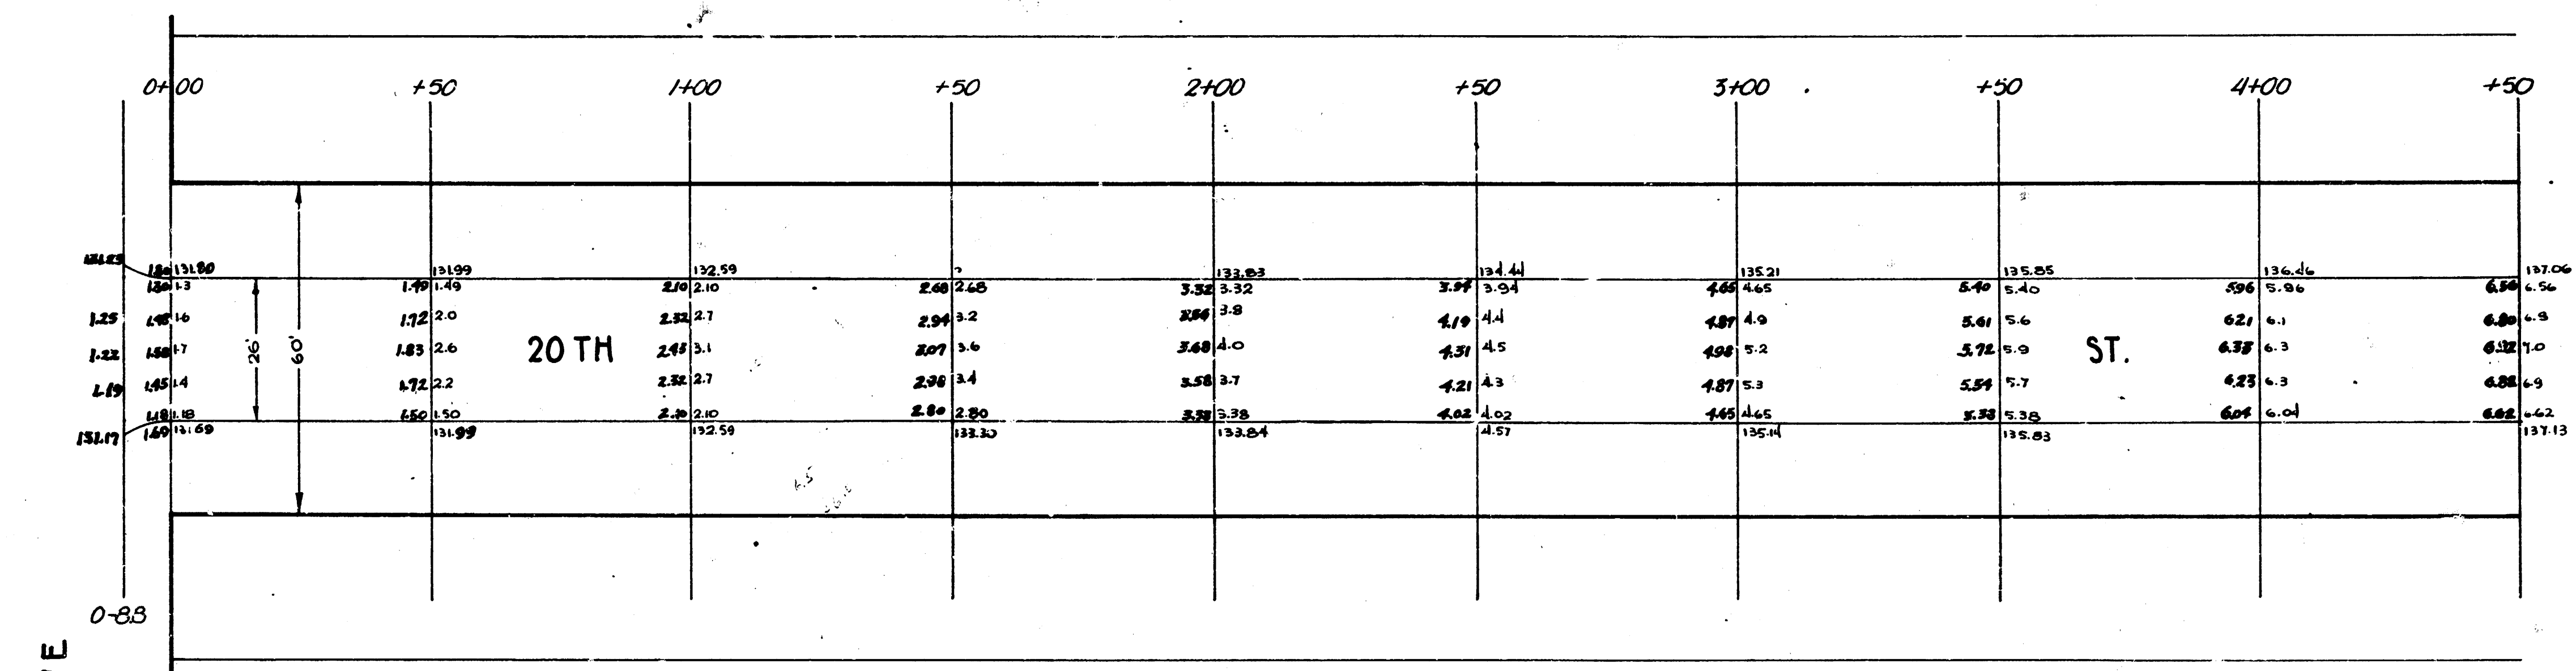



41 Y

B.M. 13371 S.E. Cor. Conc. Porch Ho. No. 2324 E. 20th.
B.M. 14347 T in Tree Five Hyd. S.W. Cor. Shadybrook f 20th.
NOTE: Stations shown are on North curb line.


ST.
0-88 E. edge Valley gutter N/S

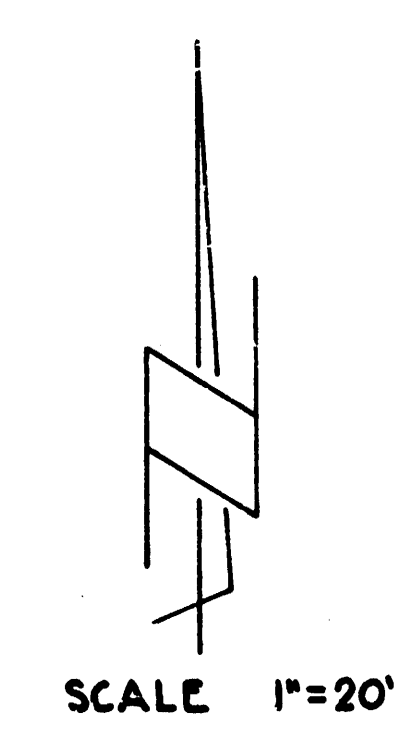

GROVE

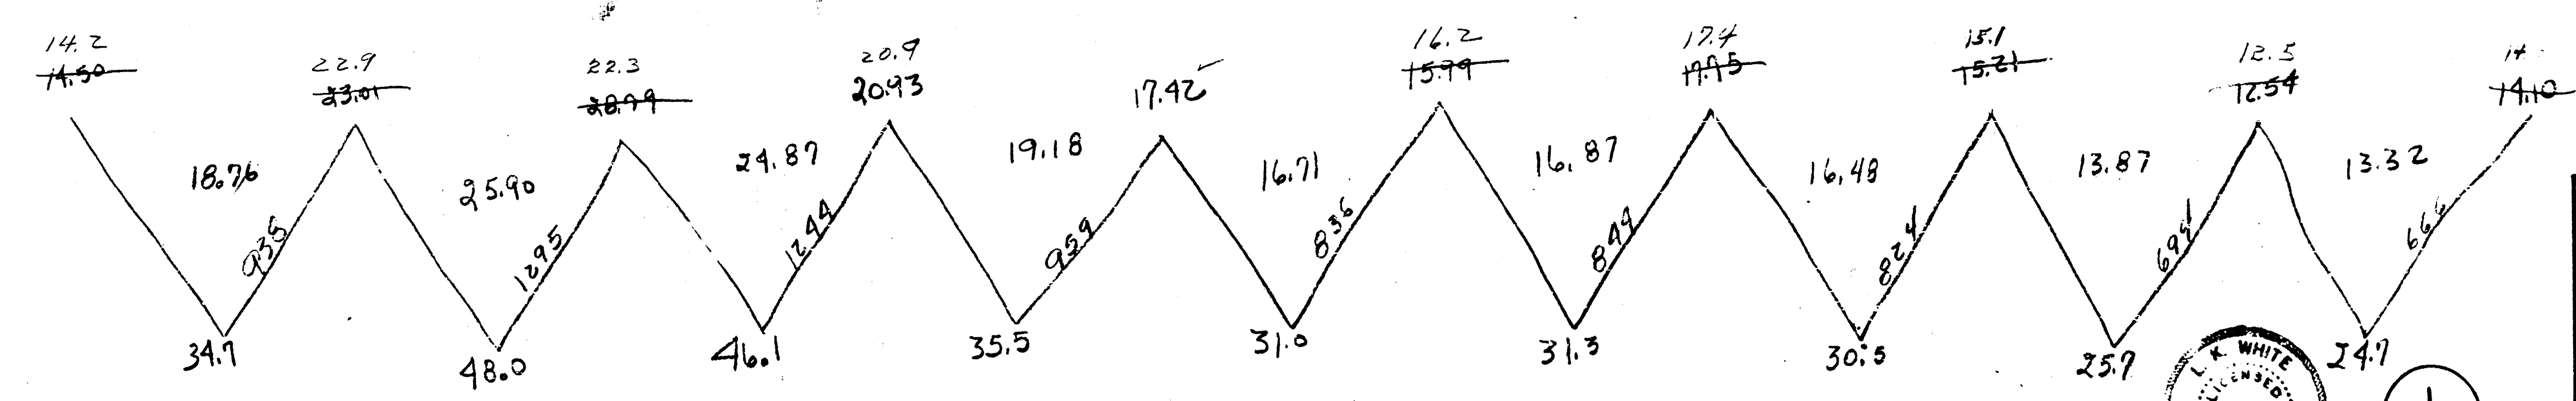


20TH ST.
E.L. GROVE ST. TO N.L. SHADYBROOK L.
26' Conc.
CITY OF WICHITA, KANSAS
L.K. WHITE
CITY ENGINEER
SEPT. 1951
PROJ. NO. C11-126

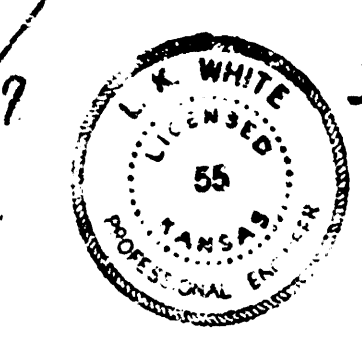

1
2

NOTE:
Stations shown are on North curb line.

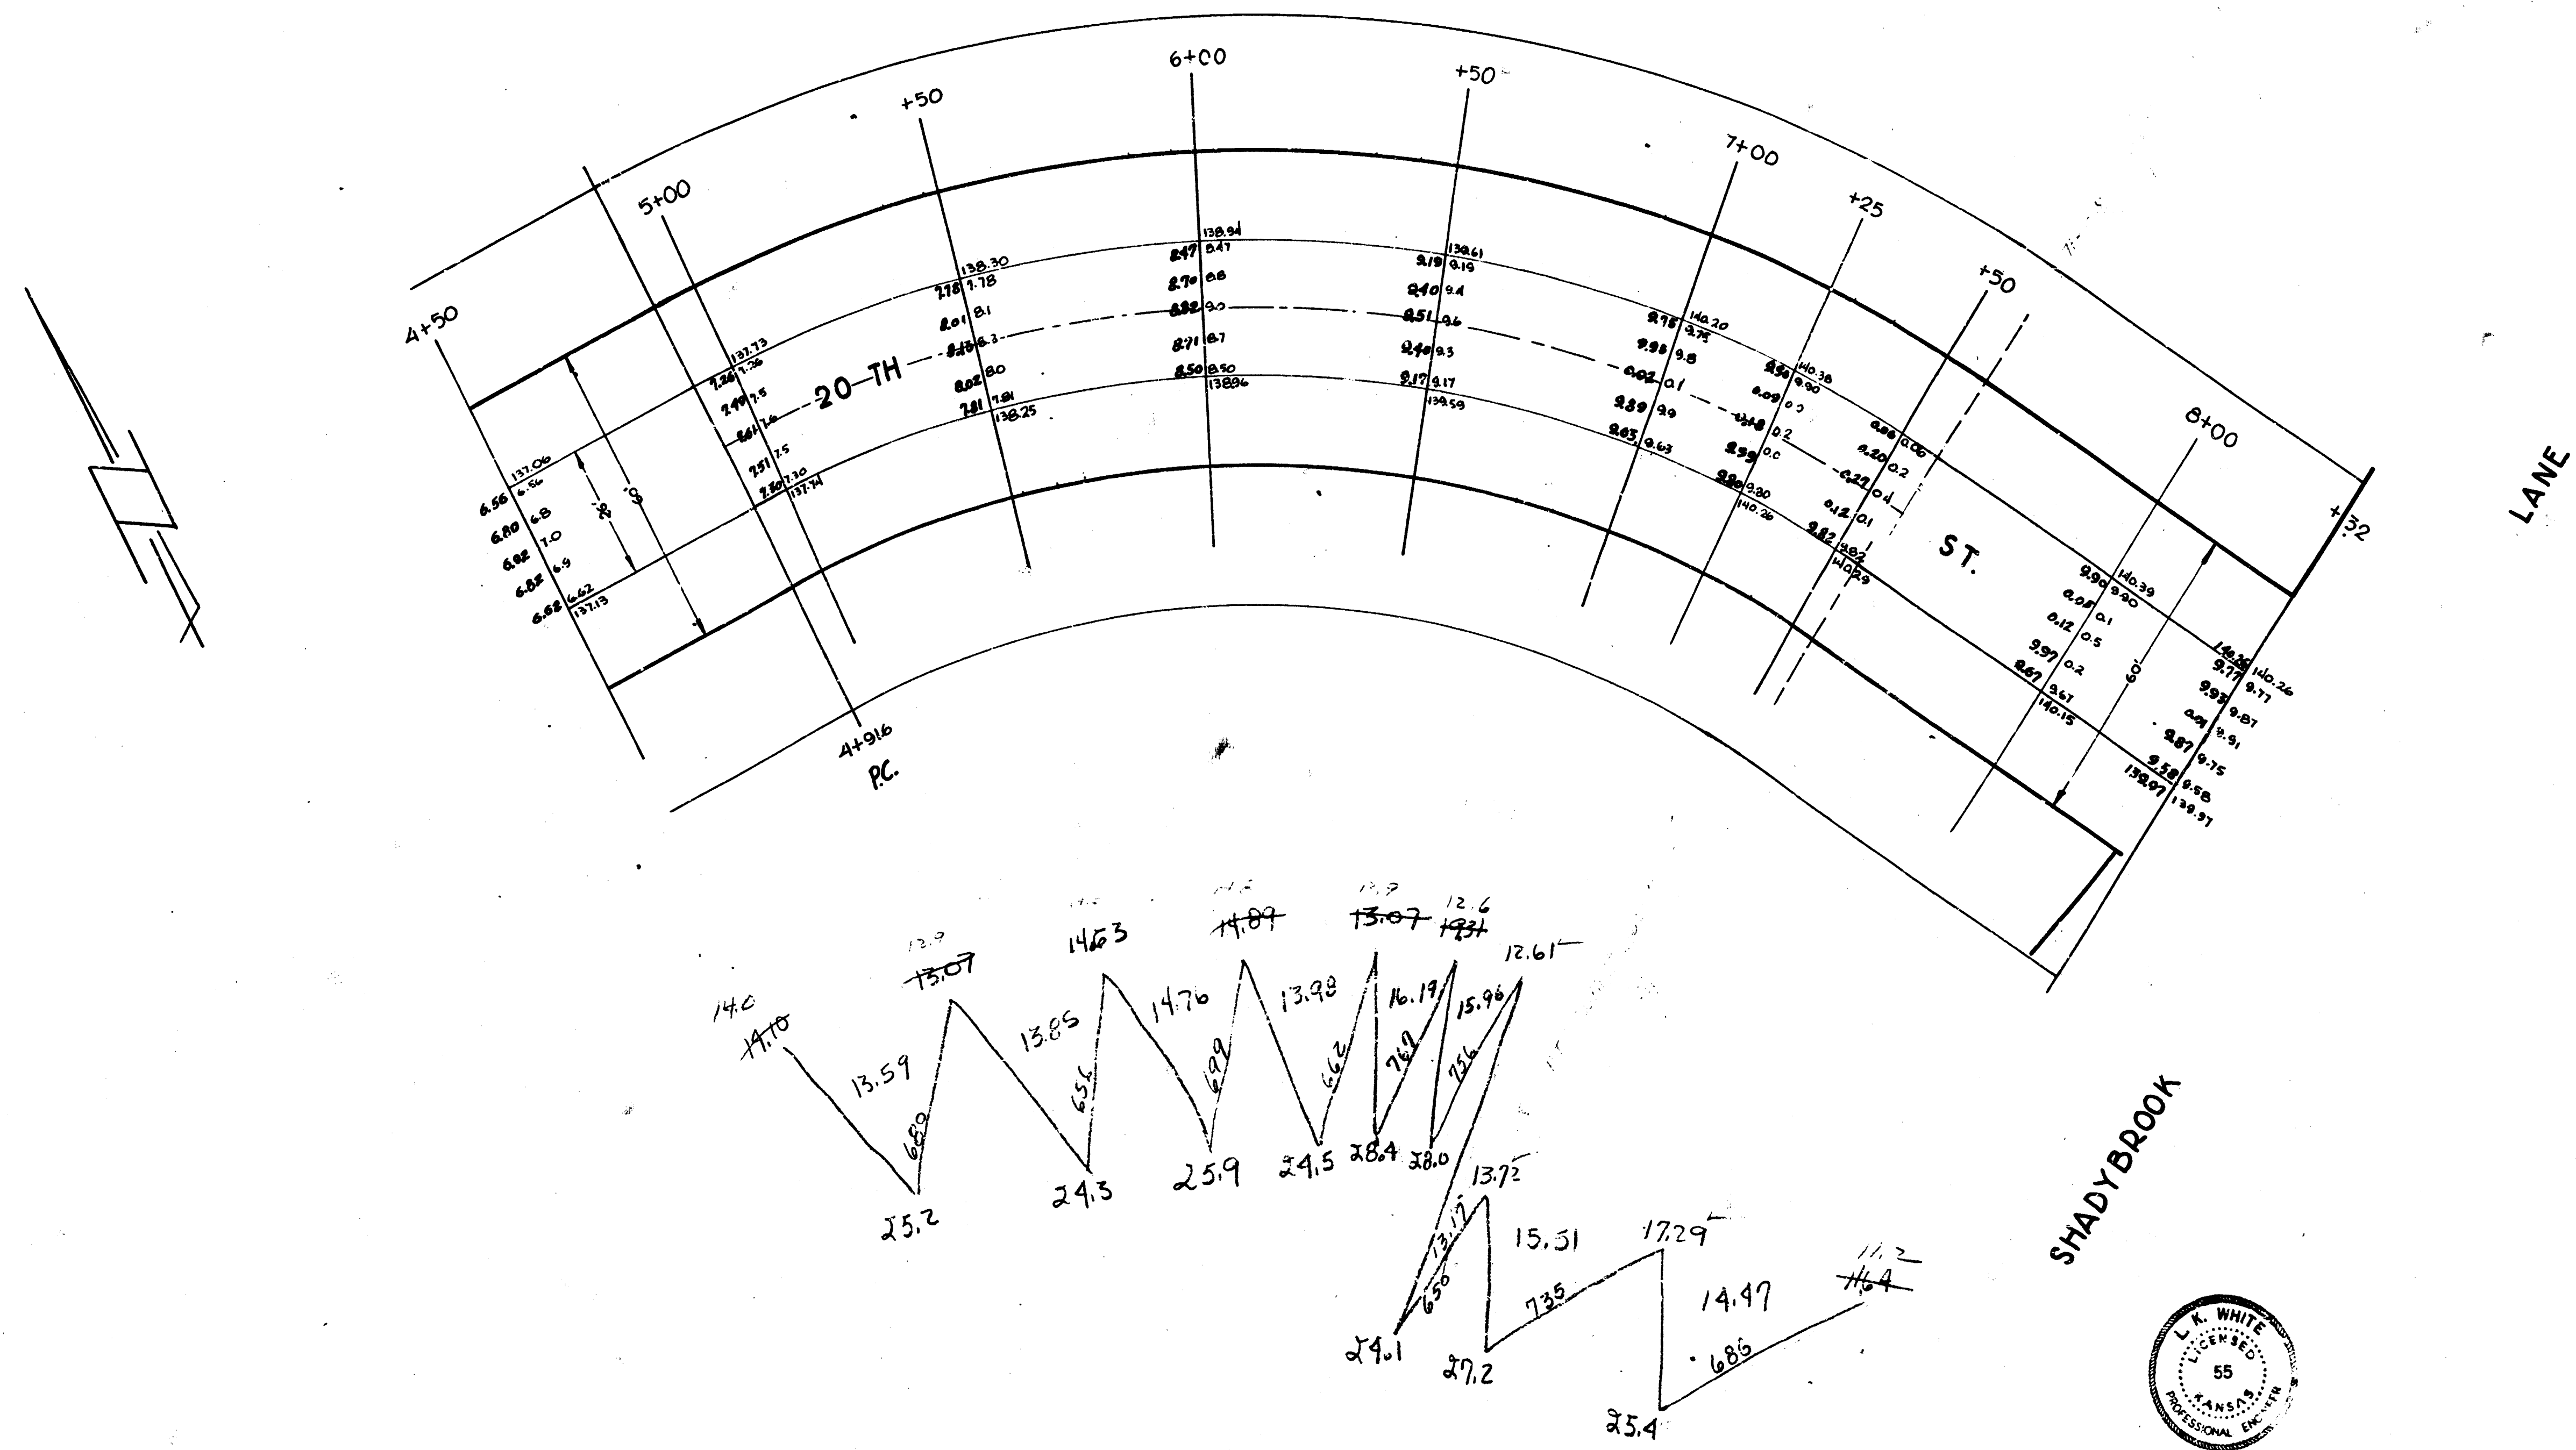

S-115

PAVING PLAN 1943

20TH ST. - E.L. GROVE ST. to NL. SHADYBROOK
Comb. Cb. & Gtr. (only)

