



B.M. 12454 C. in Center S.S. of Bldg. S.W. Cor. Park Place & 22nd

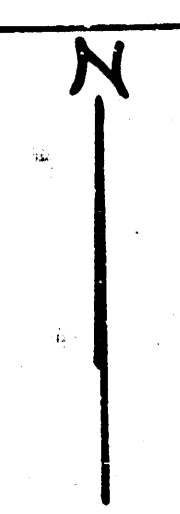

Prop
29.4
29.8
25.1
35.0
14.1
46.4
48.0
10.6
40.0
38.5
393.6
+10.92
433.0 cu yds

Cut
9.4
9.1
11.8
6.1
7.7
7.6
53.9
18.0
11.2
152.9
+10.92
163.8 cu yds

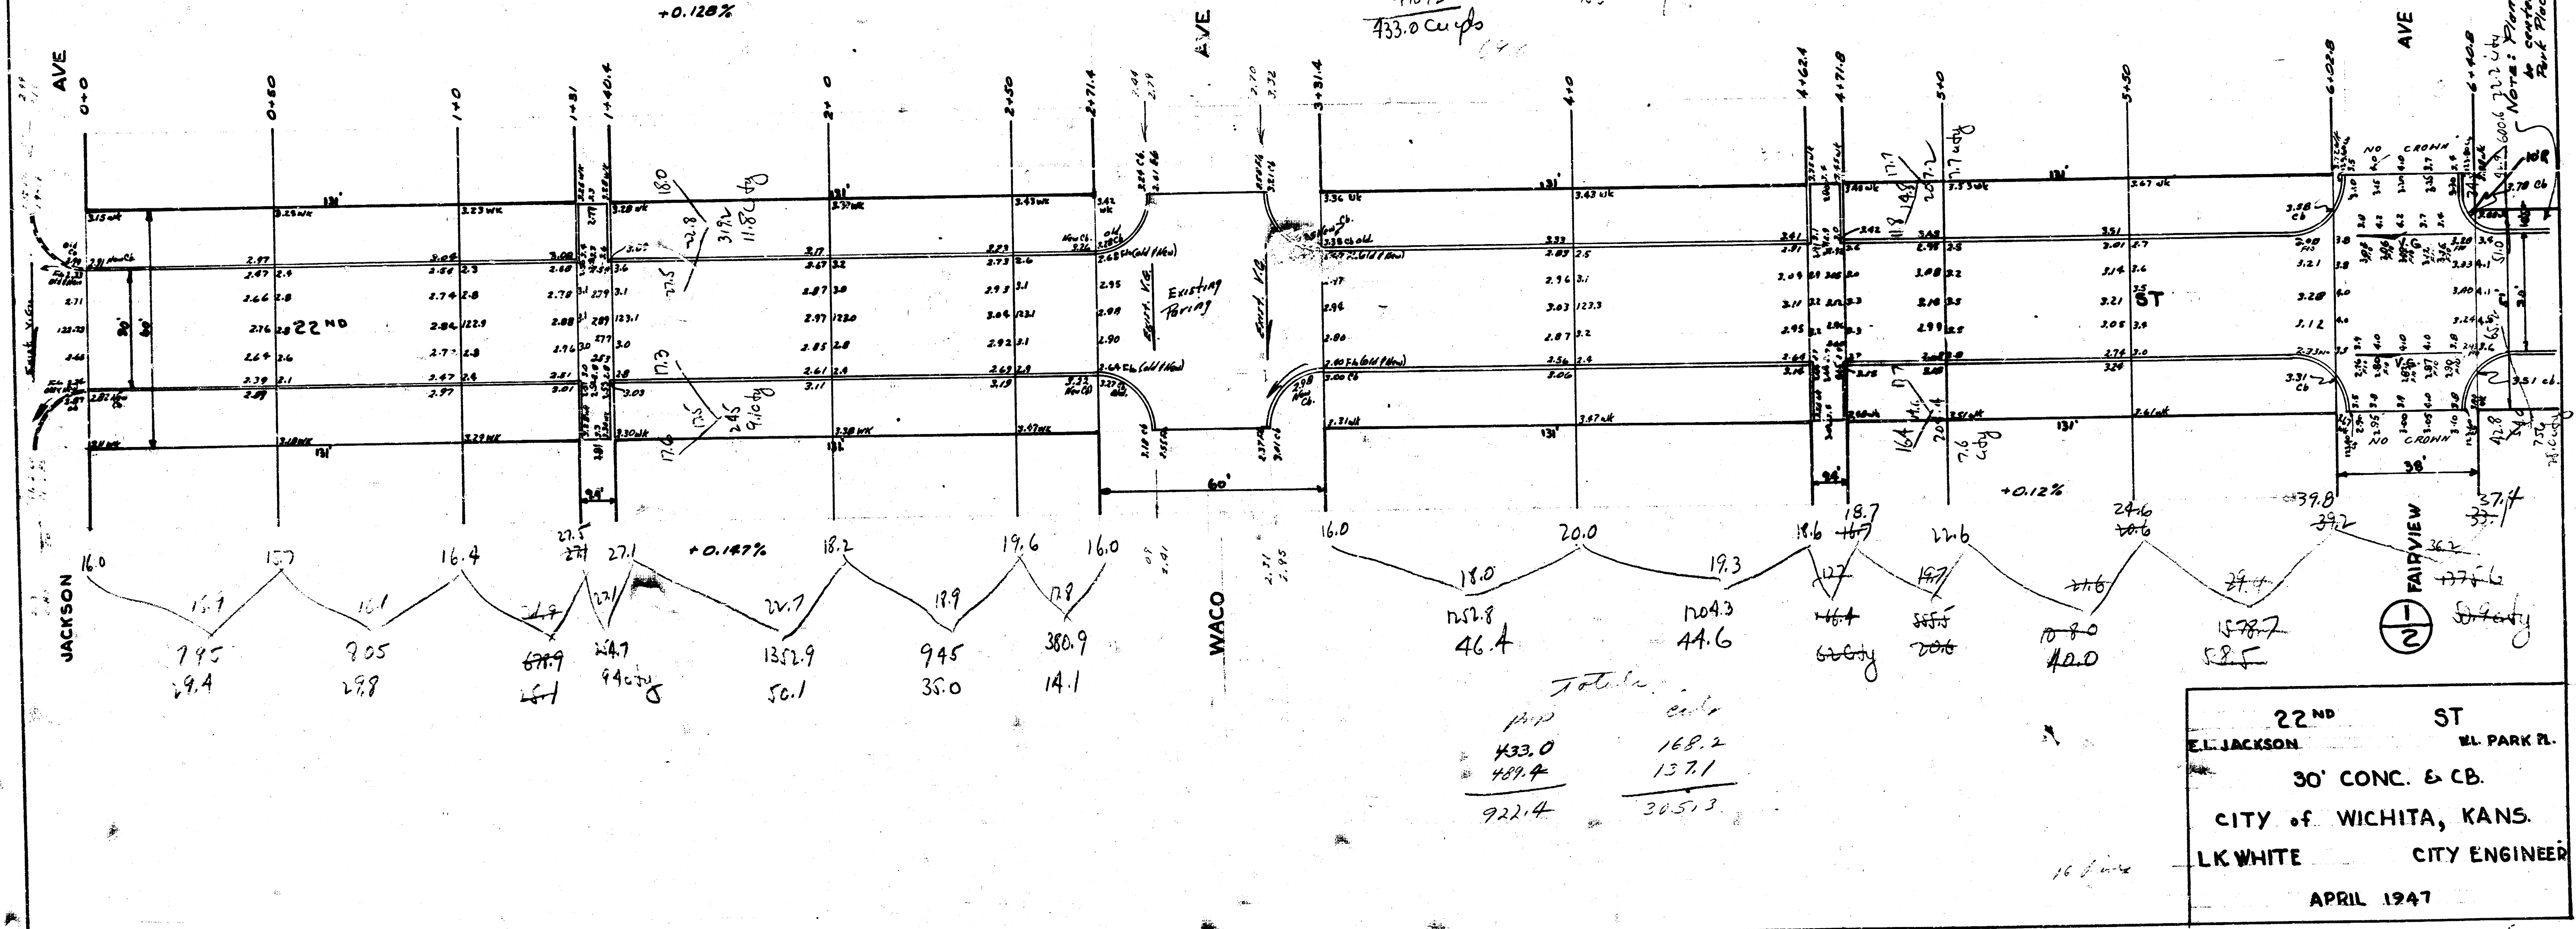


22ND ST
EL JACKSON BL PARK PL.
30' CONC. & CB.
CITY OF WICHITA, KANS.
LK WHITE CITY ENGINEER
APRIL 1947

BM. 124.54 C. in Carter S.S. 111 Bilt S.W. Cor. Park Place & 22nd

NOTE:

PLAN IN ERROR - PAVEMENT IS TO BE
CENTERED ON S.I. R/W.

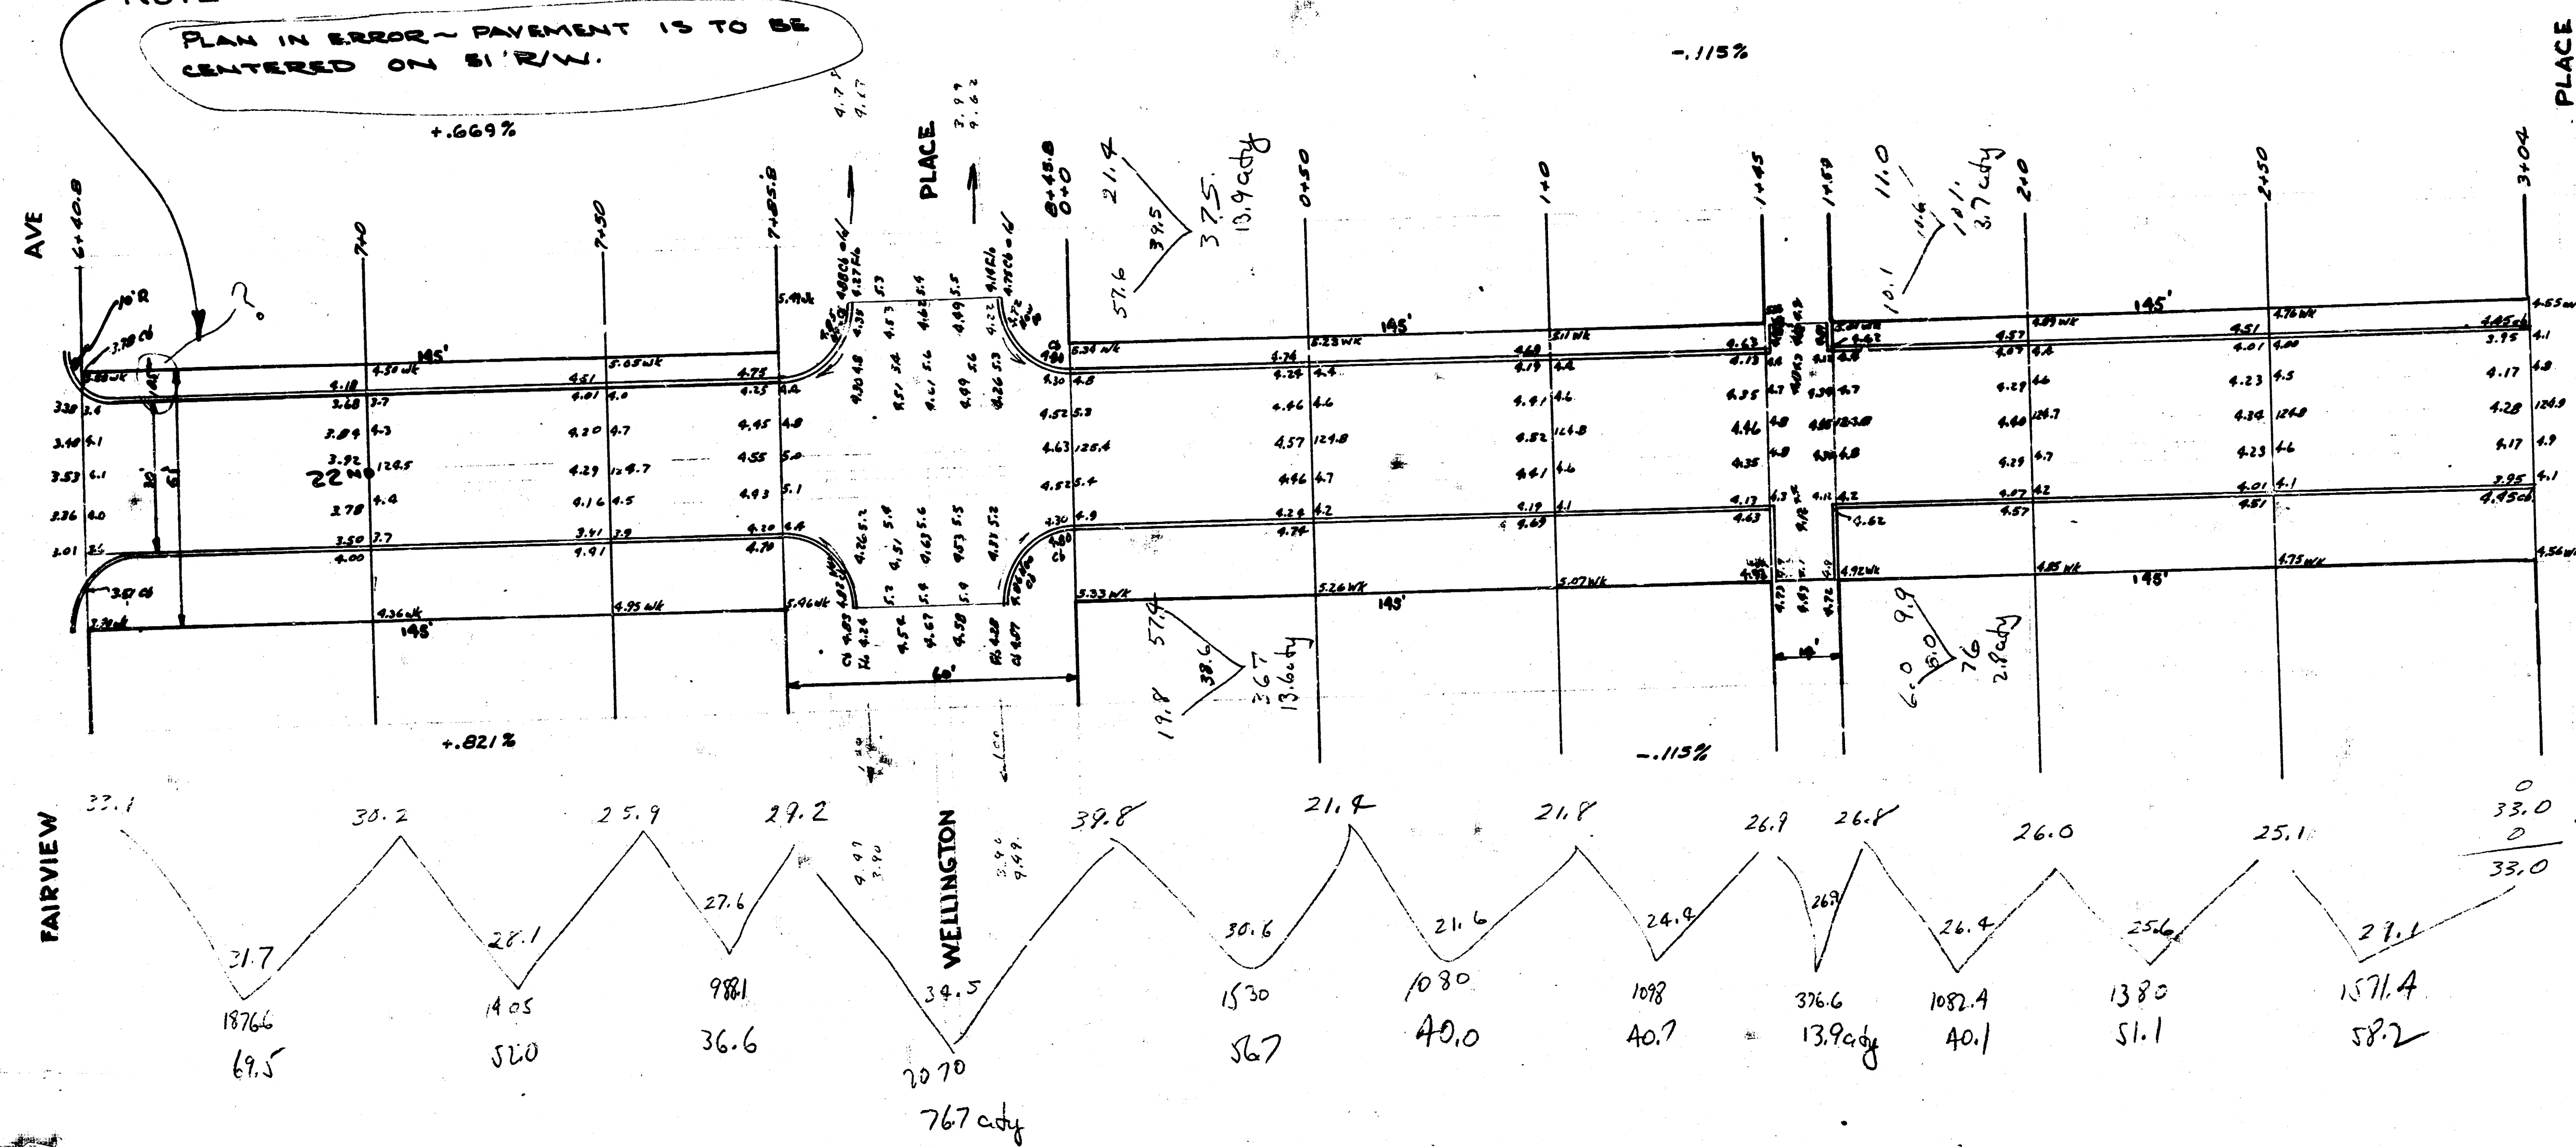

P. 100	76.7
6.5	13.9
51.0	13.6
36.6	13.9
36.7	2.8
40.0	5.7
10.7	124.6
40.1	710.6
51.1	137.1
58.2	
444.9	
710.6	
489.4	

2
2

101