
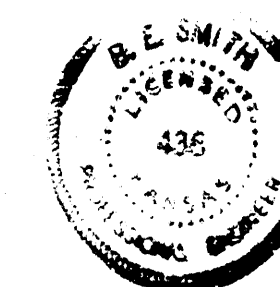
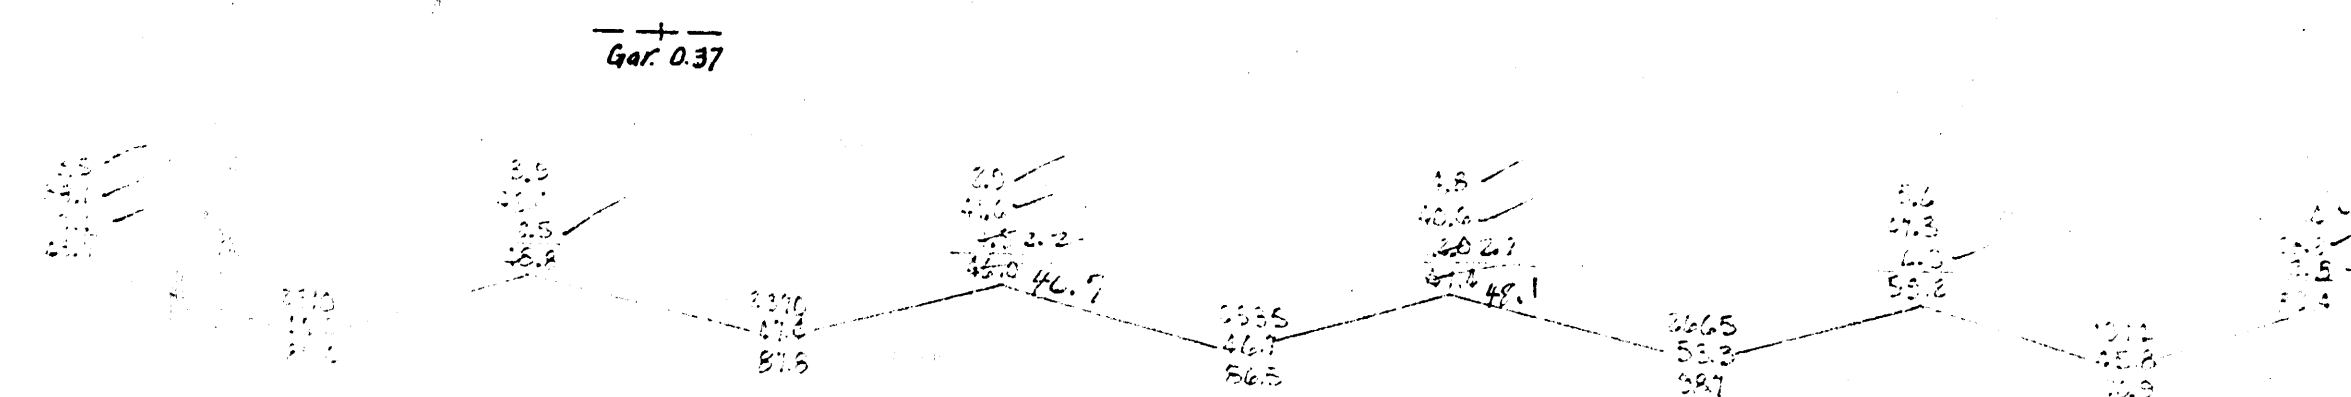


Sta. on 4

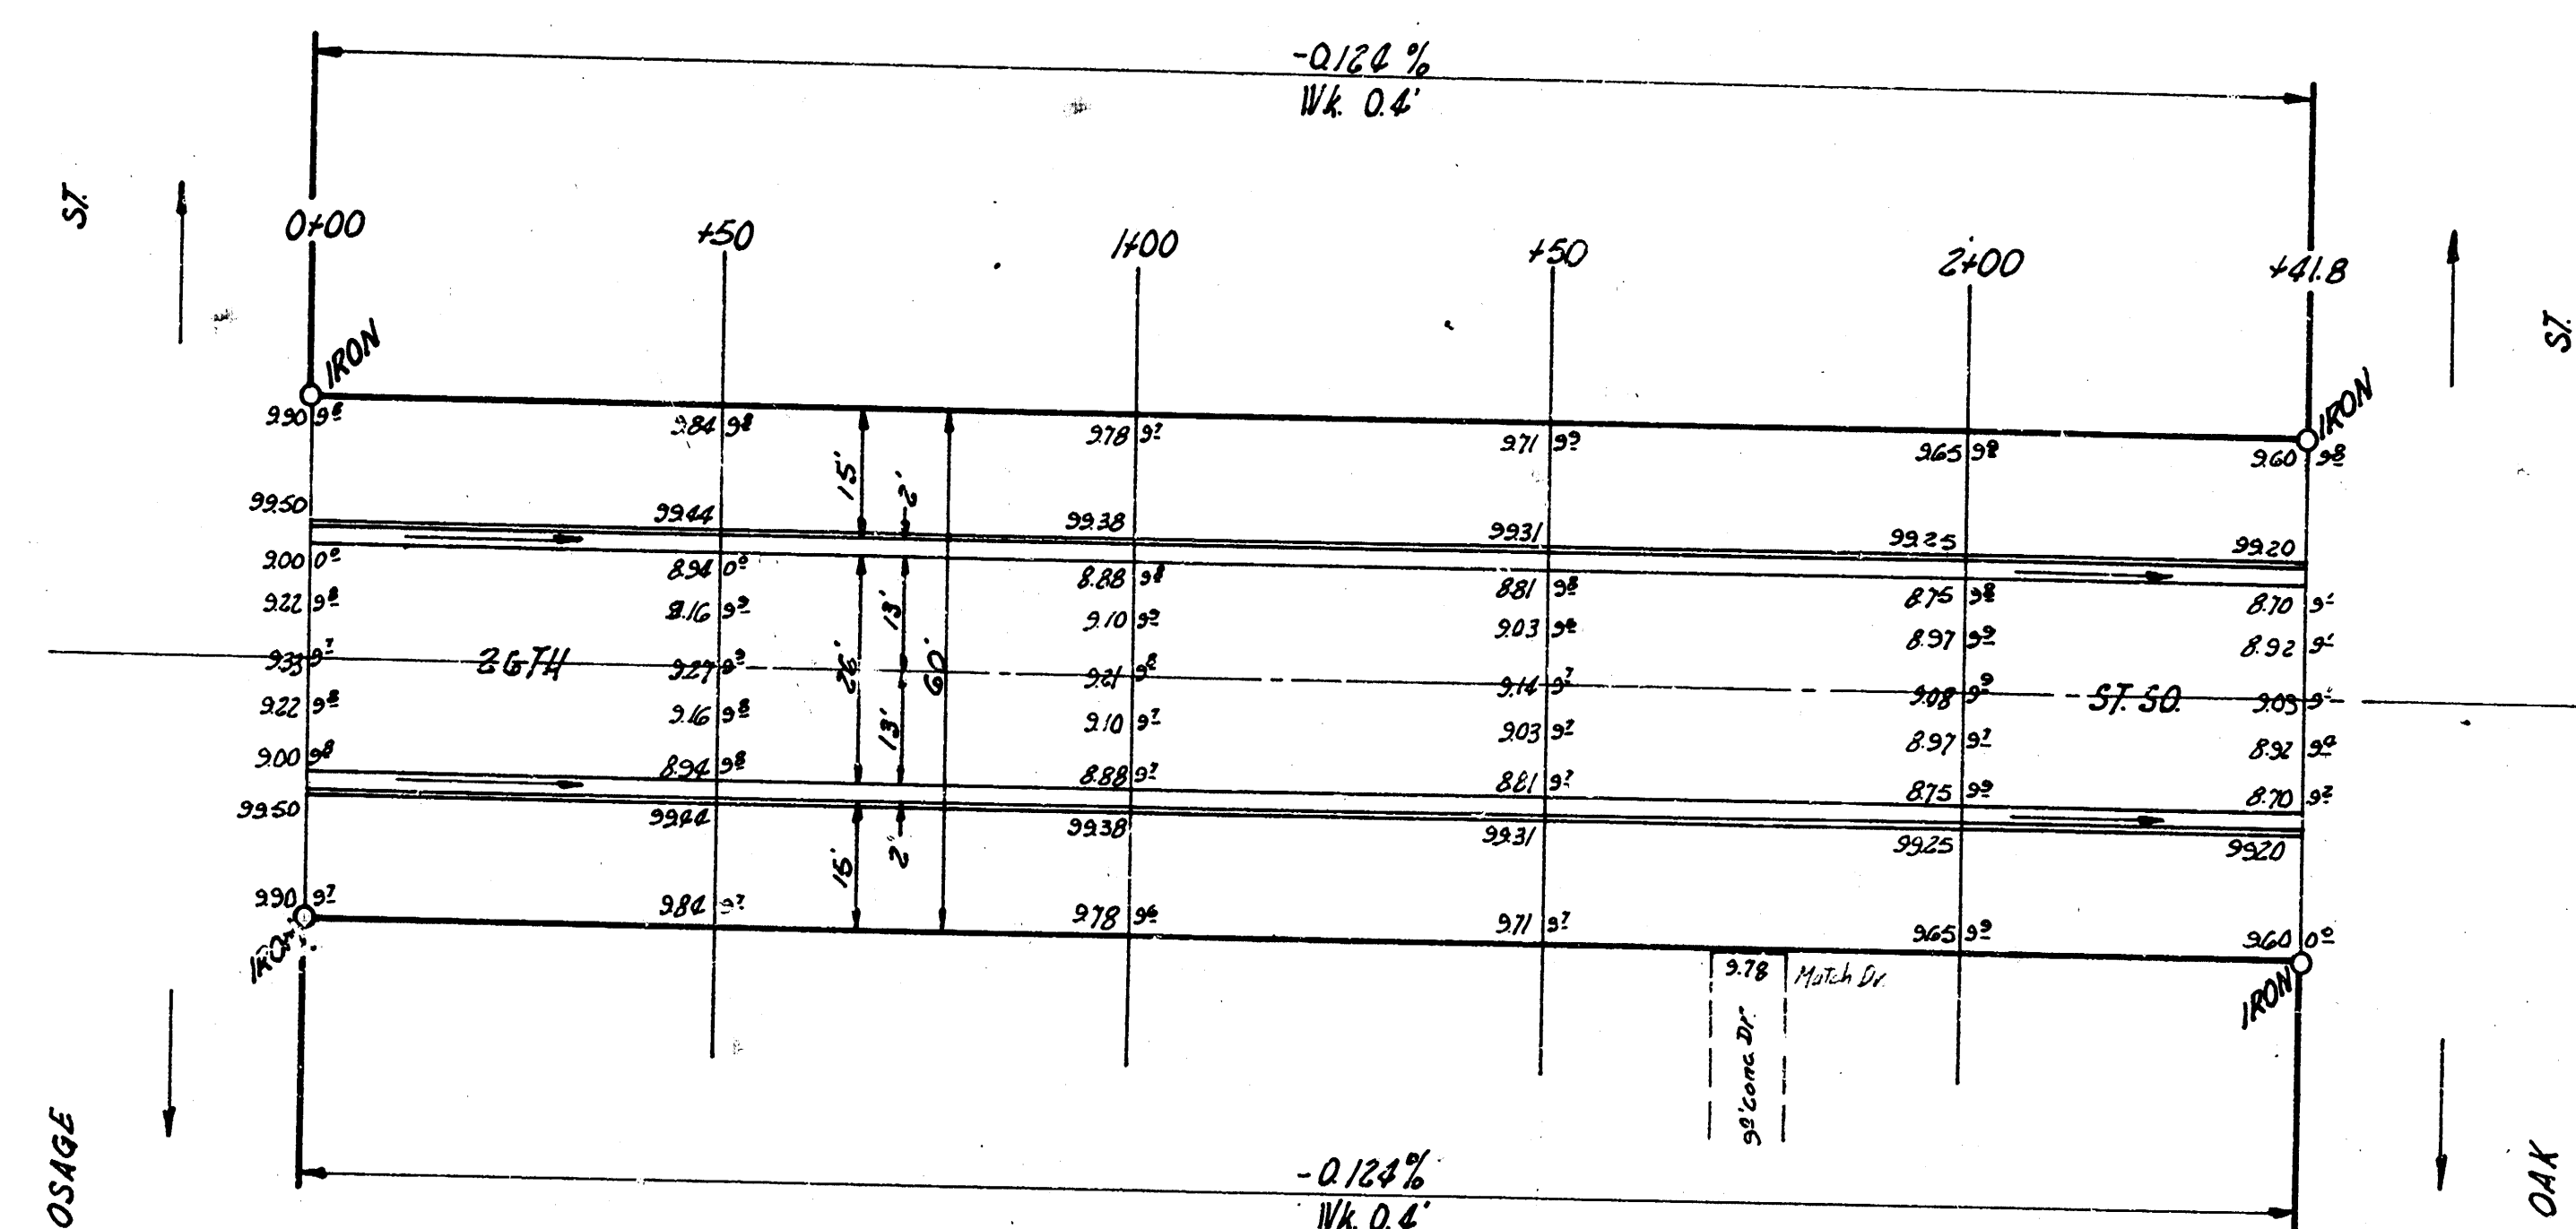

26TH ST. SO.
E.L. OSAGE - W.L. OAK.
26'-2'-30" AC.
CITY OF WICHITA, KANS.
BE. SMITH CITY ENGINEER
Feb. 1956 PROJ. NO. C15-78