



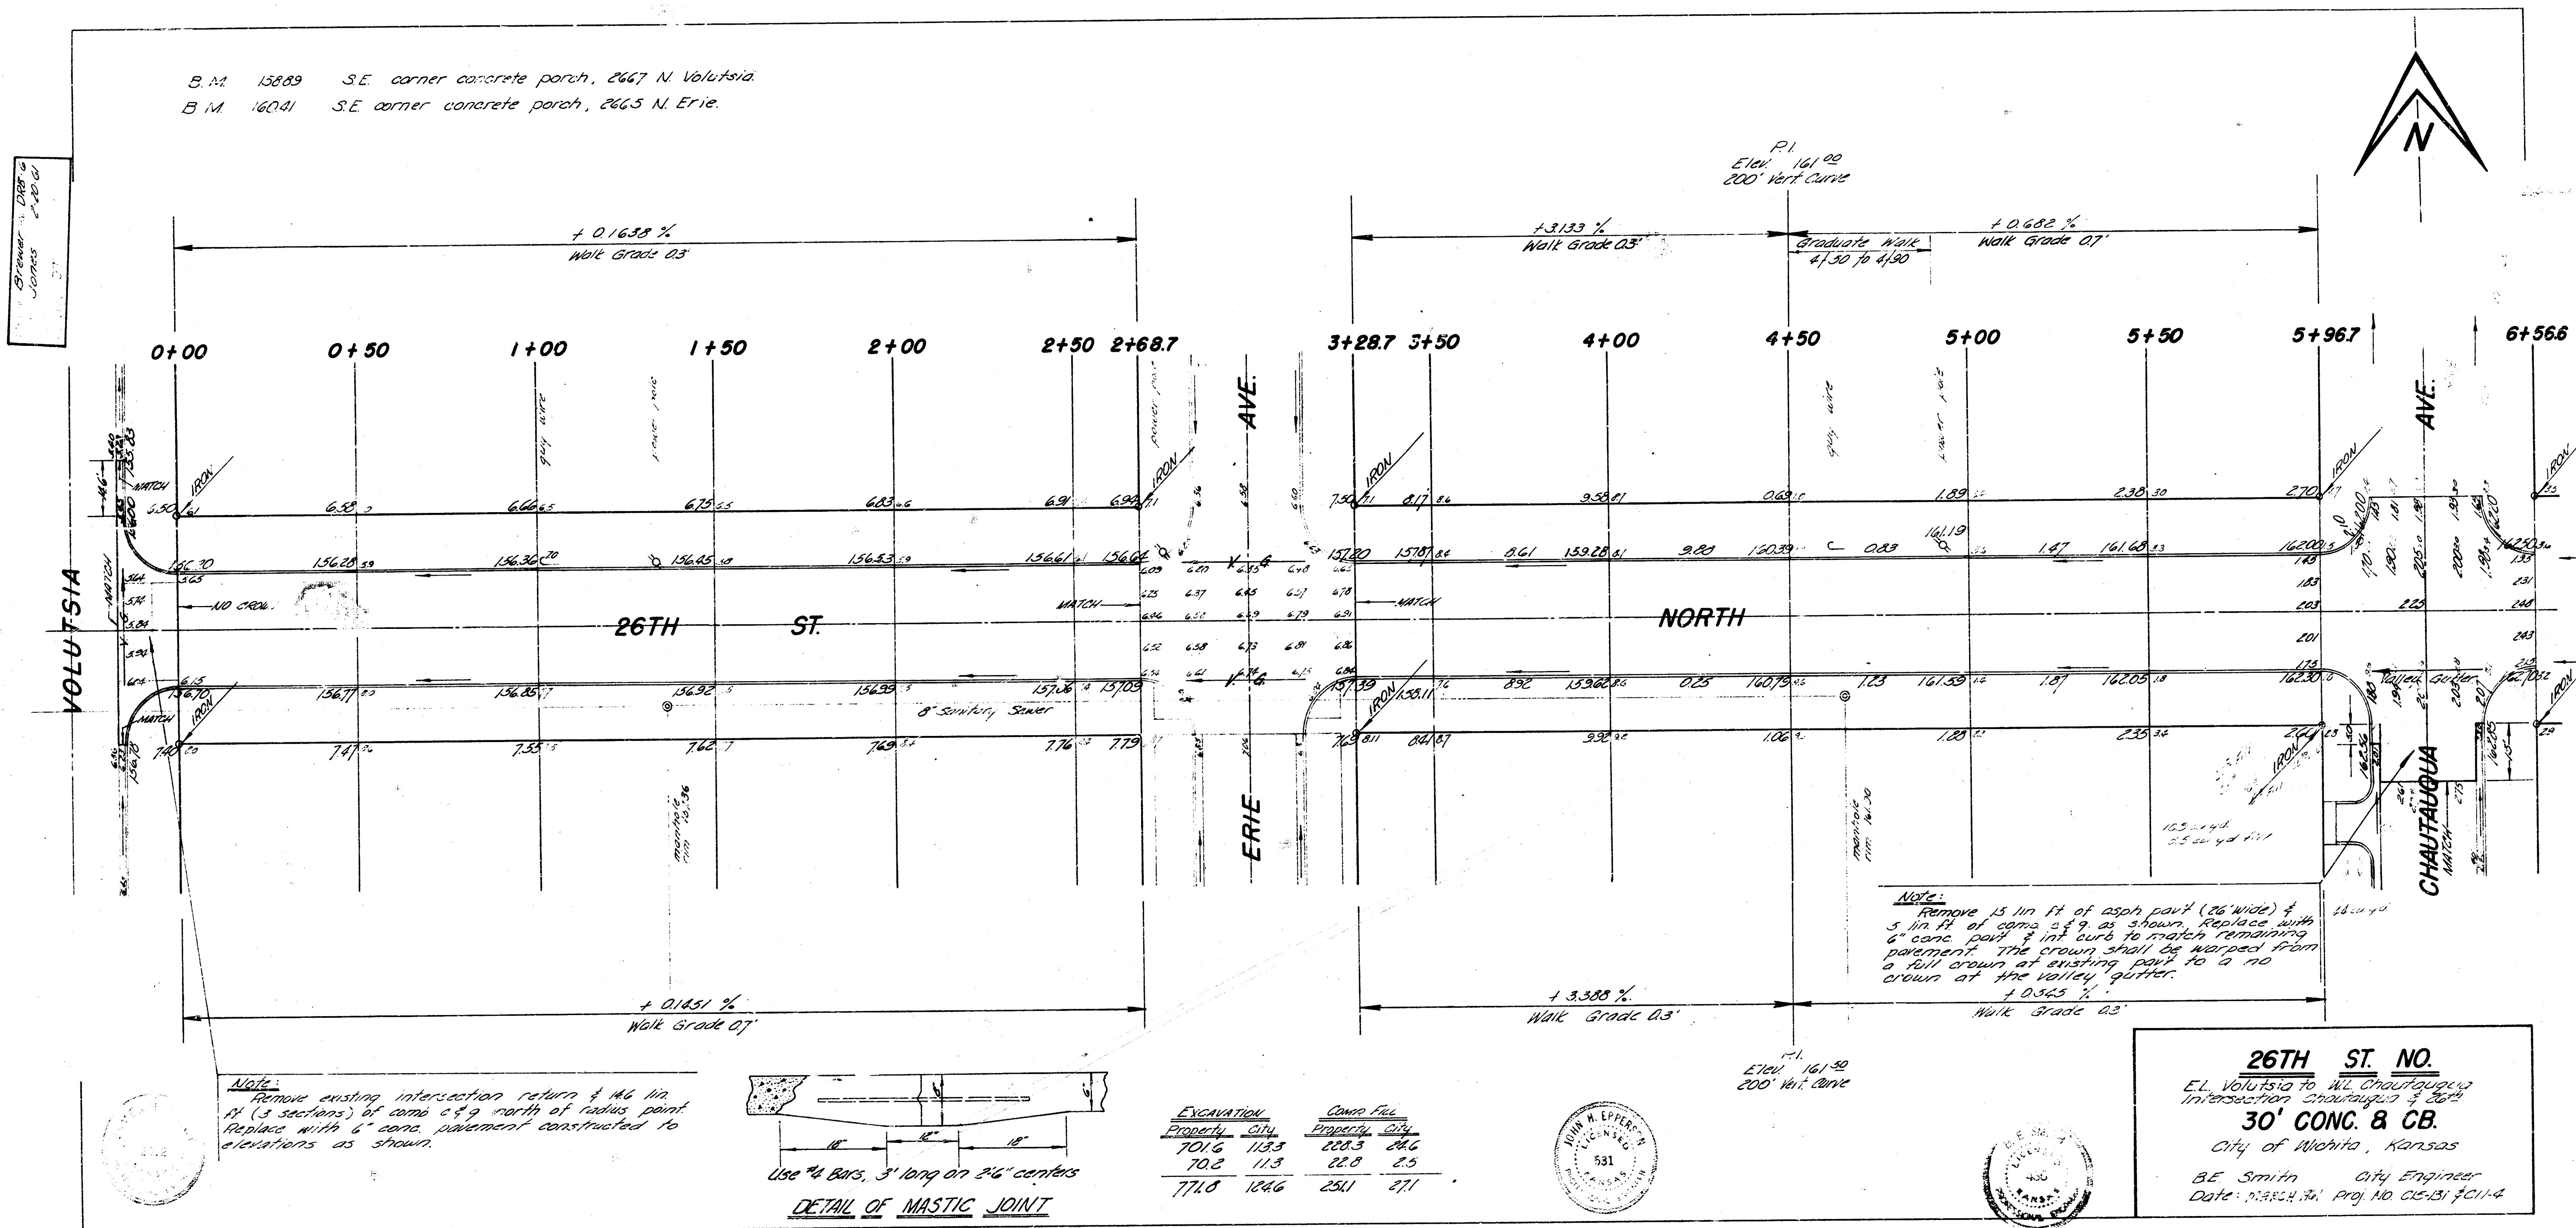

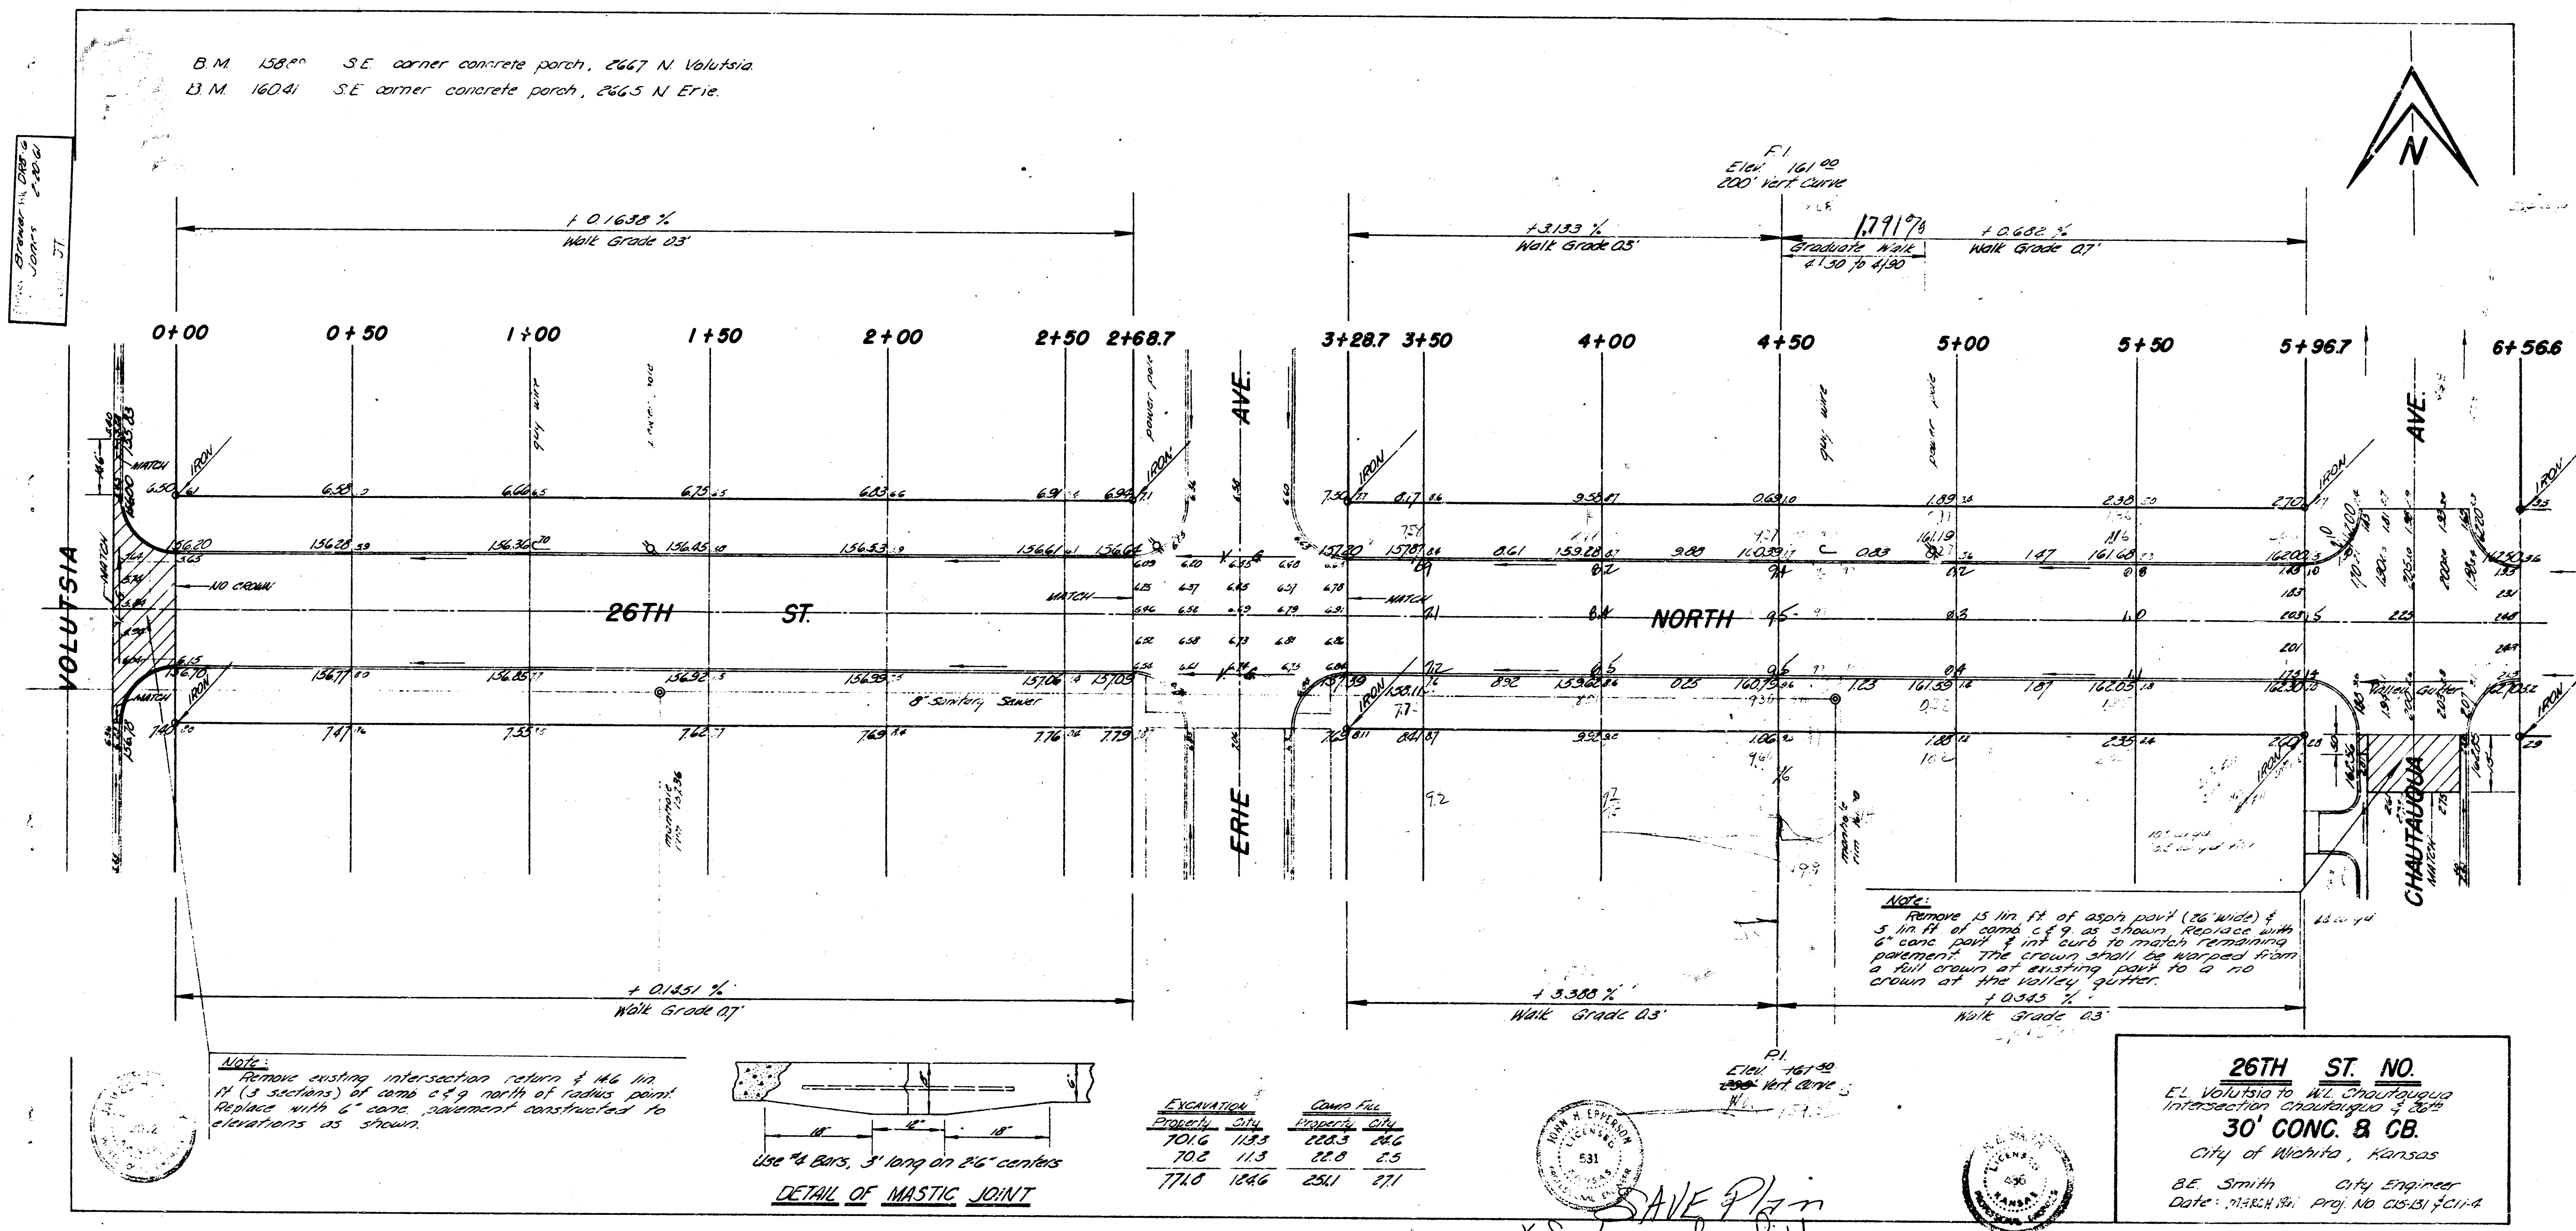

SAVE Plan
 X Section for Fill