


B.M. 98.04 Standard S.W. Cor. 27th & Glenn

Stationing on S. R.

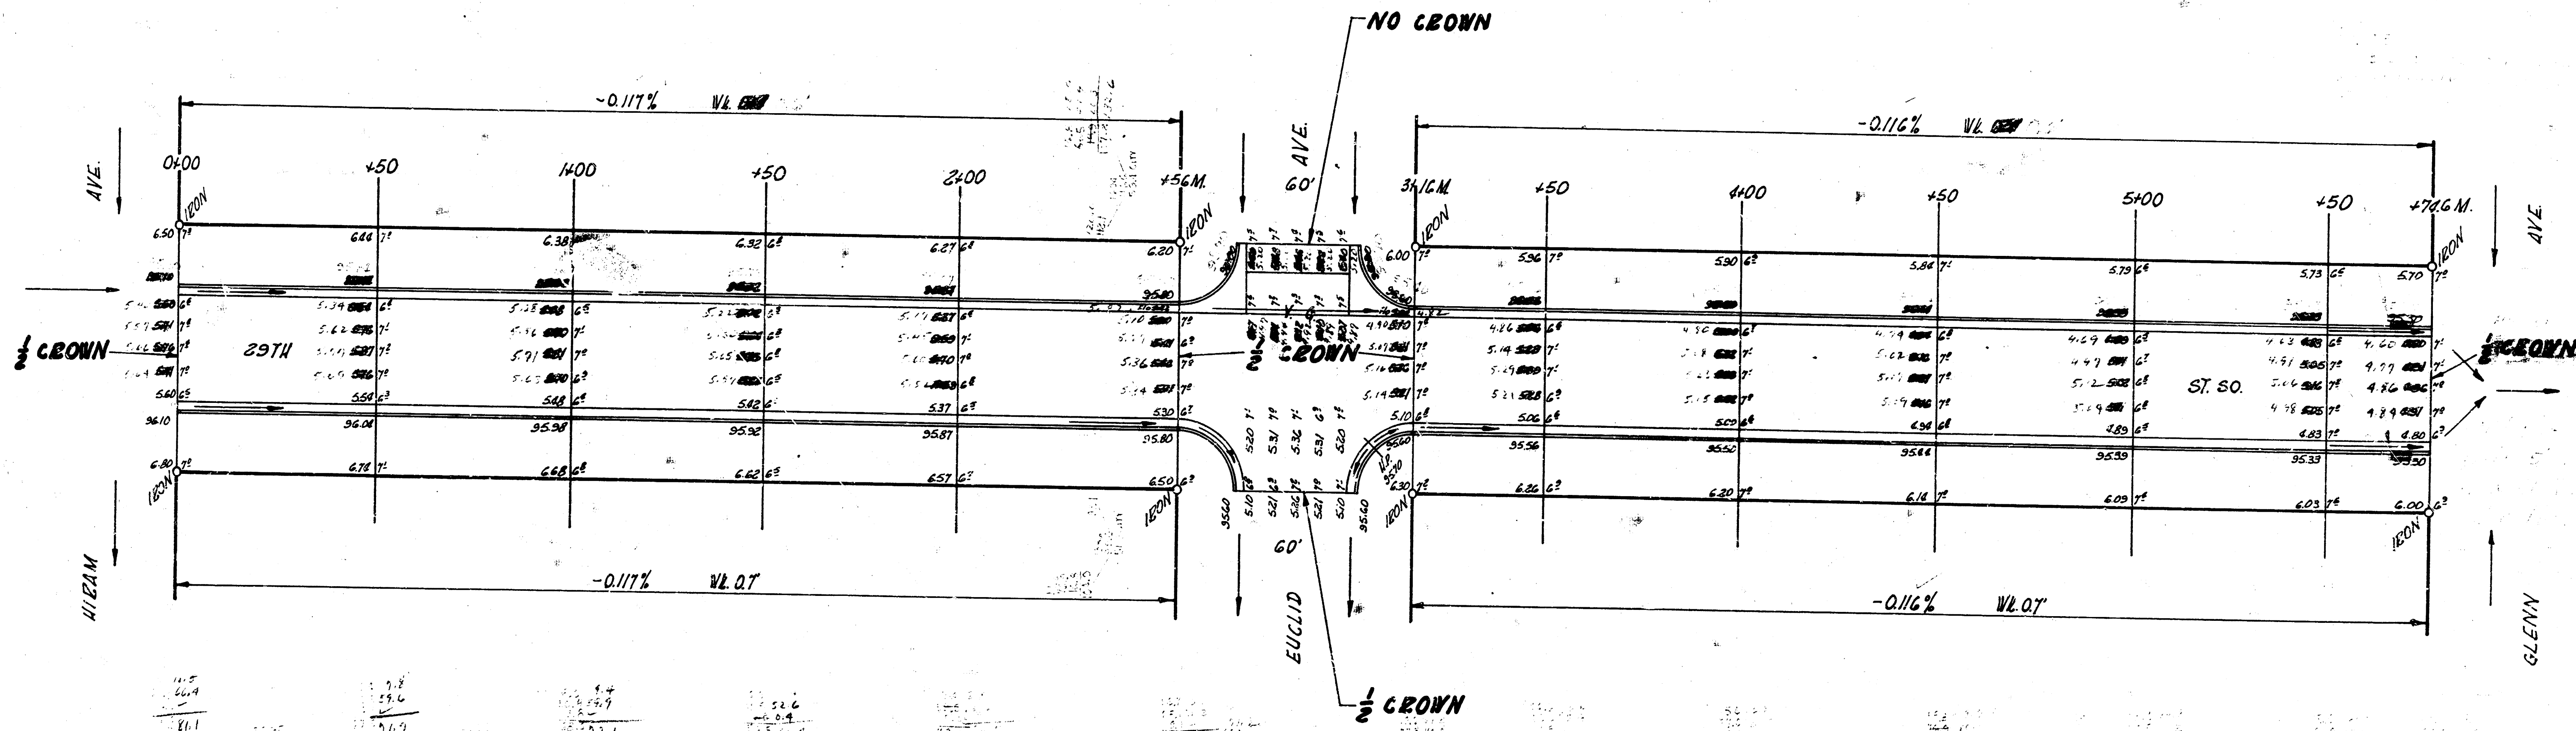

INVOY SEAL: JEZ JEZ Bk 525

29TH ST. SO
E.L. WIZAM - WL. GLENN
26'-2'-30" A.C.
CITY OF WICHITA, KANS.
B.E. SMITH CITY ENGINEER
JULY, 1954 PROJ. NO. 14,200

