


B.M. 98.10 "R" in Ritchie W. end Return NW cor. Mt. Carmel & 32nd St. So.
 Baseline & Sta. on N. R.

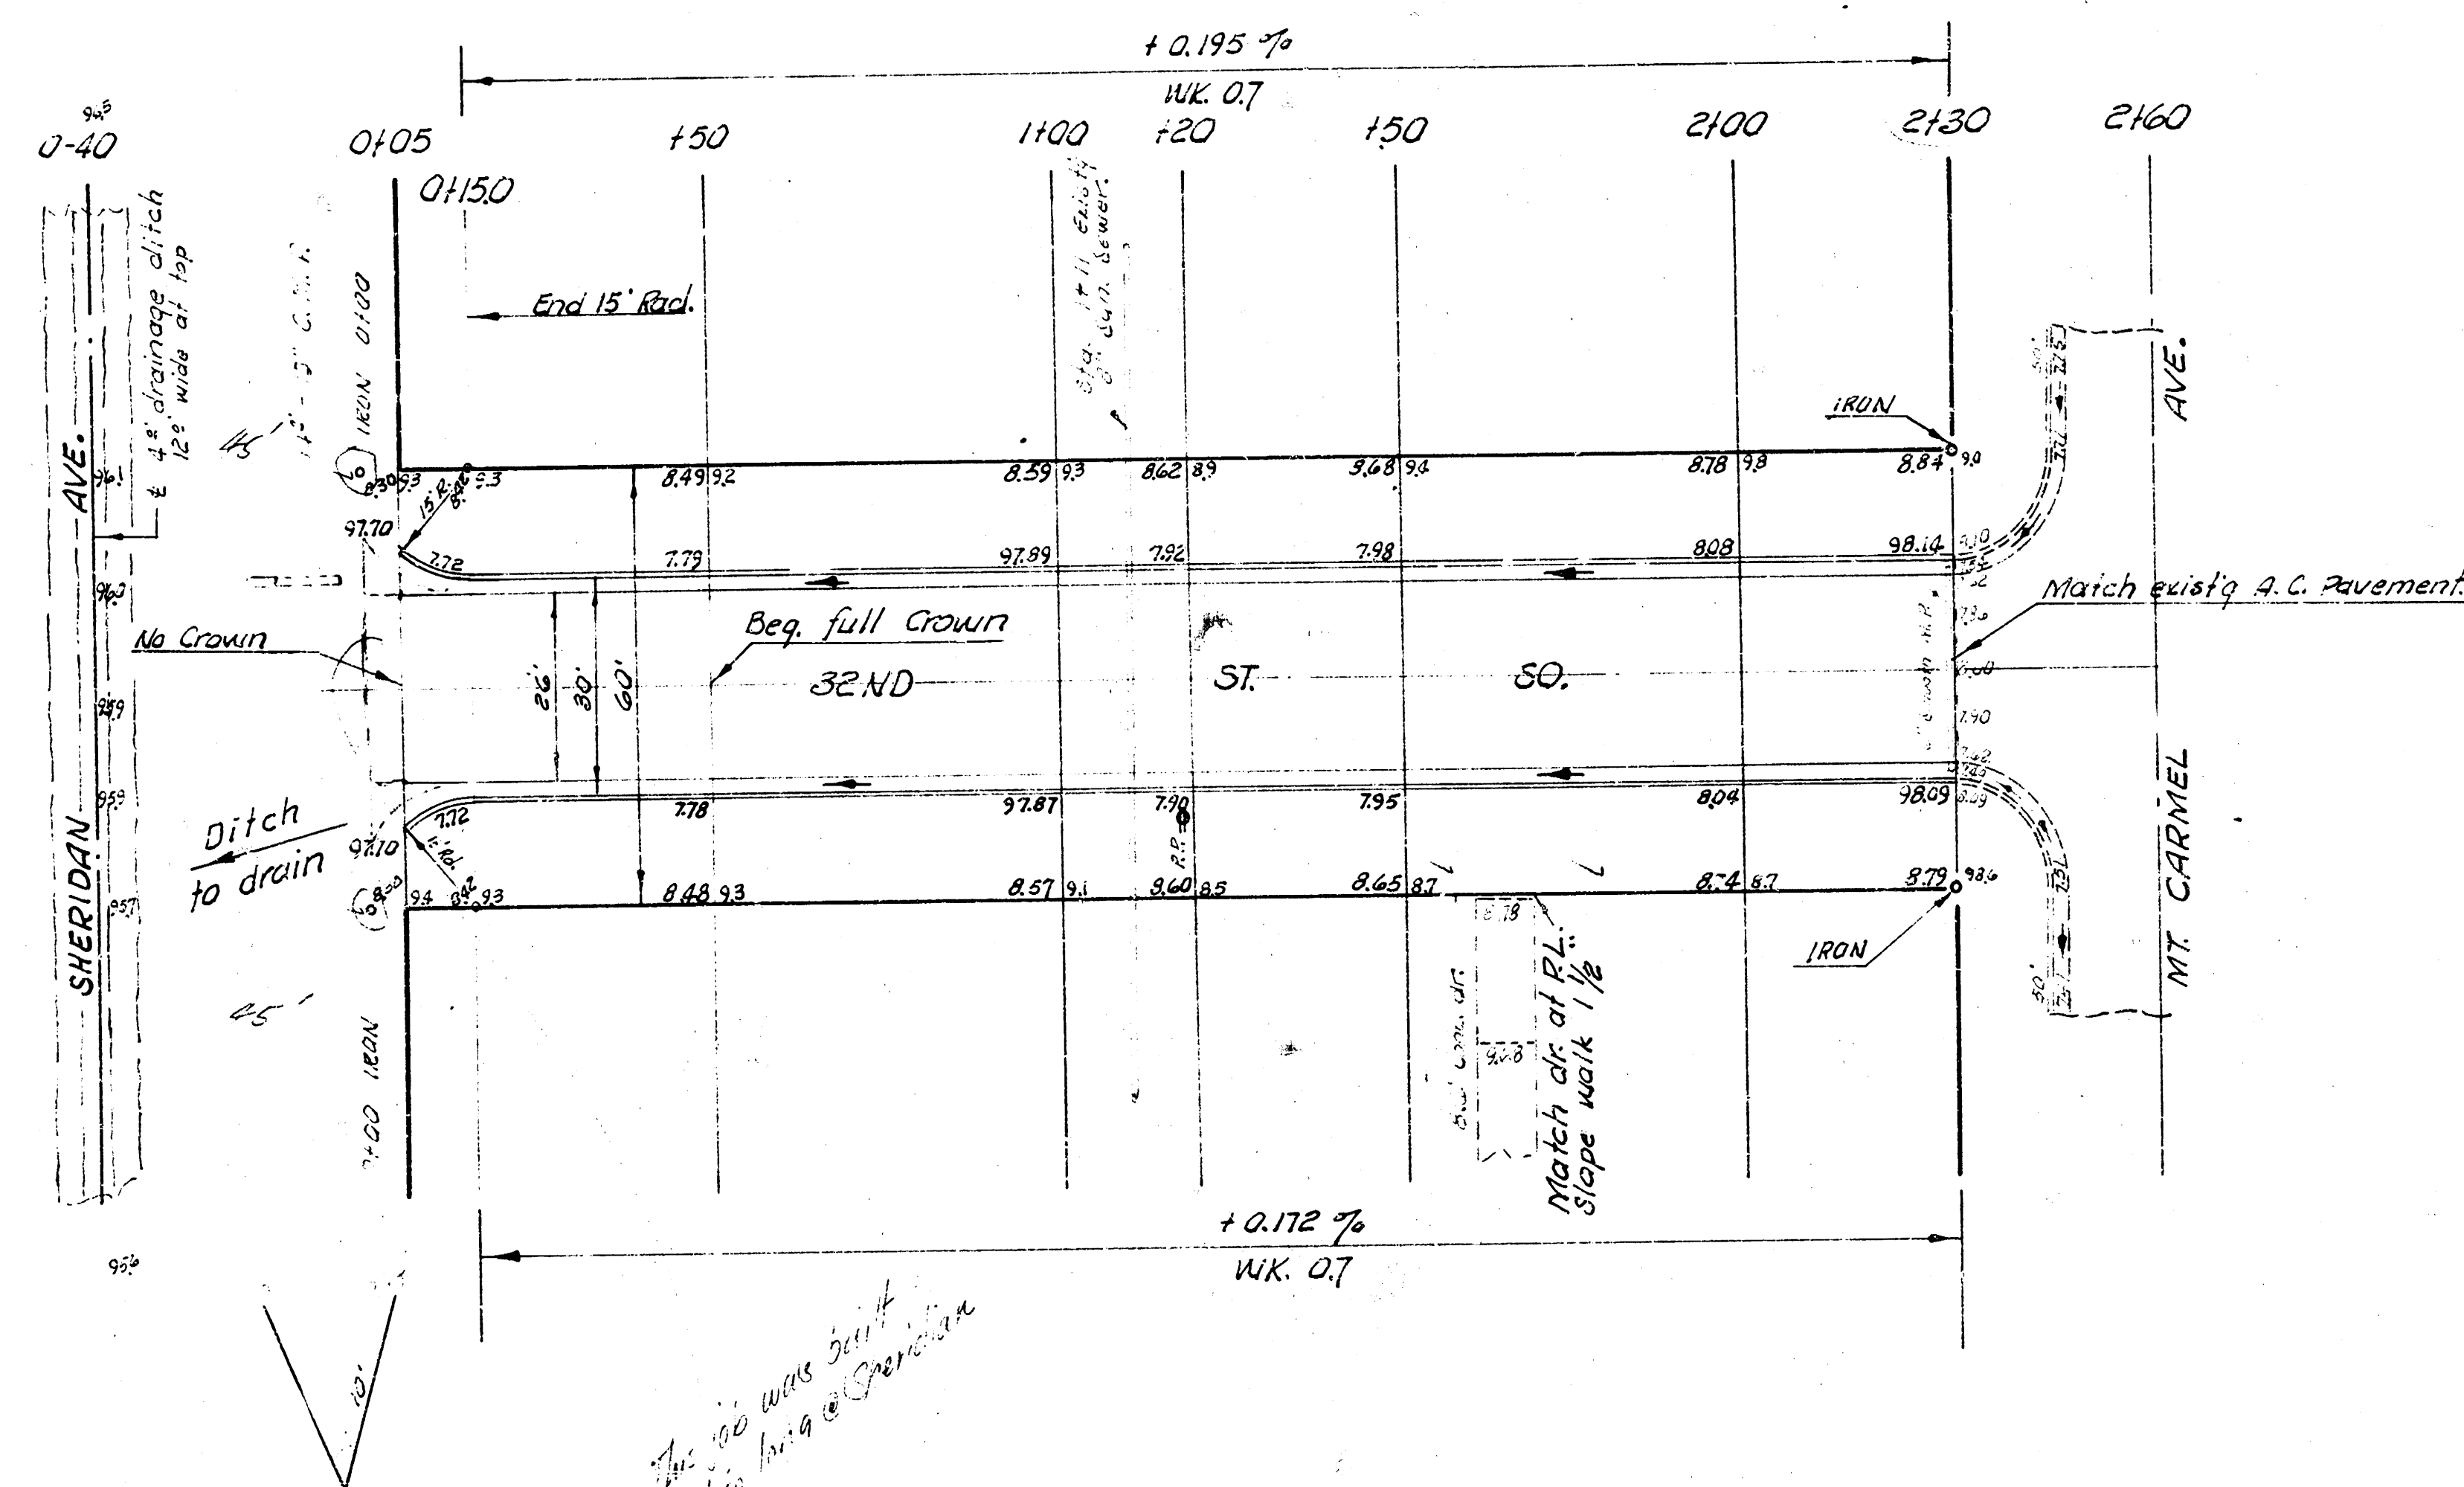

Earthwork
Excavation

Prop.	City
609.0	15.3
60.9	1.5
669.9 cu. yds.	16.8 cu. yds.

32ND. ST. SO.
 EL. SHERIDAN TO MOUNT CARMEL
 26'-2'-30" L.C.
 CITY OF WICHITA, KANSAS
 B. E. SMITH CITY ENGINEER
 SEPT. 1960, PROJ. C15-110

1/2