


Arboretum

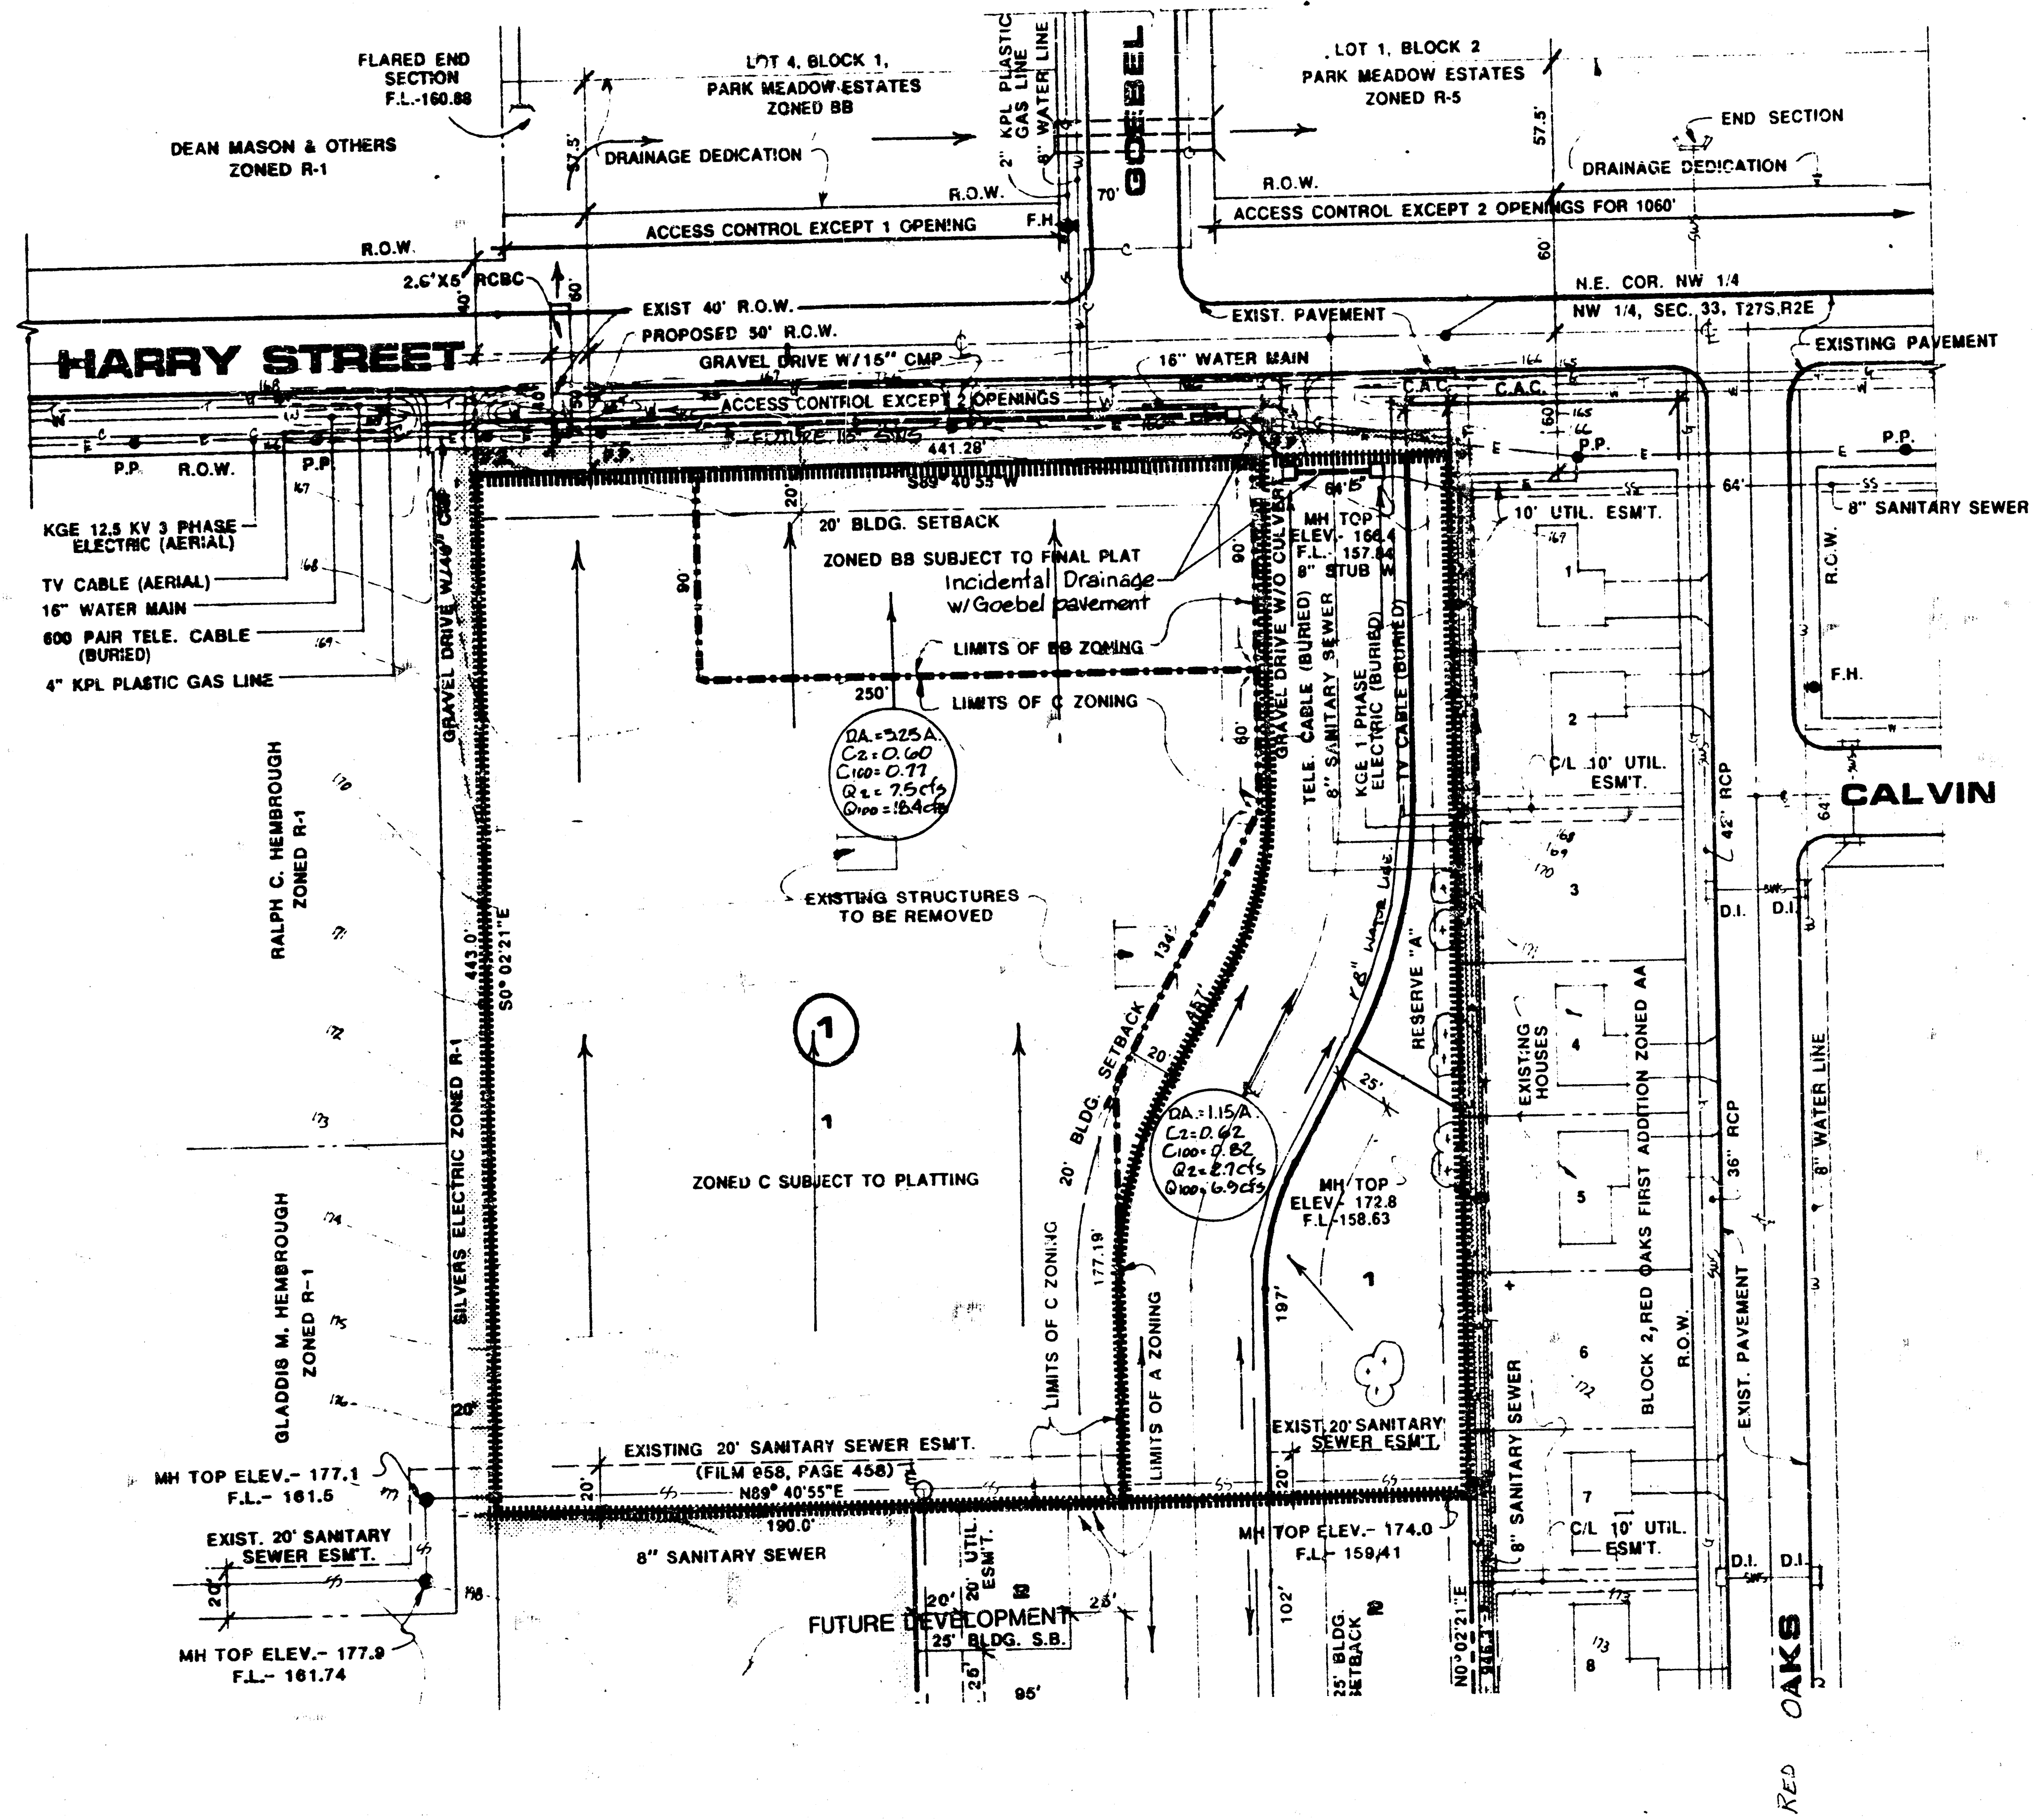

DRAINAGE PLAN THE ARBORETUM ADDITION

WICHITA, KANSAS

BAUGHMAN COMPANY P. A.
SURVEYING & ENGINEERING
316/262-7271 • 315 ELLIS • WICHITA, KANSAS 67211
DEC. 30, 1988