
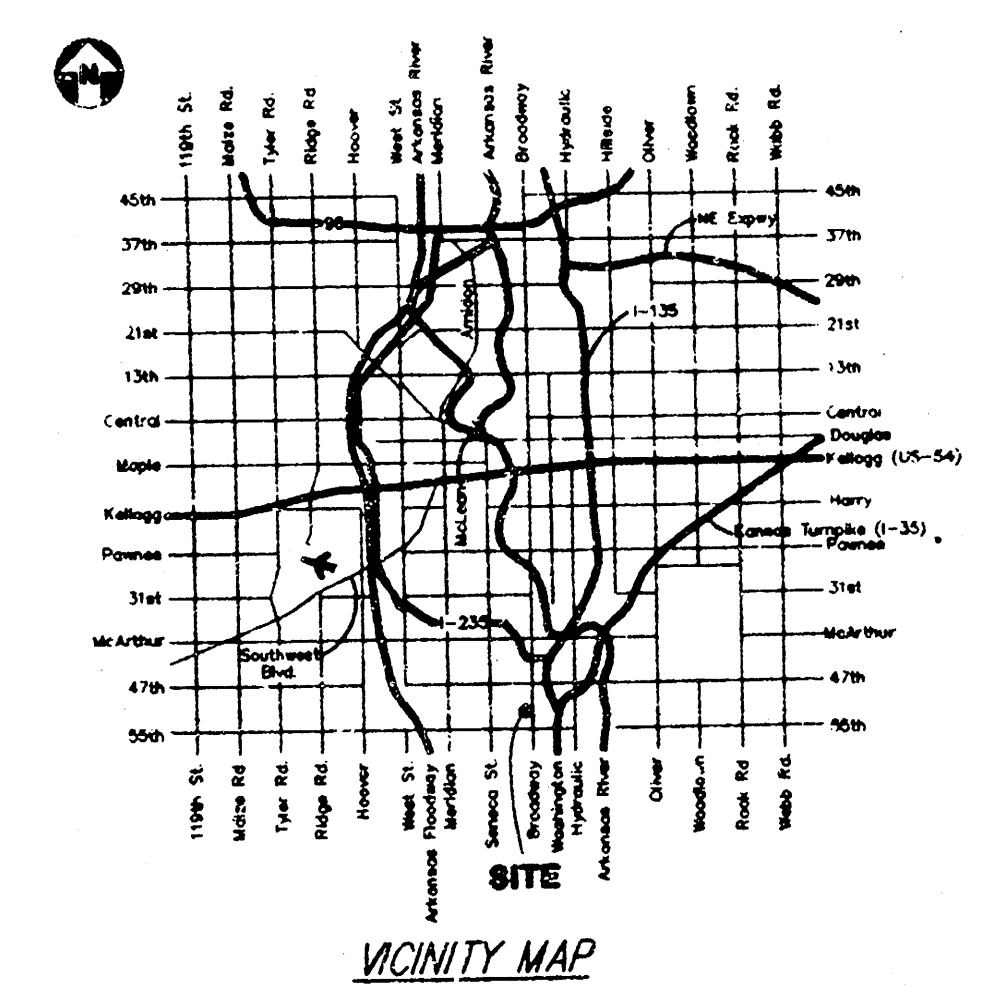
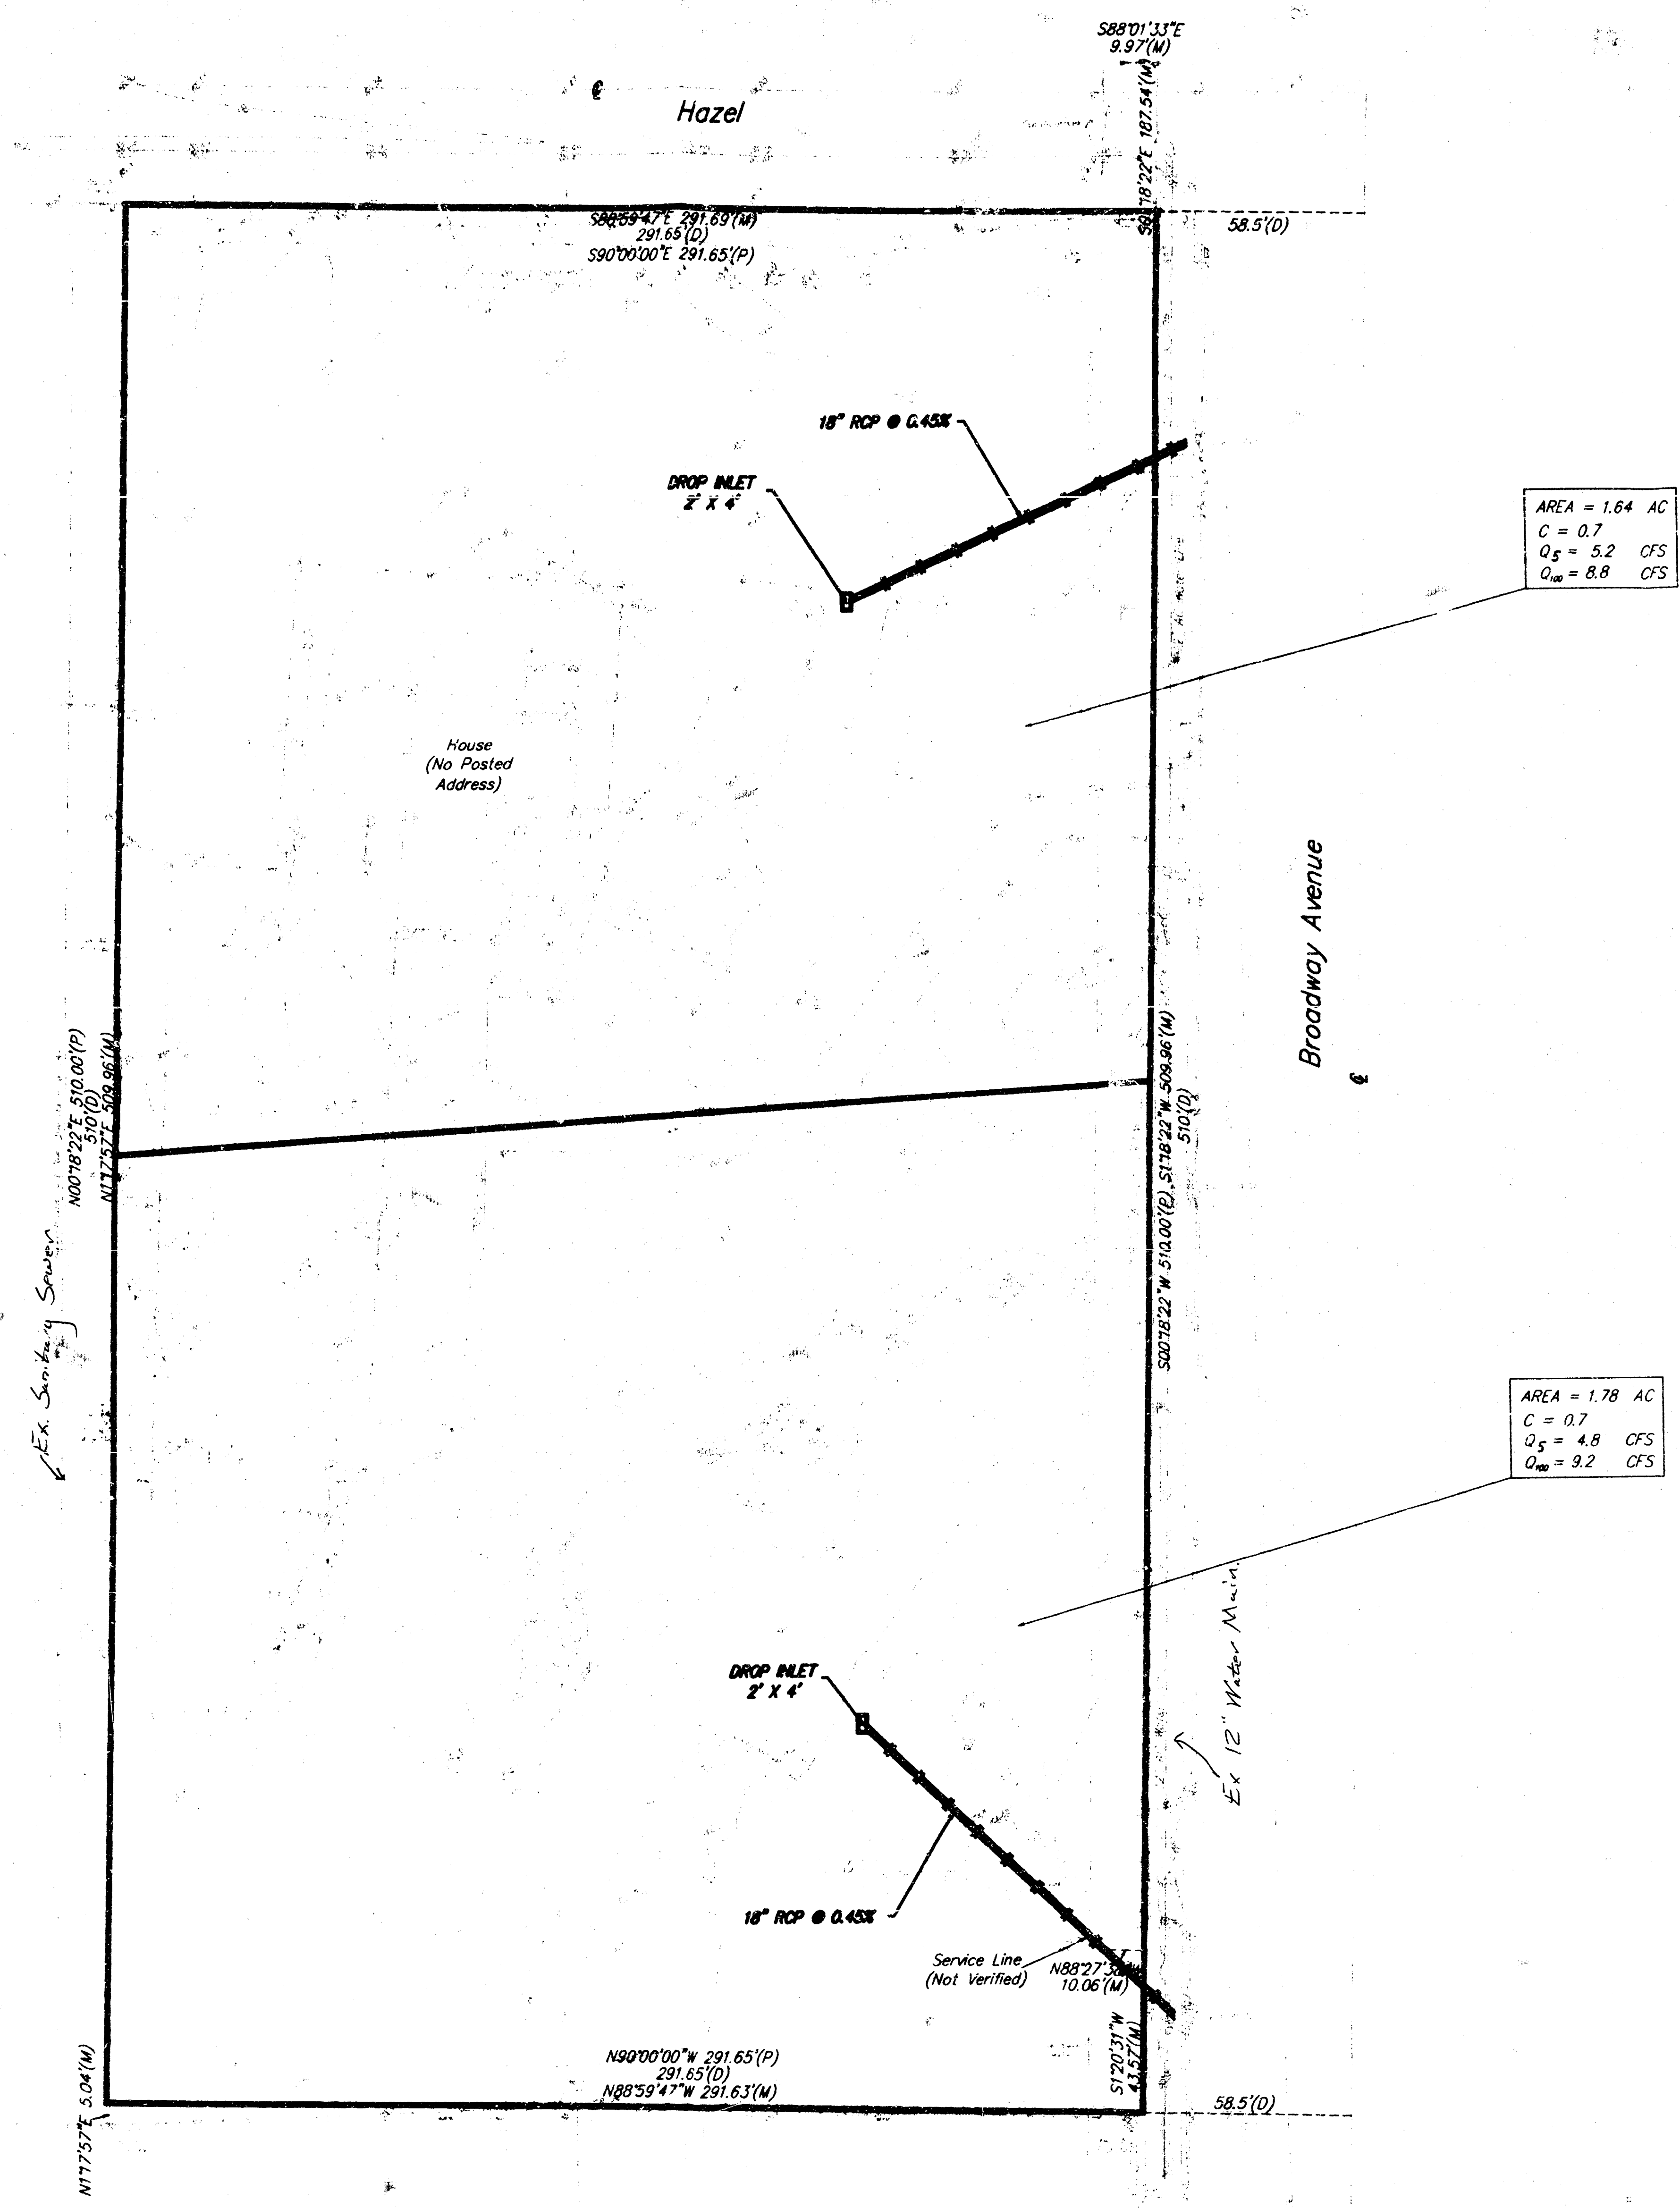


DRAINAGE PLAN **AUTOZONE ADDITION** **WICHITA, SEDGWICK COUNTY, KANSAS**

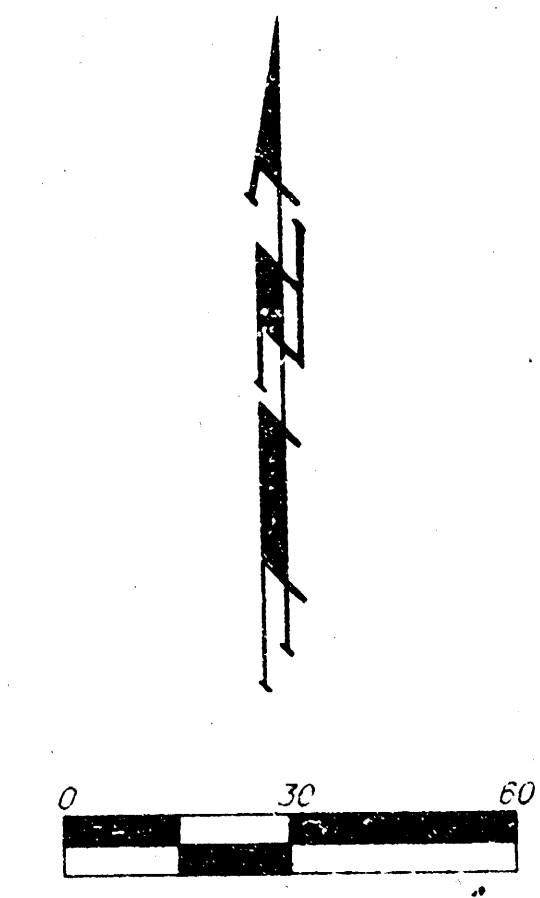

June 17, 1996