



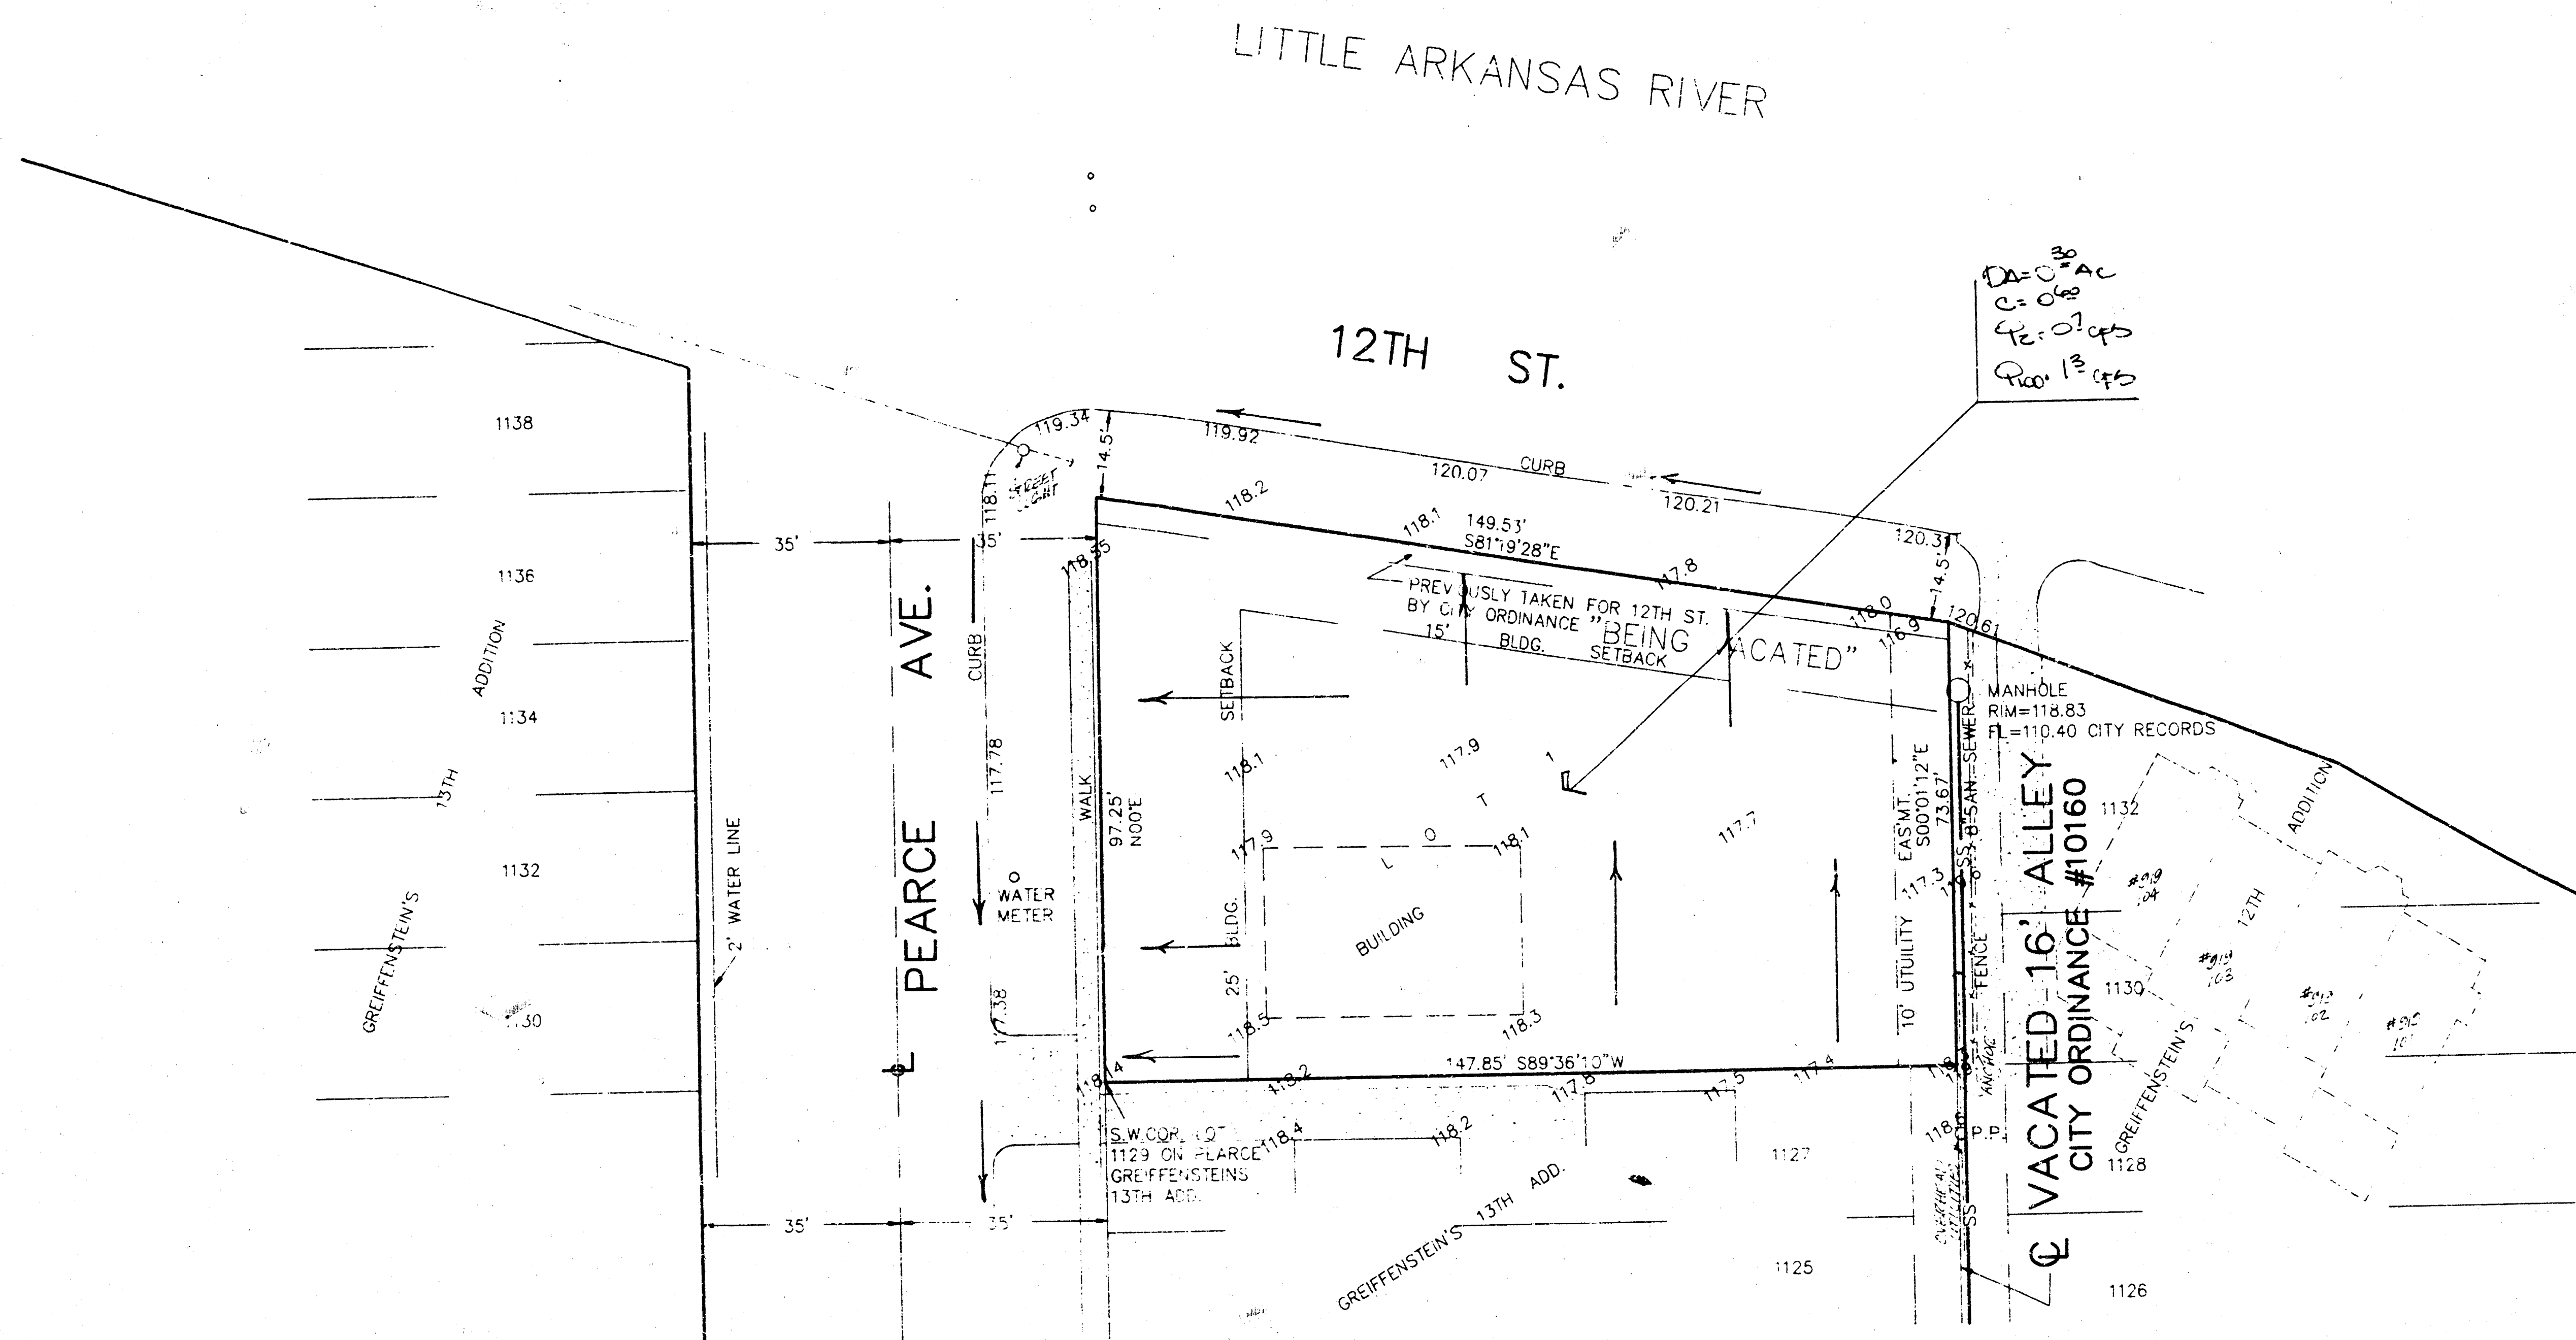

SKETCH PLAT BLT ADDITION

All of Lots 1128, 1131, 1133, and Lot 1135 except that part taken for 12th St. by City Ordinance, all on Pearce Ave. together with the W 1/2 of vacated Alley adjacent on the east, all in Greiffenstein's Thirteenth Addition to the City of Wichita, Sedgewick County, Kansas, and together with a portion of 12 St. as previously taken by City Ordinance, being originally a portion of said Lot 1135, all being more particularly described as beginning at the S.W. Cor. of said Lot 1128; thence 100° along the east line of Pearce Ave. 97.25 feet; thence S81°19'28"E 149.53 feet; thence S00°01'12"E 73.67 feet; thence S89°36'10"W 147.85 feet to the place of beginning. The above described portion of street and alley are hereby vacated by virtue of K.S.A. 12-512 (b).

OWNERS:
BLT PARTNERS
% EDWARD J. ROBERTS

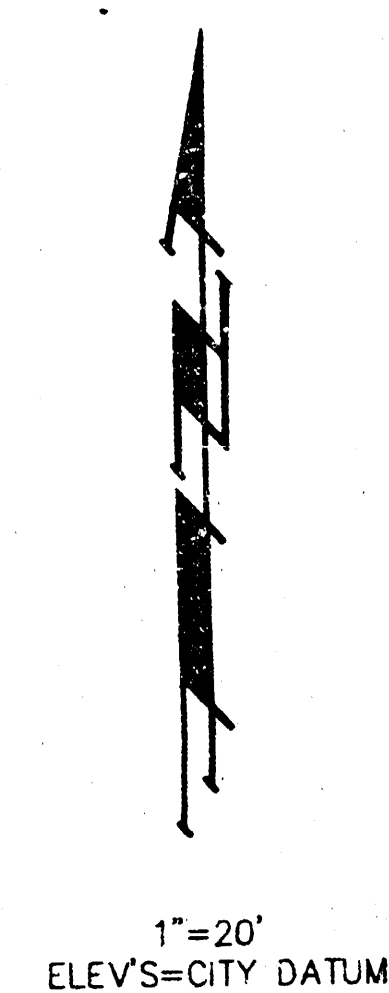

DRAINAGE PLAN



BAUGHMAN COMPANY P. L.
SURVEYING & ENGINEERING
318/262-7271 • 315 ELLIS • WICHITA, KANSAS 67201

MAY 17, 1991