


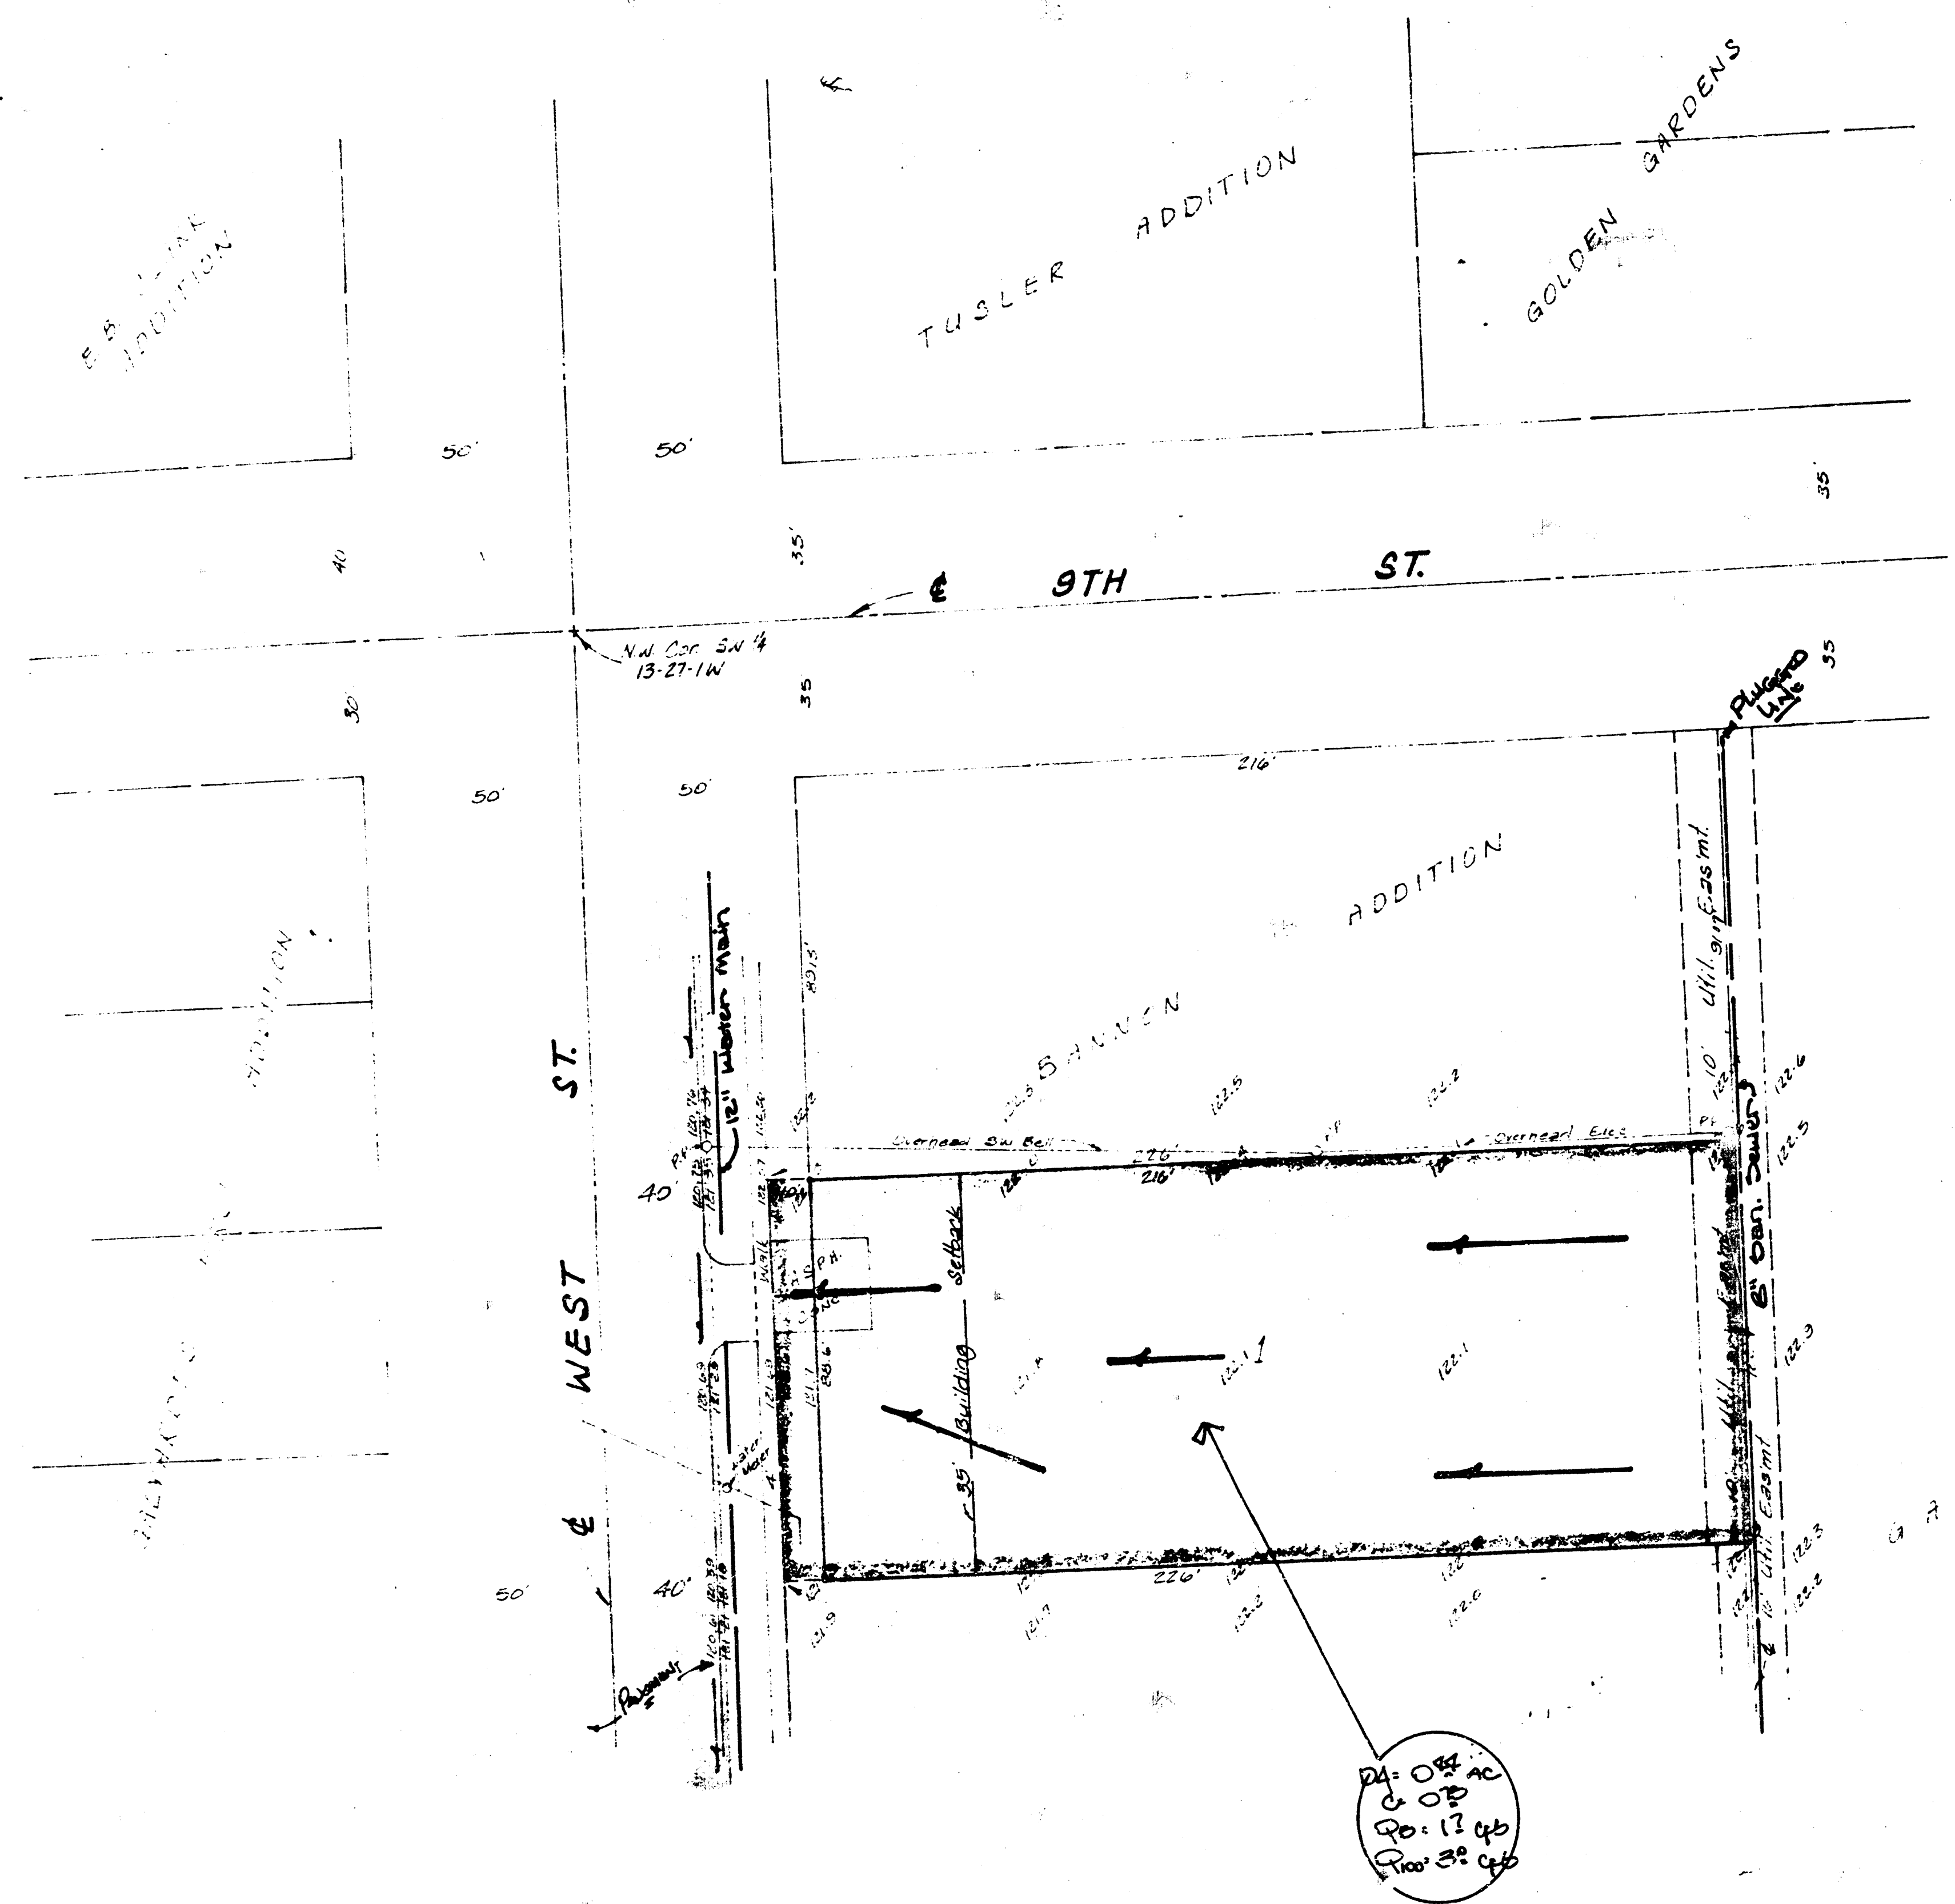

N
1"=30'
Elevation City datum
BENCH MARK: City Dico. S.W. Cor.
9th St & West St
Elevation 121.89

SKETCH PLAT
BANNON 2ND ADDITION

REPLAT OF LOT 2 NEWTON GARDENS SEDGWICK COUNTY, KANSAS

GENERAL NOTES:
THE COMMERCIAL LOT WHEN DEVELOPED SHALL
DRAIN WEST TO WEST ST. AND DISCHARGE TO
THE STREET THRU THE DRIVEWAY. WEST ST. DRAINS
SOUTH AND INTO AN INLET & DRAIN S.W. APPROX.
100' S. OF THIS PROPERTY.

OWNER: JEFF BANNON

DRAINAGE PLAN

BAUGHMAN COMPANY, P.A.
SURVEYING & ENGINEERING
316/263-7271 • 330 LAURA • WICHITA, KANSAS 67211

14 NOVEMBER 1985

FILMED FROM THE BEST
AVAILABLE COPY.....