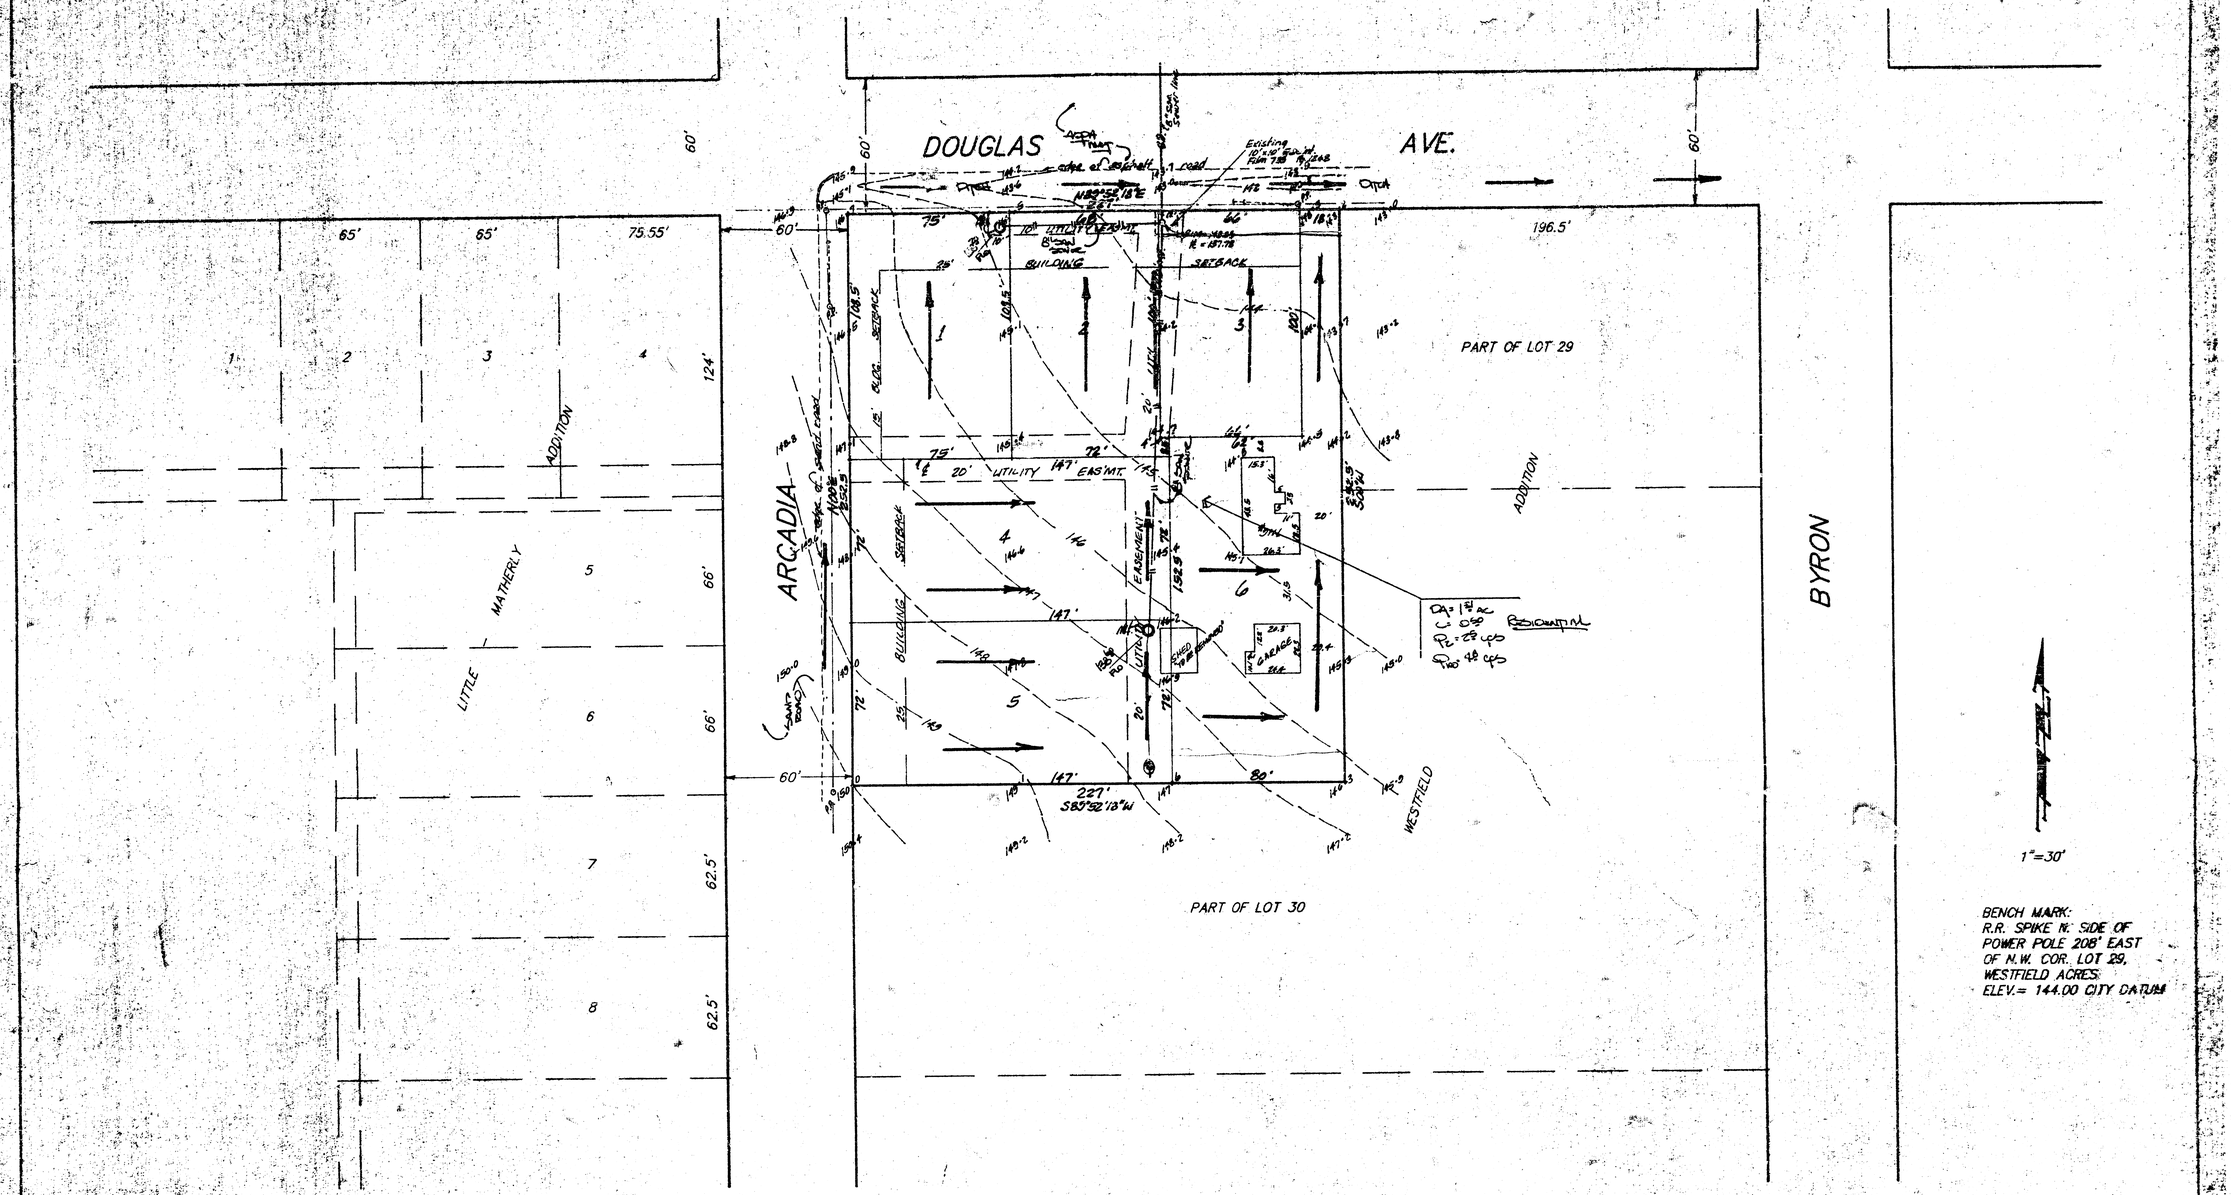


BENCH MARK:
R.R. SPIKE N. SIDE OF POWER POLE 208' EAST OF N.W. COR. LOT 29, WESTFIELD ACRES
ELEV.= 144.00 CITY DATUM

SKETCH PLAT
BERLIN ADDITION

A REPLAT OF THE WEST 227 FEET OF LOT 29, AND THE WEST 227 FEET OF THE N.1/2 OF LOT 30, WESTFIELD ACRES, SEDGWICK COUNTY, KANSAS

OWNER: JESSE BERLIN

DRAINAGE & UTILITY PLAN

BAUGHMAN COMPANY P. A.
SURVEYING & ENGINEERING

FILMED FROM THE BEST AVAILABLE COPY