

Blasi Add'n

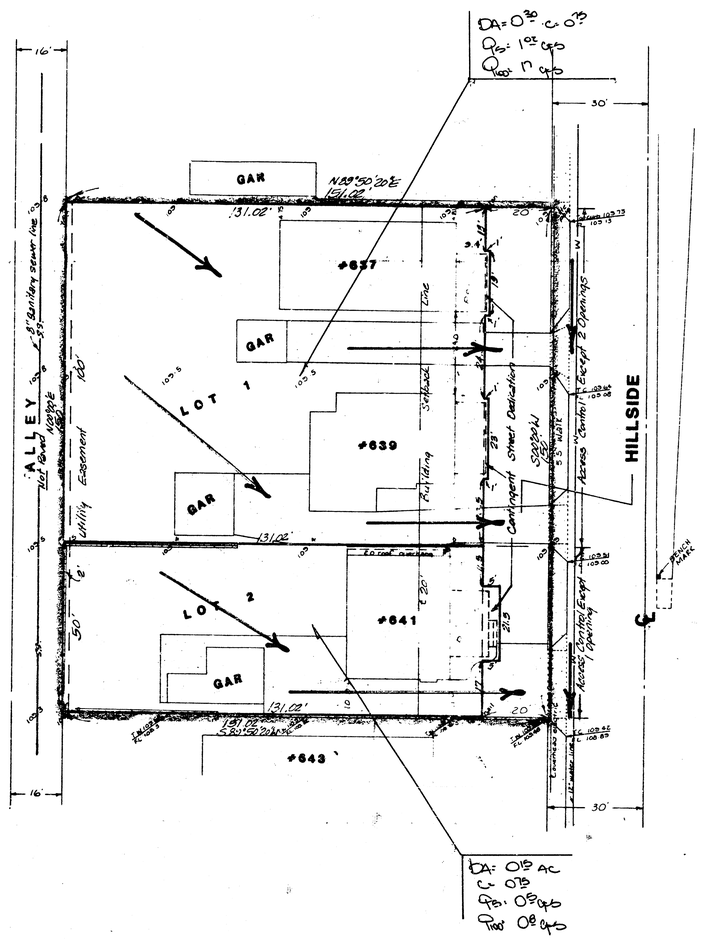

N

1" = 20'

Bench Mark:
"D" cut on top of west curb on South end of island on Hillside 431 feet south of ℄ of Orme. Elev = 110.02 City Datum

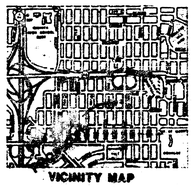

VICINITY MAP

SKETCH PLAT

BLASI ADDITION

LOTS 73, 75, 77, 79, 81, AND 83, BLOCK 8, SUNNY-SIDE ADDITION TO THE CITY OF WICHITA, KANSAS.

OWNERS:
B. LINUS AND ADAURE C. OHAEBOSIM
ORIE, JIM, AND BILL OWENS
DONALD T. AND EILEEN M. BLASI

drainage plan —

FILMED FROM THE BEST AVAILABLE COPY