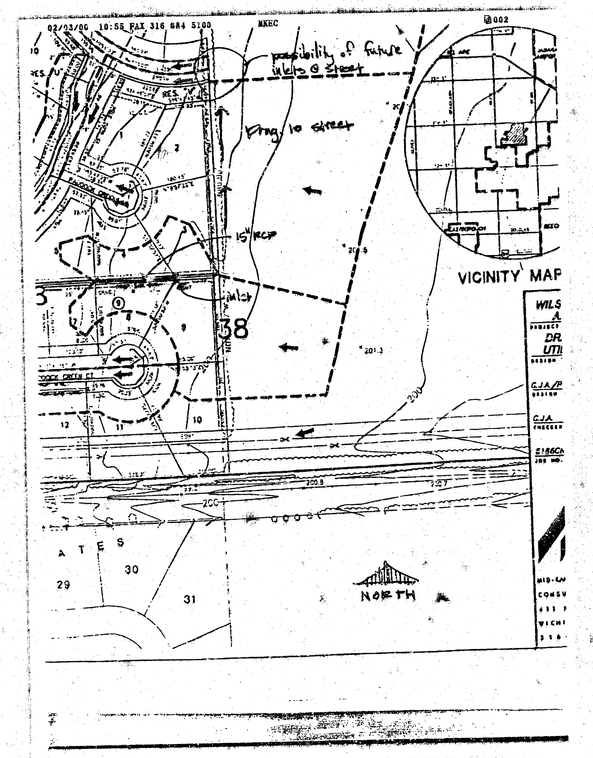
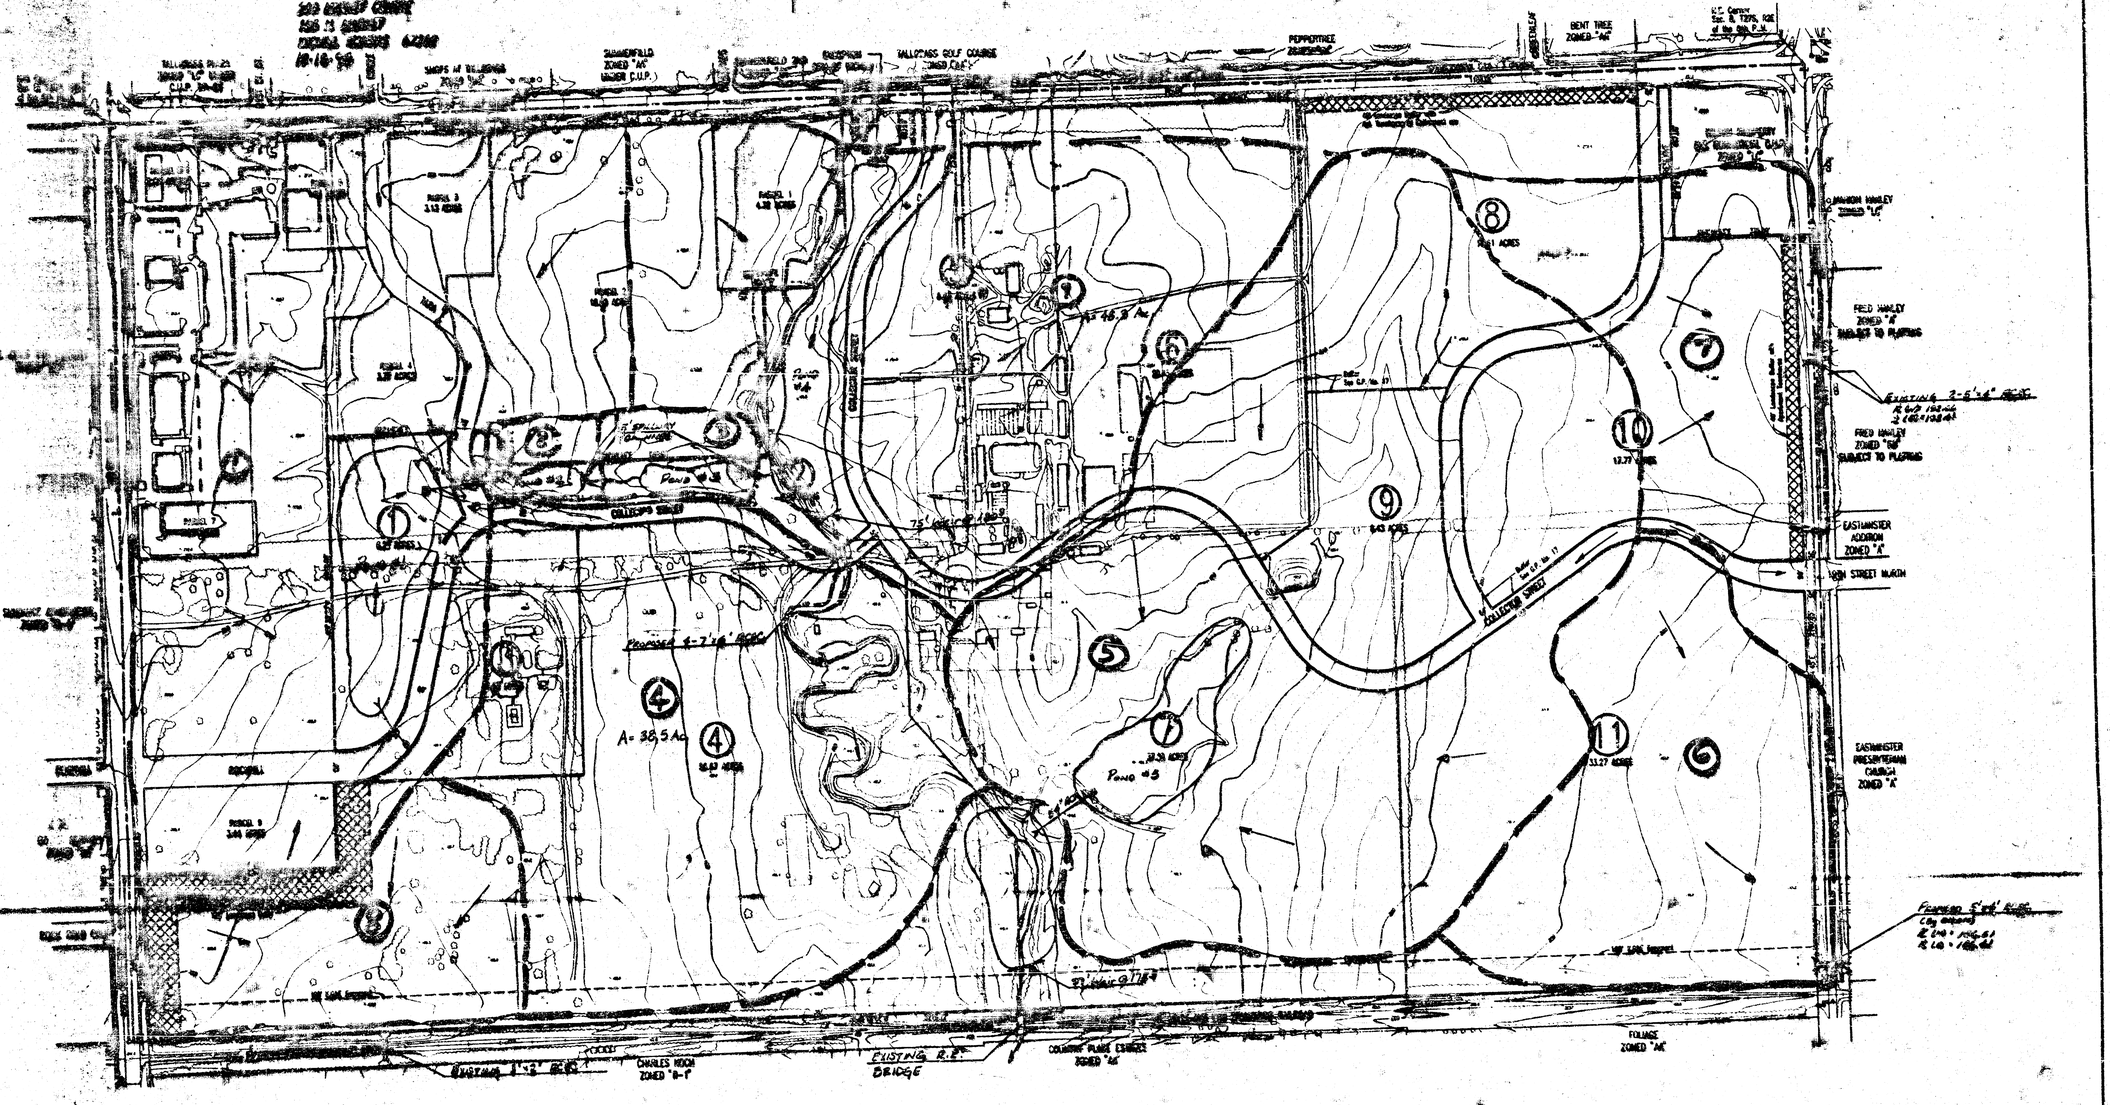

02/03/00 10:58 FAX 316 684 5100
MKEC
002
possibility of future
King to street
15" RCP
VICINITY MAP
38
3
12
11
10
29
30
31
NORTH

GRADING PLAN BRADLEY FAIR 2ND ADD.

WILSON ESTATES RESIDENTIAL

OWNER WILSON ESTATES
203 HARLEY CENTRE
555 N. BRADLEY
WICHITA, KANSAS 67208
10-16-96



Pond #	Static Pool Elev.	High Water Elevation	Area @ Static (Ac.)	Area @ High Water (Ac.)	$Q_{100\text{-in}}$	$Q_{100\text{-out}}$	DWS-100
1	[illegible]	201.0	2.75	3.50	345	185	[illegible]
2	[illegible]	197.0	0.60	0.83	192	197	[illegible]
3	194.0	198.0	0.30	0.80	197	189	197.94
4	180.0	184.0	0	0	1243	1243	183.50
5	181.5	186.0	2.75	3.50	434	223	184.78
6	176.5	180.0	0	0	1243	1243	178.00

2673