


Bratcher 2nd add'n

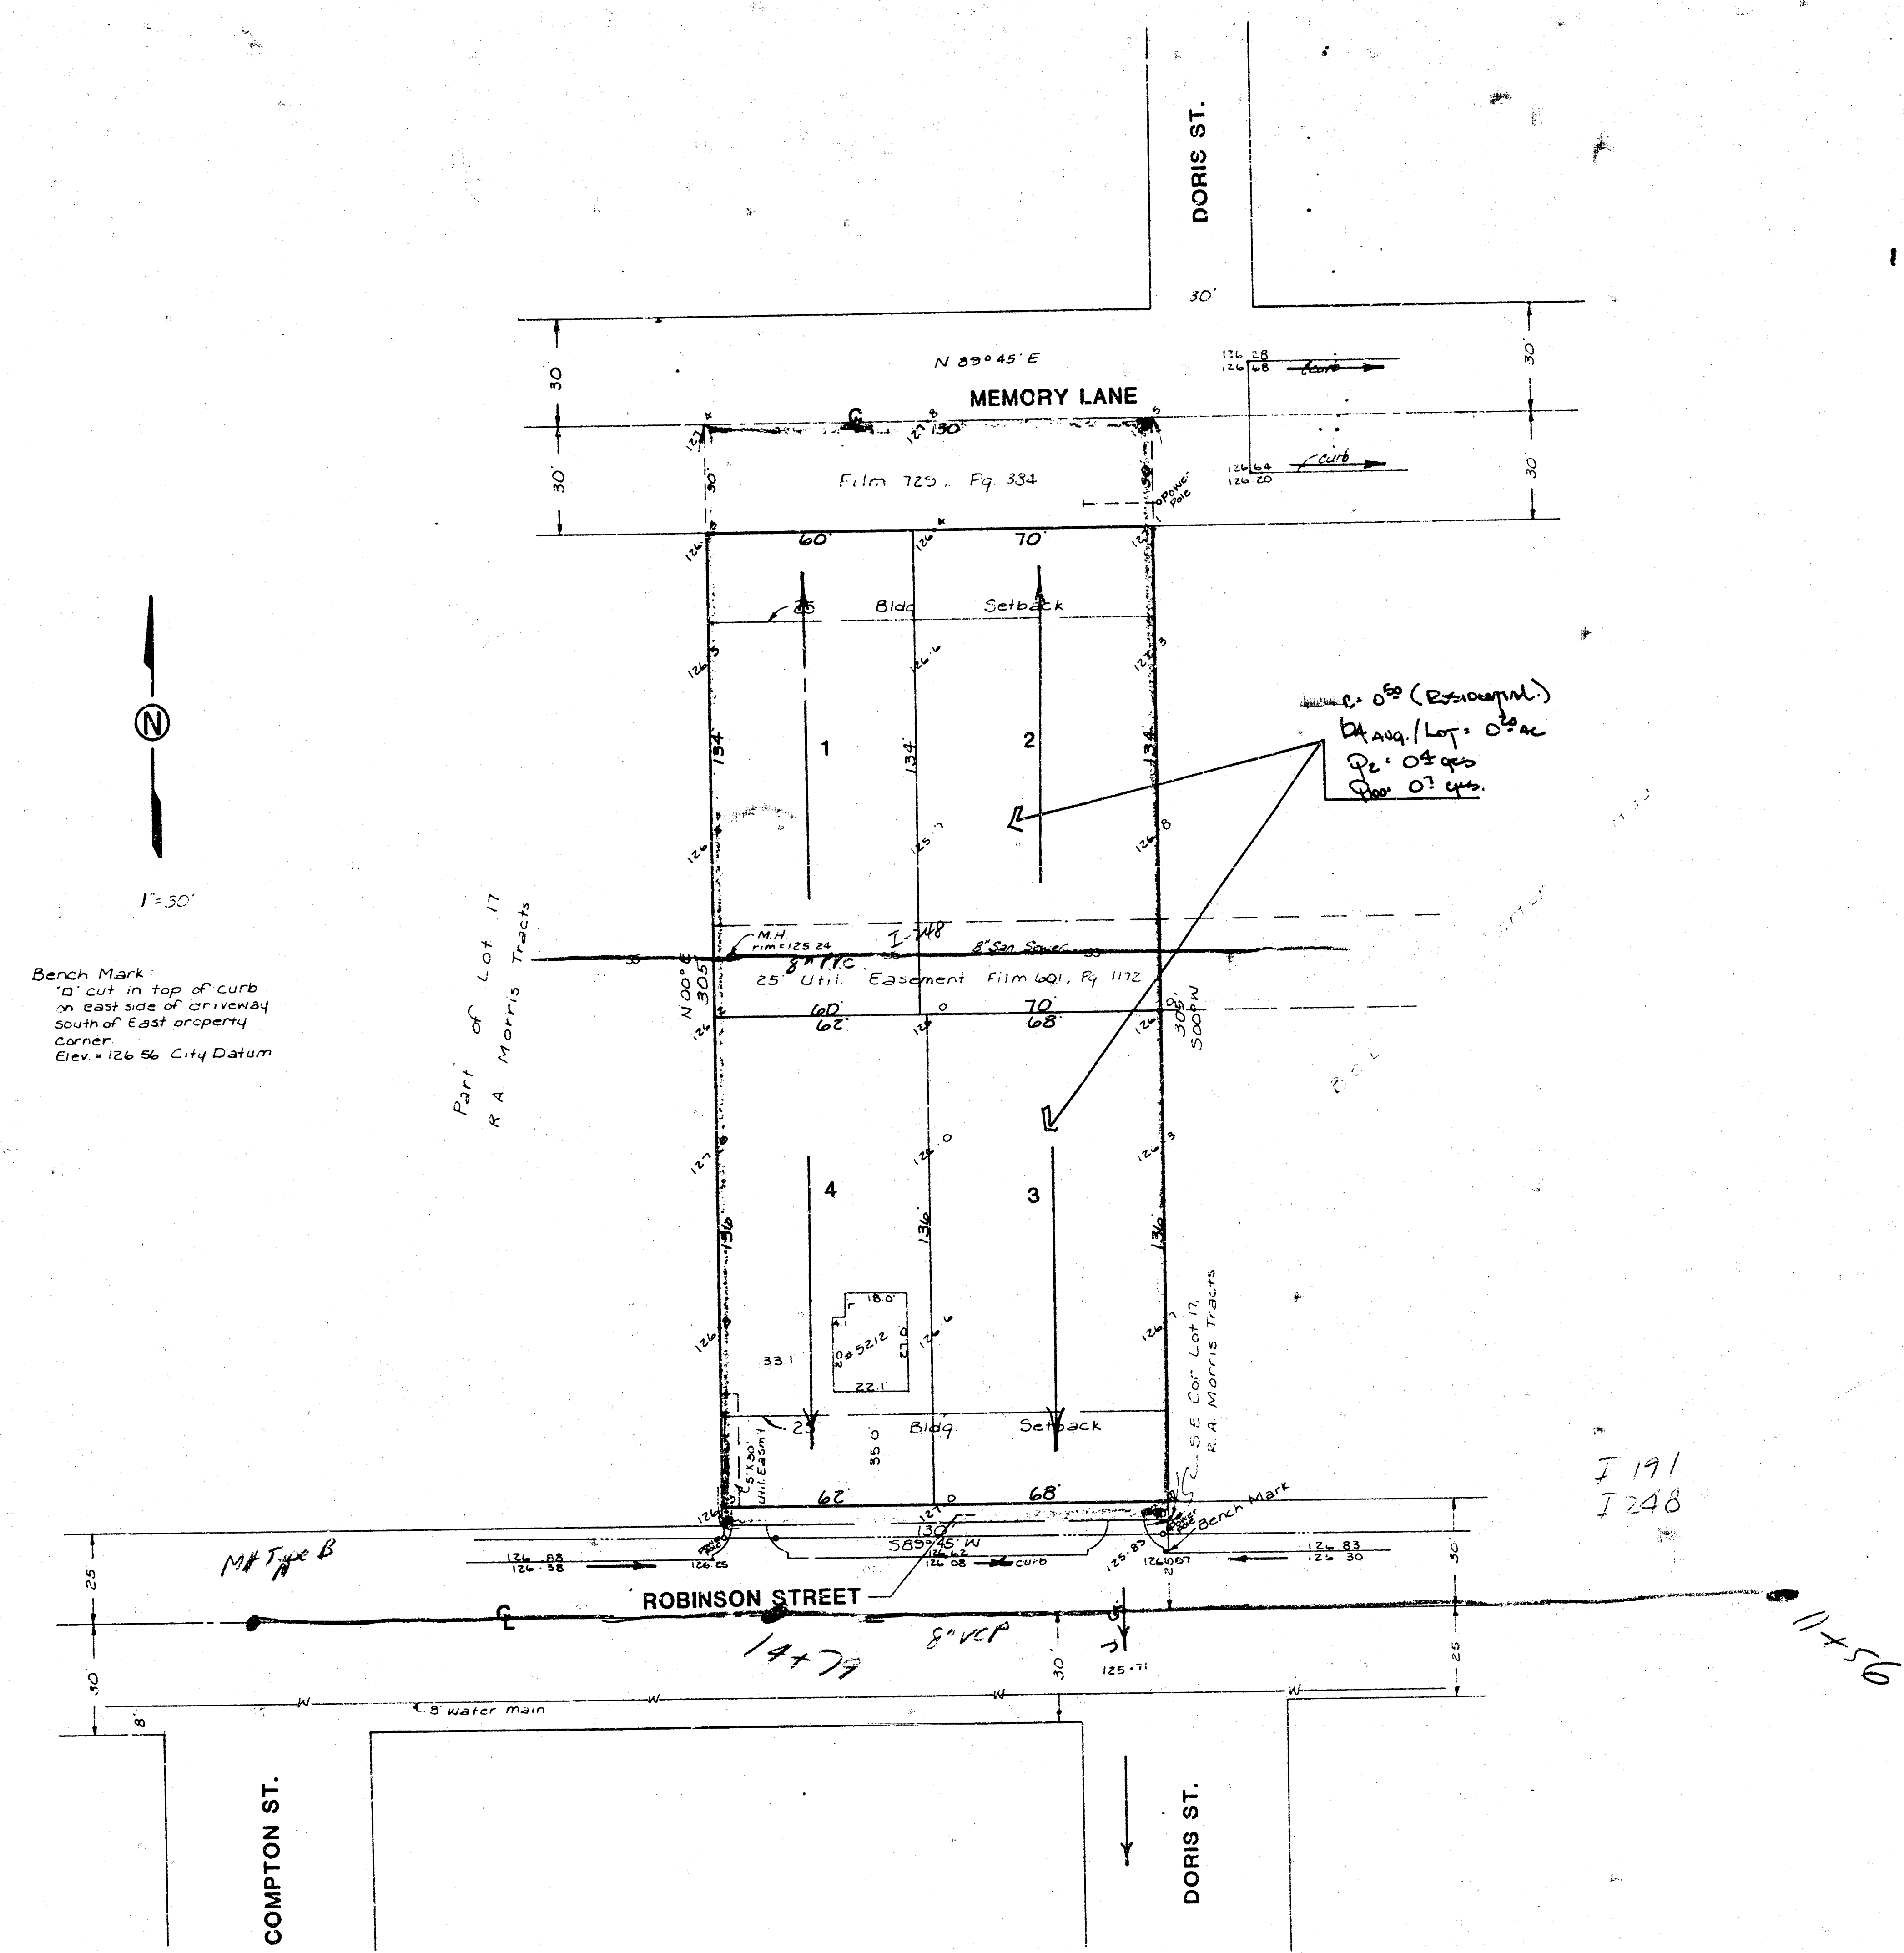

SKETCH PLAT
BRATCHER 2ND ADDITION

LOT 17, EXCEPT THE WEST 510 FEET THEREOF, R. A. MORRIS TRACTS,
SEDGWICK COUNTY, KANSAS

OWNER: **MICHAEL D. BRATCHER**

DRAINAGE PLAN
BAUGHMAN COMPANY, P.A.
SURVEYING & ENGINEERING
316/262-7271 • 315 ELLIS • WICHITA, KANSAS 67211