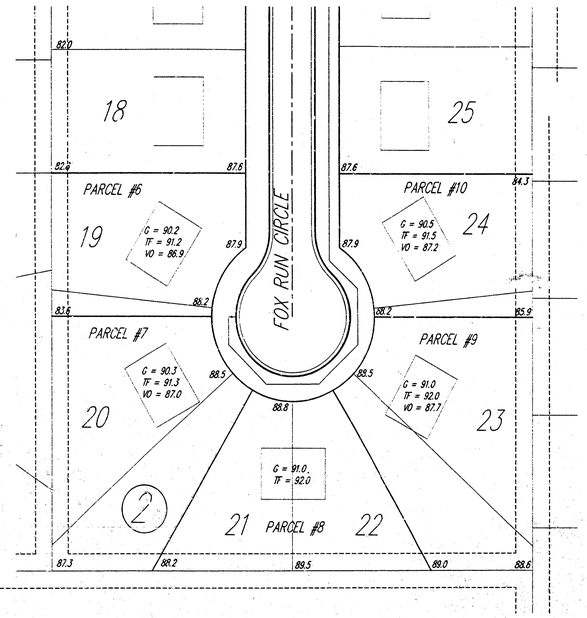


APPROVED
DRAINAGE PLAN

BRENTWOOD VILLAGE

REVISED LOT GRADING PLAN
PART OF BLOCK 2 - BRENTWOOD VILLAGE ADDITION

SRB

SAVOY, RUGGLES & BOHM, P.A.
ENGINEERING & SURVEYING

REVISED, 1 OCT 6 NOV 2000

ENTERED FROM THE DATE AVAILABLE