
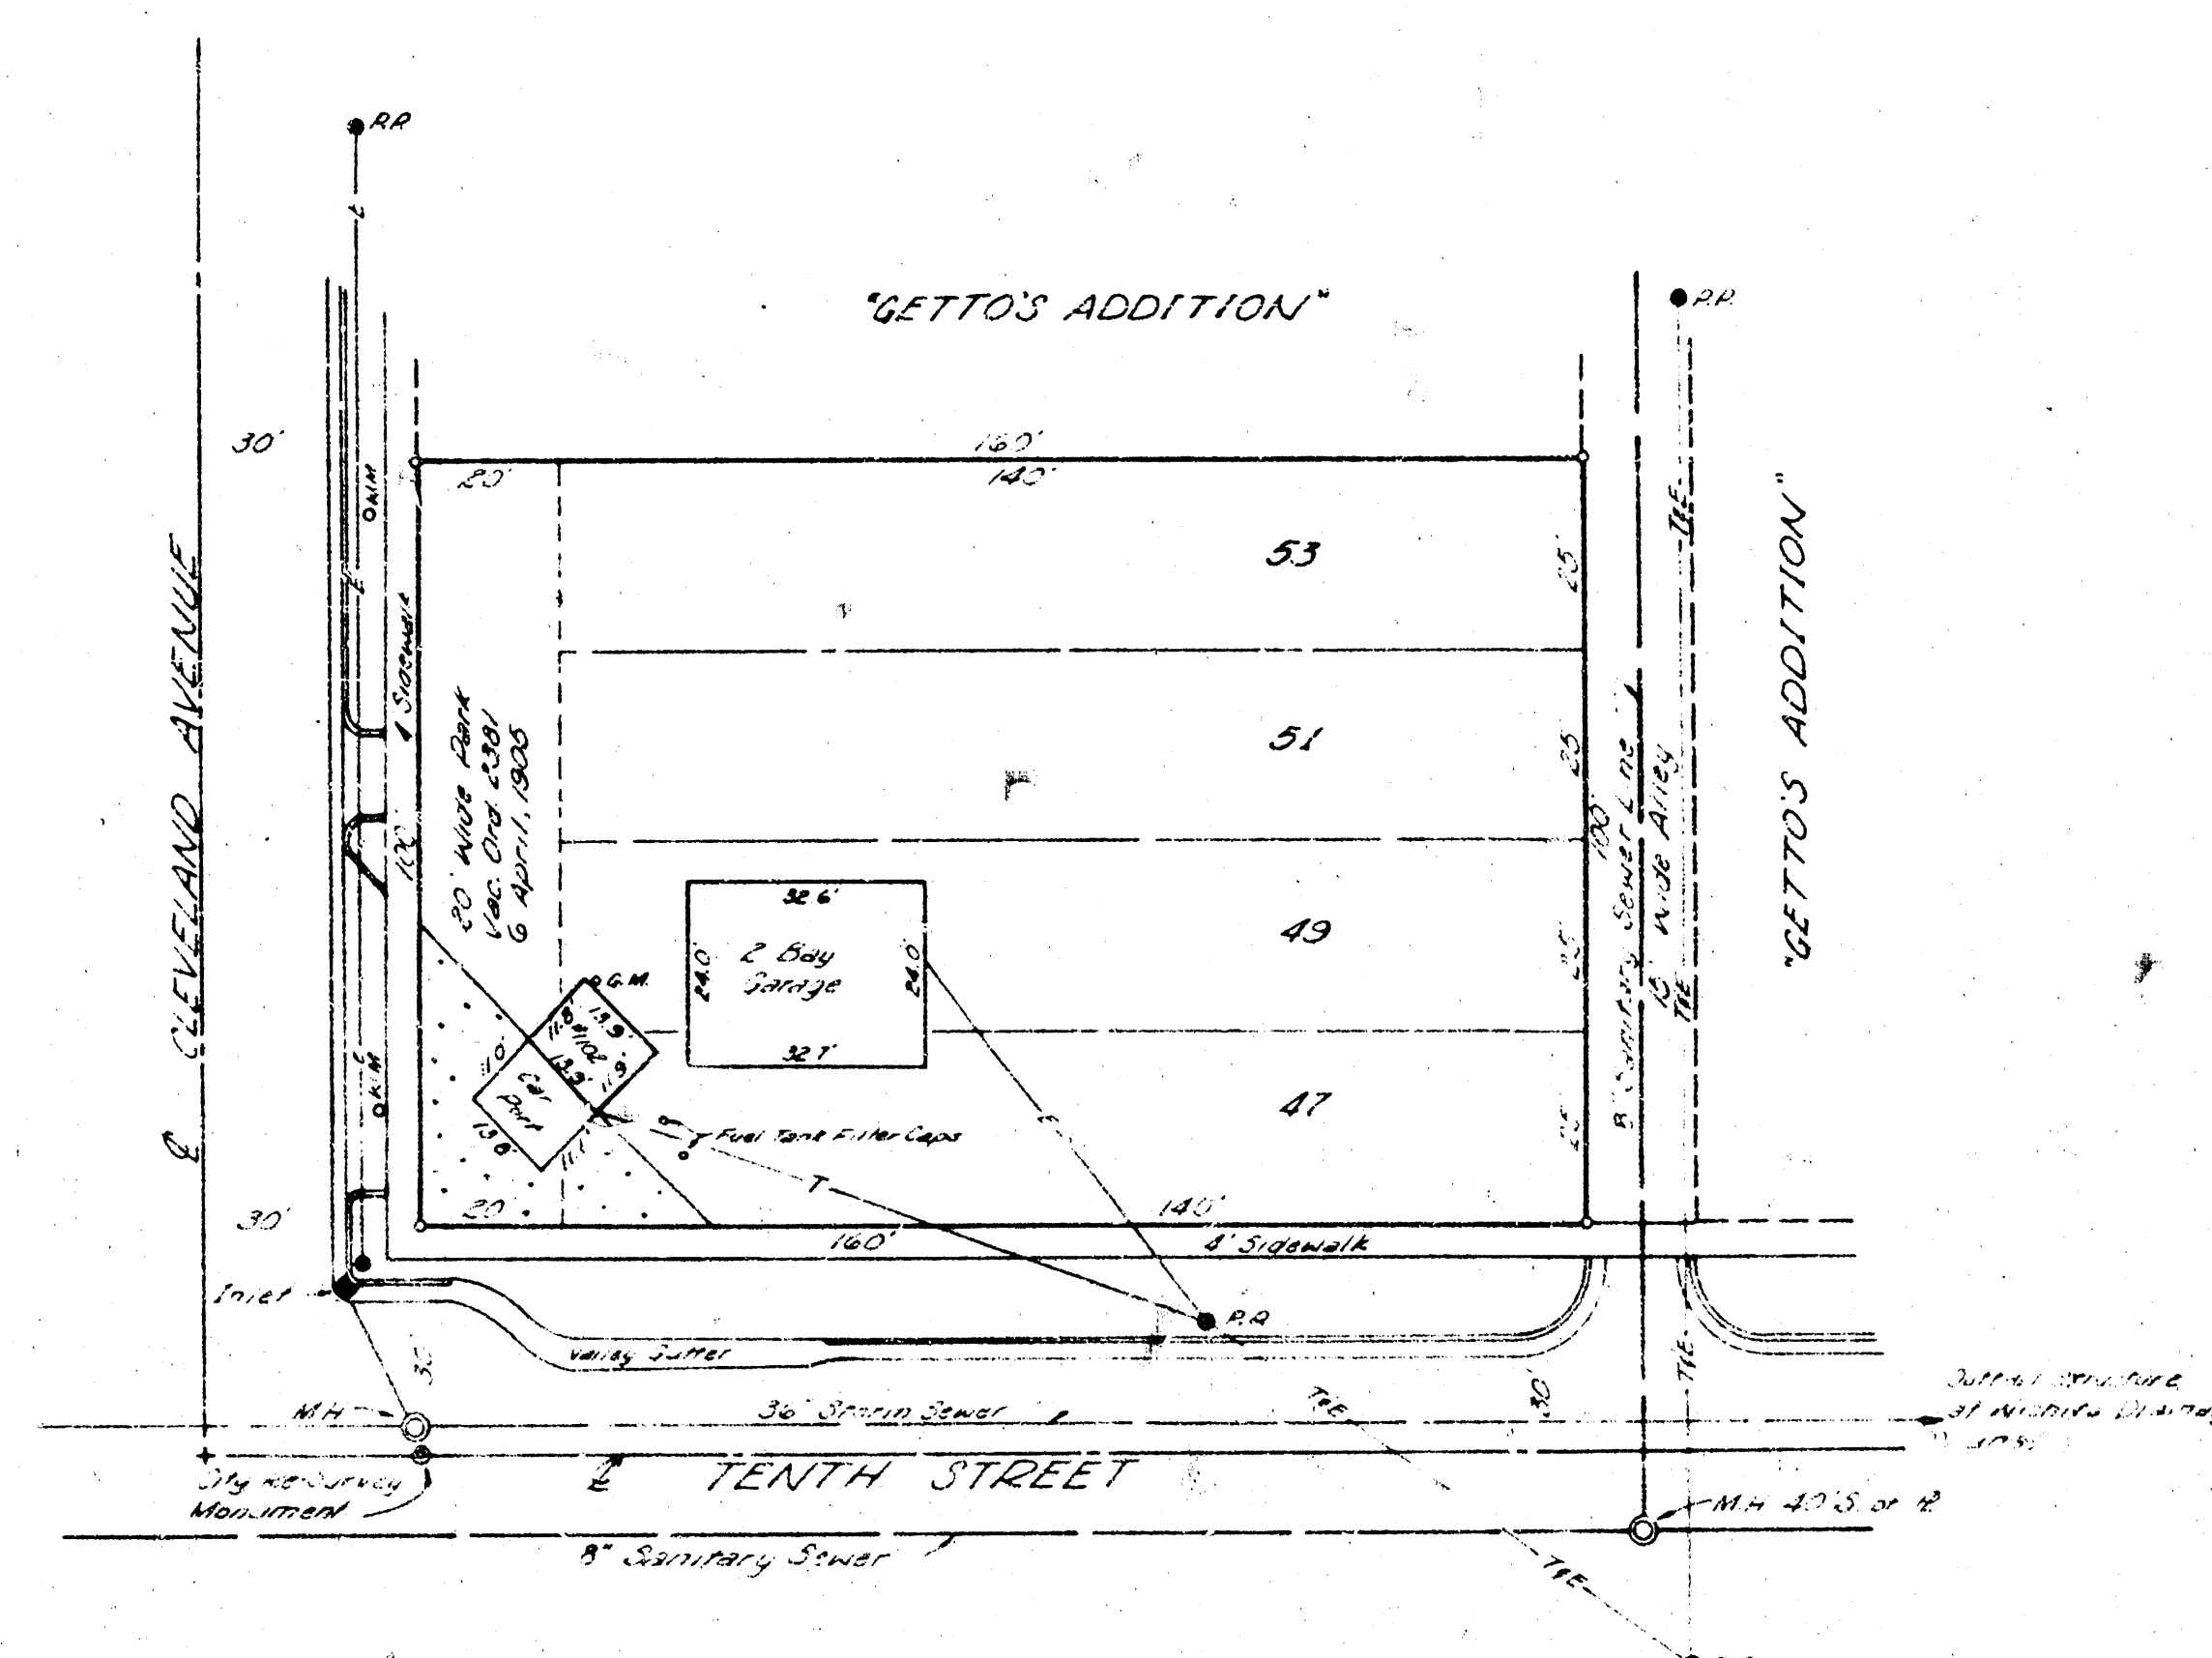


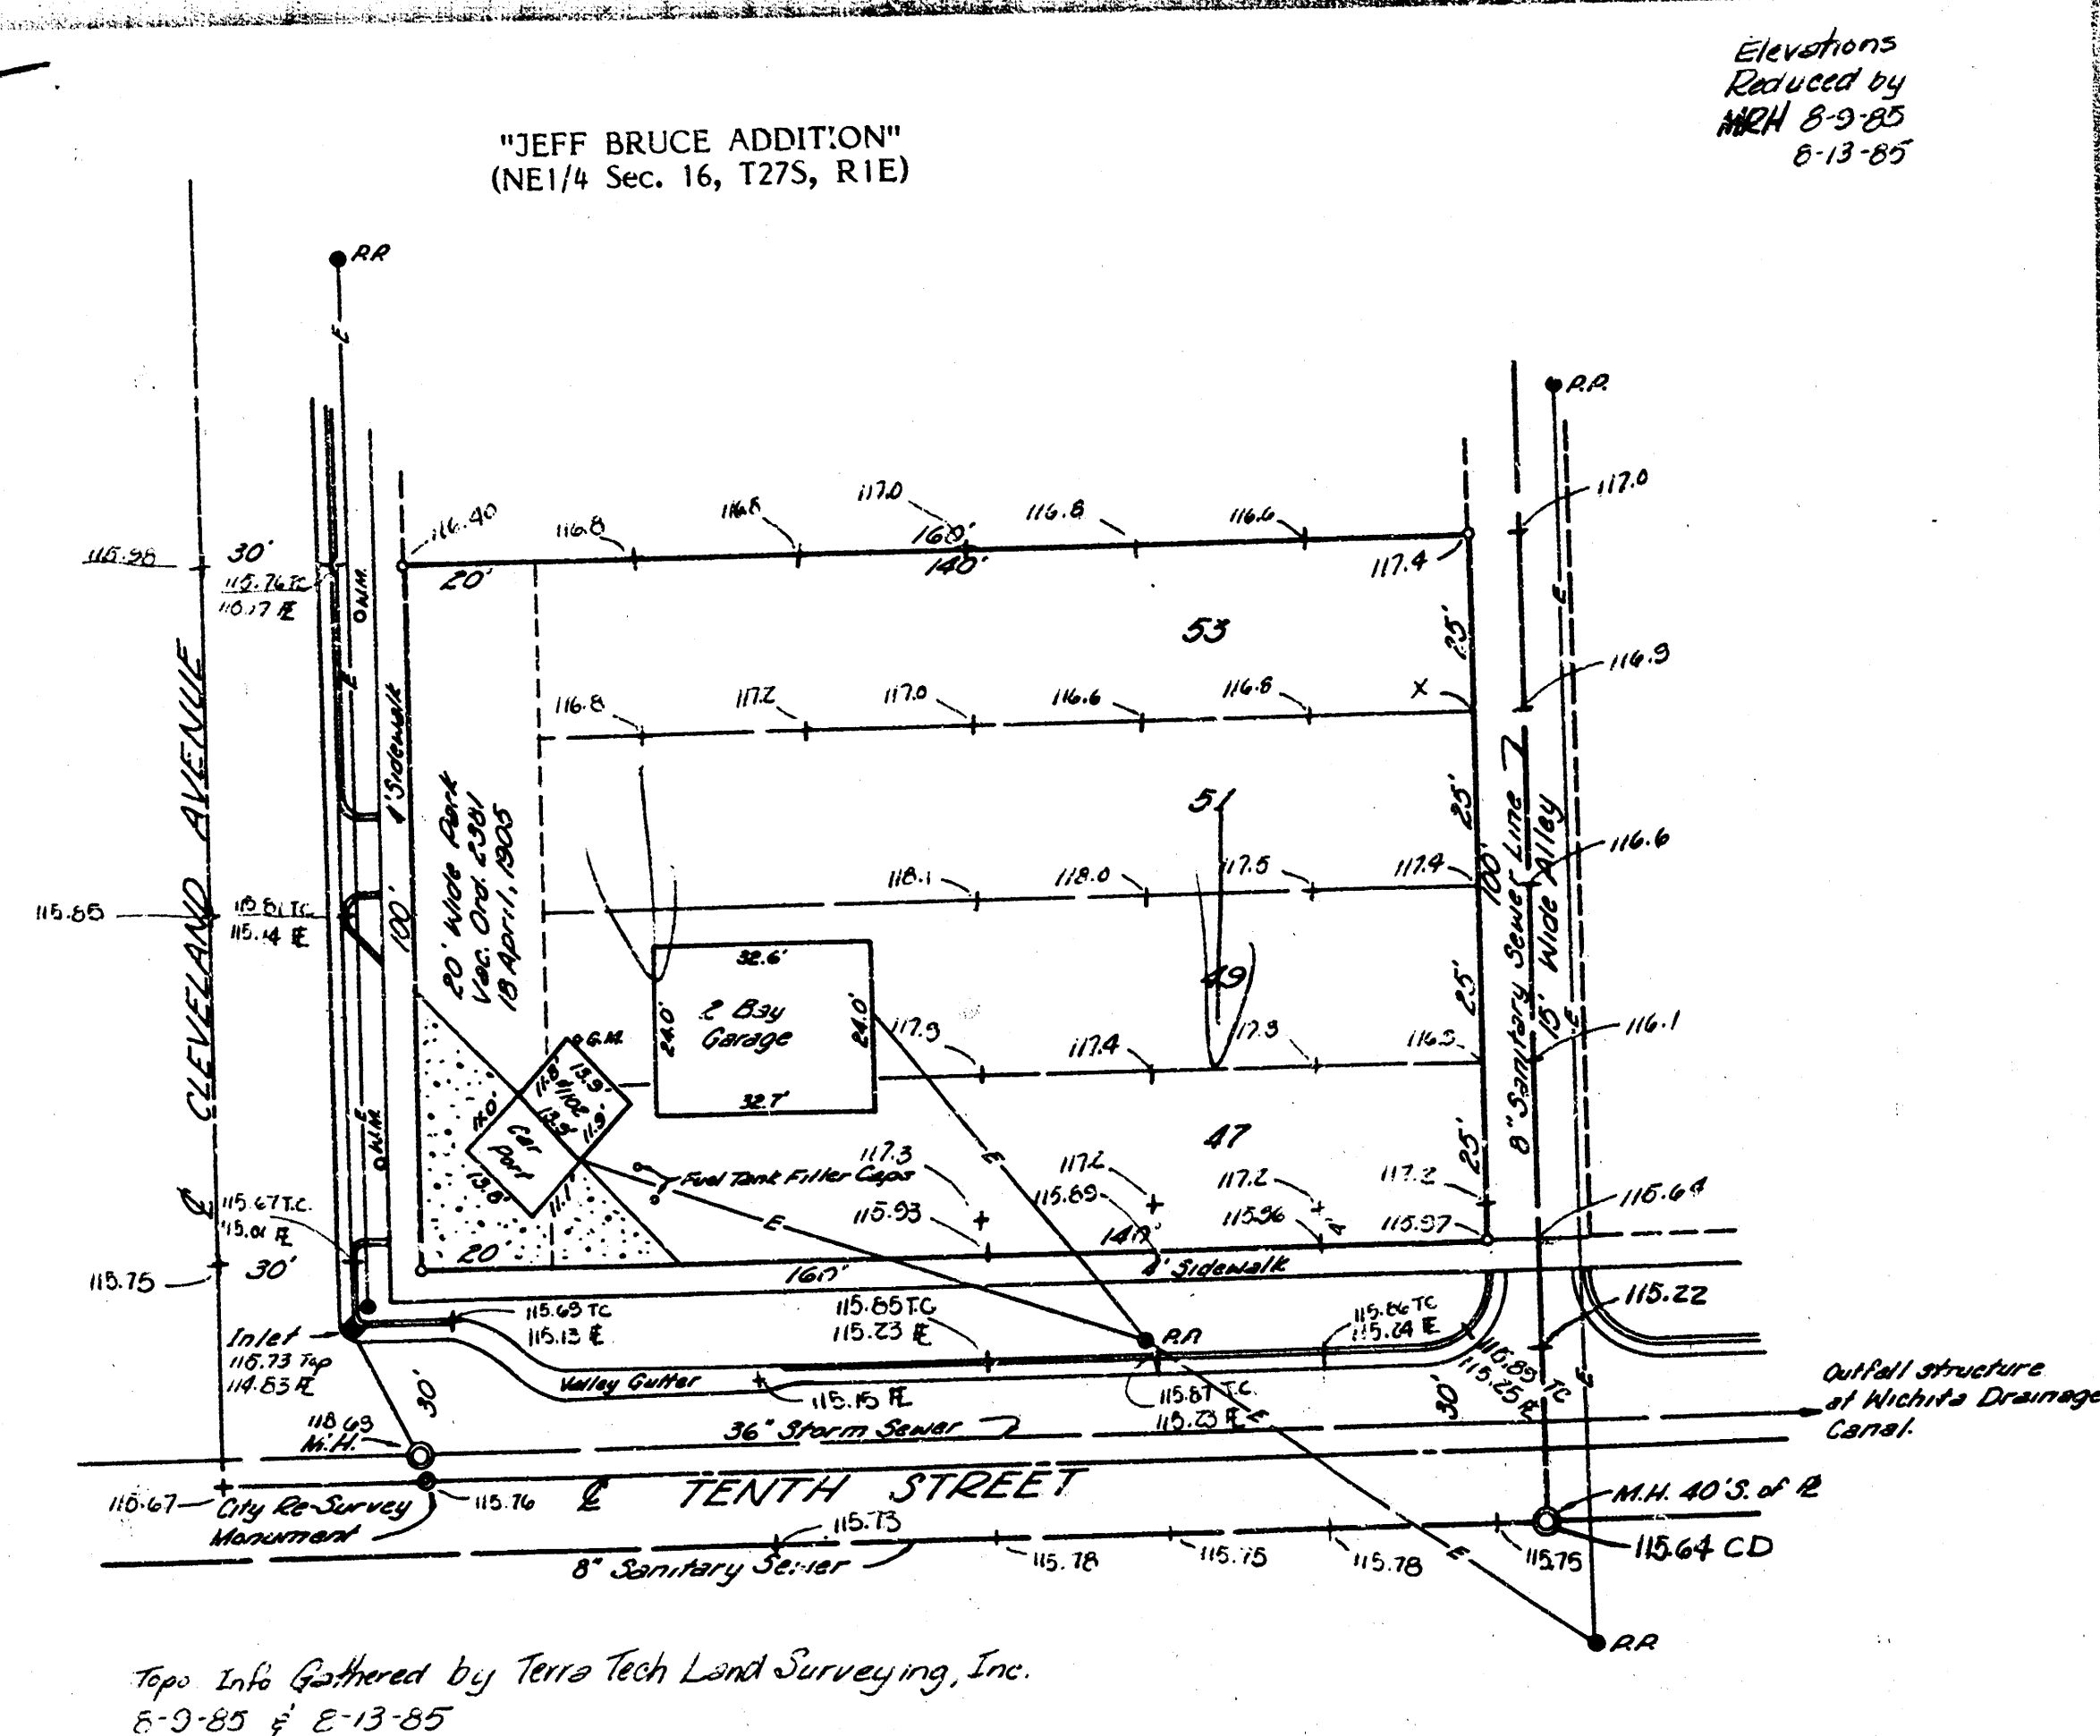

TERRA TECH
LAND SURVEYING, INC.

245 West Dewey
Wichita, Kansas 67202-3607
(316) 267-0744 / 267-2348

PRELIMINARY
FOR INFORMATION ONLY

SHD AUG 13 1985

FILMED FROM THE BEST
AVAILABLE COPY.....