


**FILMED FROM THE BEST
AVAILABLE COPY**

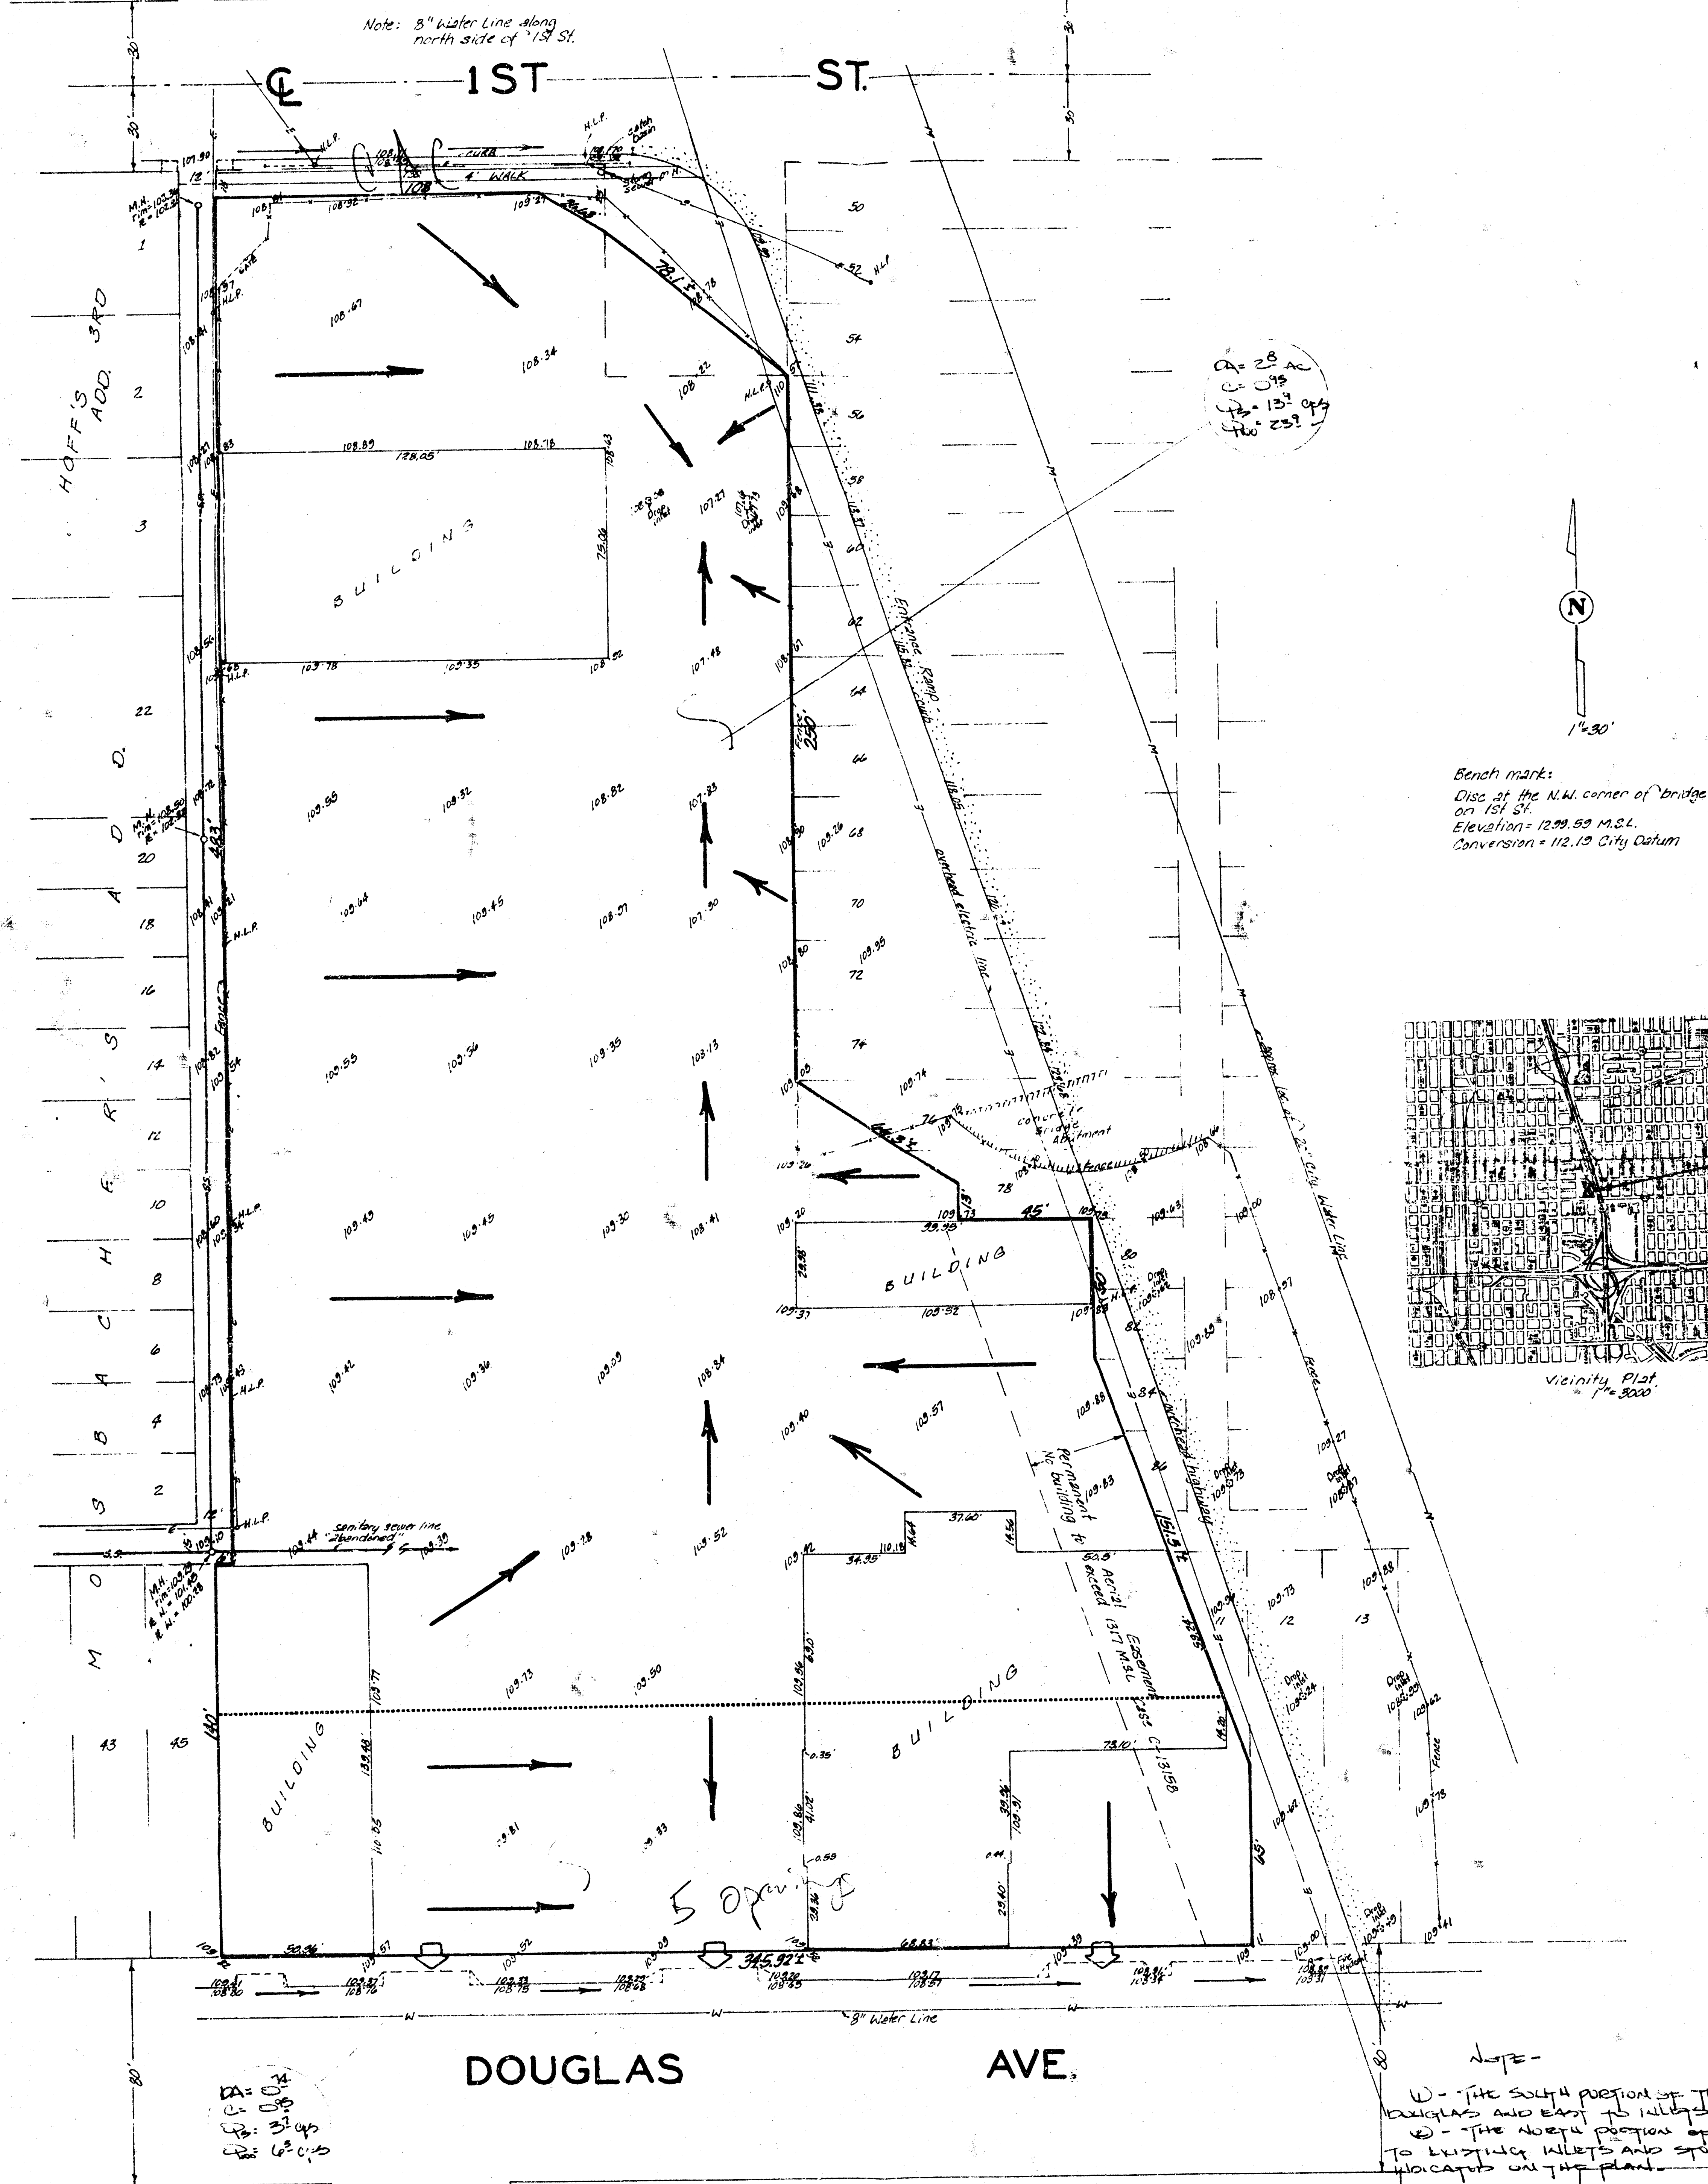

PRELIMINARY PLAT
BULGER ADDITION

A REPLAT OF LOTS 1-2-3-4-5, BLOCK 4, & LOTS 6-7-8-9 & PART OF LOT 10 11, BLOCK 5, & LOTS 49-51-53-55-57-59-61-63-65-67-69-71-73-75-77-79-81-83-85, BLOCK 4, & PART OF LOTS 76-78-80-82-84-86, BLOCK 5, & VACATED MINNEAPOLIS AVE & ALLEYS ALL IN MINNEAPOLIS ADDITION TO WICHITA, SEDGWICK COUNTY, KANSAS.

OWNER: JOSEPH A. BULGER

FINAL DRAINAGE PLAN

ED BAUGHMAN COMPANY, P.A.
SURVEYING & ENGINEERING
316-262-7271 • 330 LAURA • WICHITA, KANSAS 67211

316-262-7271 • 330 LAURA • WICHITA, KANSAS 67211