
CARPENTERS LOCAL UNION NO. 201 ADDITION
(Drainage)

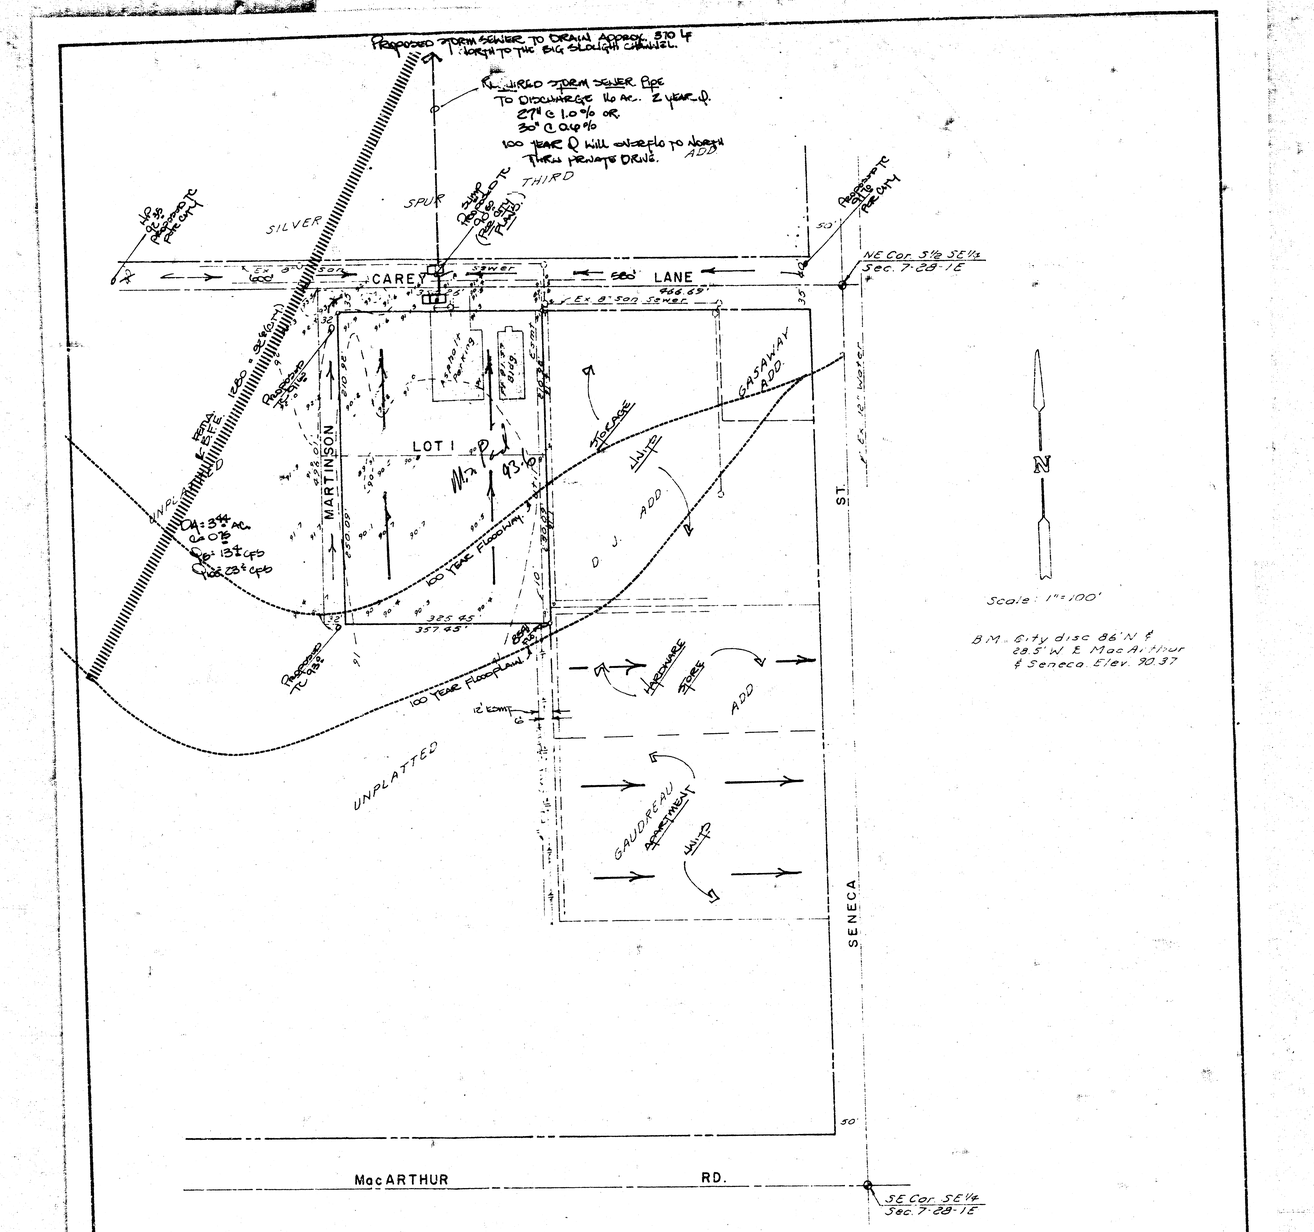

SKETCH PLAT

CARPENTERS LOCAL UNION NO. 201 ADDITION

PART OF SE1/4 OF SEC. 7-28-1E & A REPLAT OF LOT 1, REVIVAL ROAD BAPTIST CHURCH ADD.

DRAINAGE PLAN

Apr. 1, 1985

BAUGHMAN COMPANY, P.A.
SURVEYING & ENGINEERING

FILMED FROM THE BEST AVAILABLE COPY