CAT LAND ADDITION
(Drainage)

BAUGHMAN COMPANY, P.A.
SURVEYING & ENGINEERING
316/262-7271 • 330 LAURA • WICHITA, KANSAS 67211

PRELIMINARY MEMO

PROJECT CAT LAND ADDITION

JOB NO.

DATE 2-20-84

TO Chris Breitenstein

COPIES TO:

FROM N. Brent Wooten

REFERENCE Final drainage Plan


Final plat is scheduled for subdivision for March 1, 1984.

Runoff for the commercial lot will be 0.85. The lot will drain west or to the north to either Washington or Morris thru the driveways. Existing storm sewers at at the intersection and will drain Morris before any drainage discharges onto Washington.

O.K

PAGE __ OF ____

drainage plan

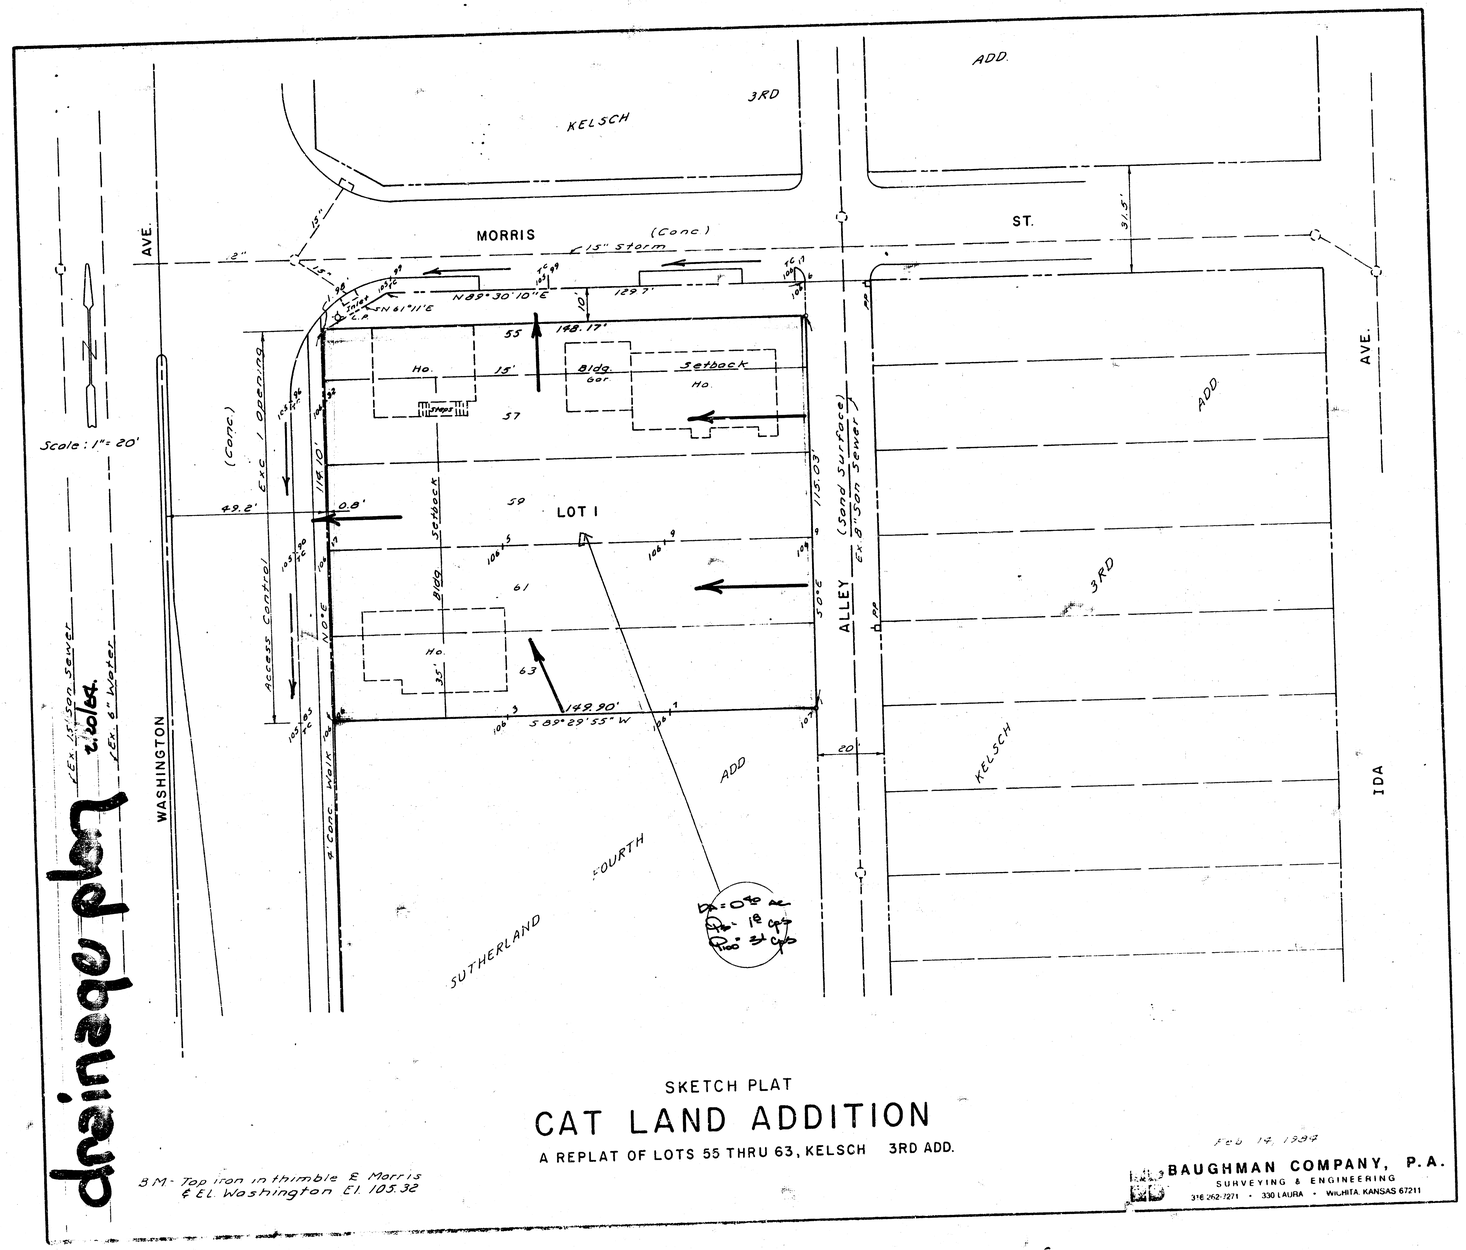

SKETCH PLAT

CAT LAND ADDITION

A REPLAT OF LOTS 55 THRU 63, KELSCH 3RD ADD.

Feb 14, 1984

BAUGHMAN COMPANY, P.A.
SURVEYING & ENGINEERING
316/262-7271 • 330 LAURA • WICHITA, KANSAS 67211

FILMED FROM THE BEST AVAILABLE COPY